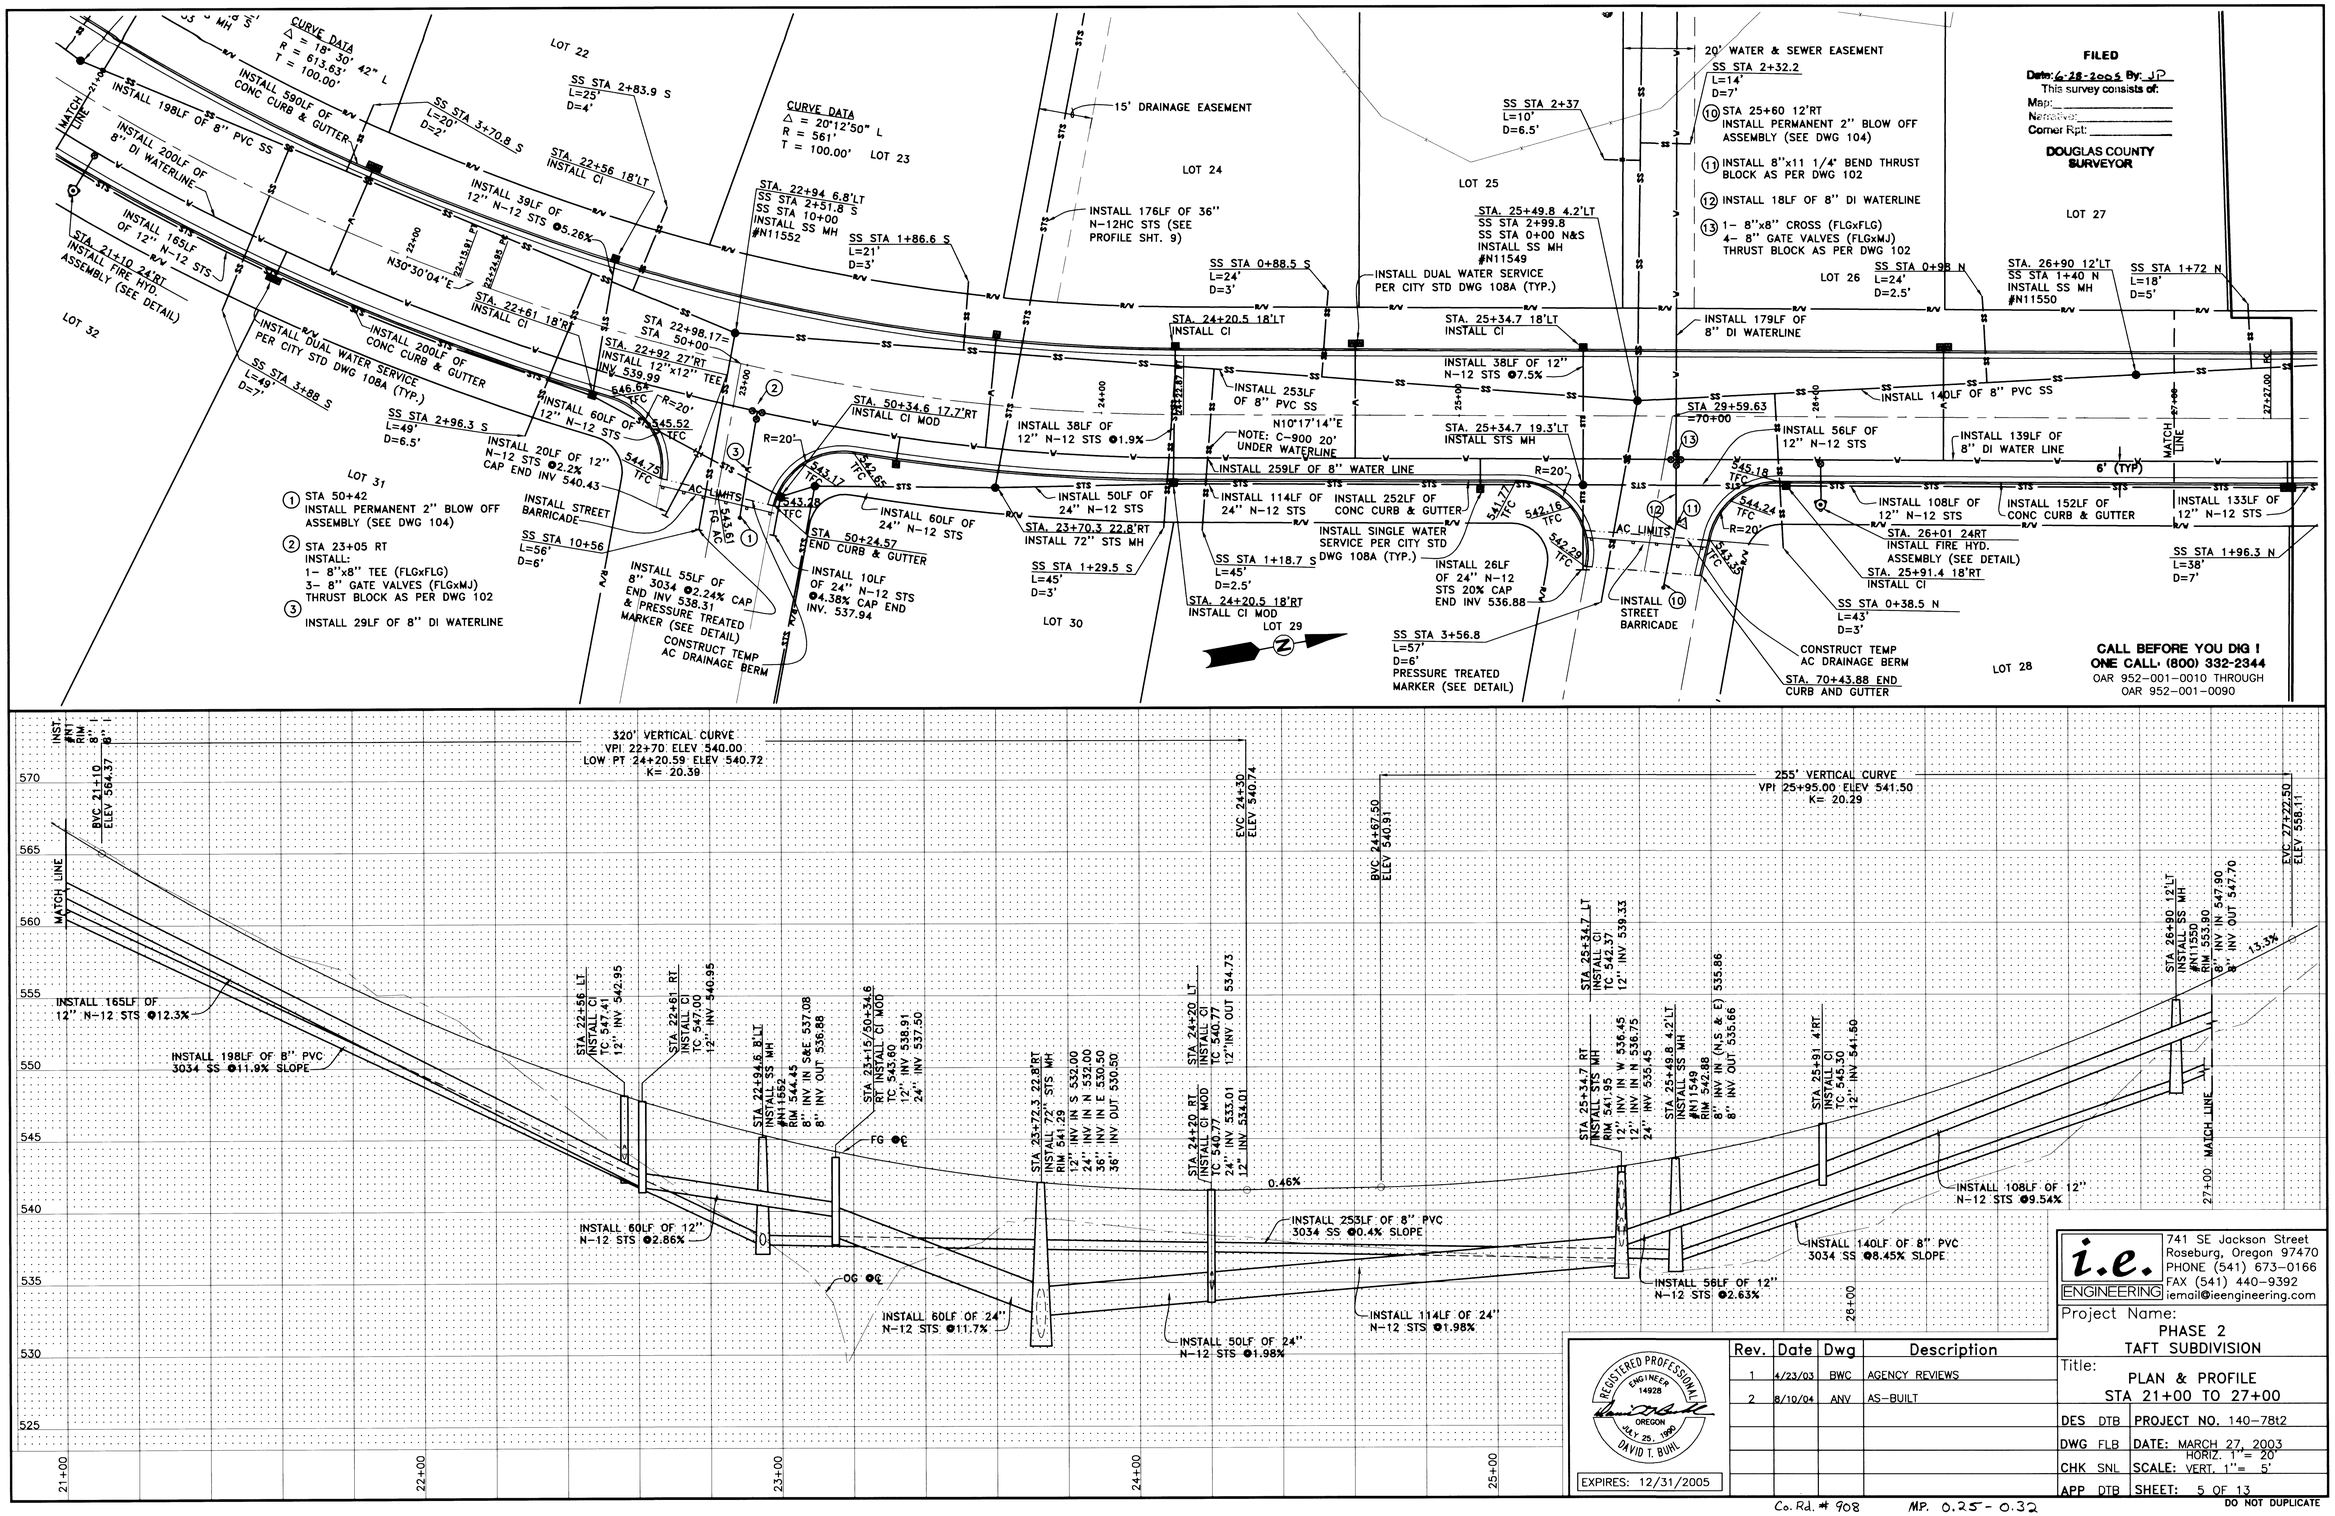

Rev.	Date	Dwg	Description
1	4/23/03	BWC	AGENCY REVIEWS
2	8/10/04	ANV	AS-BUILT

REGISTERED PROFESSIONAL ENGINEER 14928 OREGON JULY 25, 1995 DAVID T. BUHL

EXPIRES: 12/31/2005

i.e. ENGINEERING
741 SE Jackson Street
Roseburg, Oregon 97470
PHONE (541) 673-0166
FAX (541) 440-9392
iemail@ieengineering.com

Project Name: PHASE 2 TAFT SUBDIVISION

Title: PLAN & PROFILE STA 21+00 TO 27+00

DES DTB	PROJECT NO. 140-78t2
DWG FLB	DATE: MARCH 27, 2003
CHK SNL	SCALE: HORIZ. 1" = 20' VERT. 1" = 5'
APP DTB	SHEET: 5 OF 13

DO NOT DUPLICATE

Co. Rd. # 908 MP. 0.25 - 0.32

00250032

CO. RD. #908 PLAN & PROFILE