FILED
Date: 9/7/2006 By: JC
This survey consists of:
Map: 3/8
No:
Corner File:
DOUGLAS COUNTY SURVEYOR

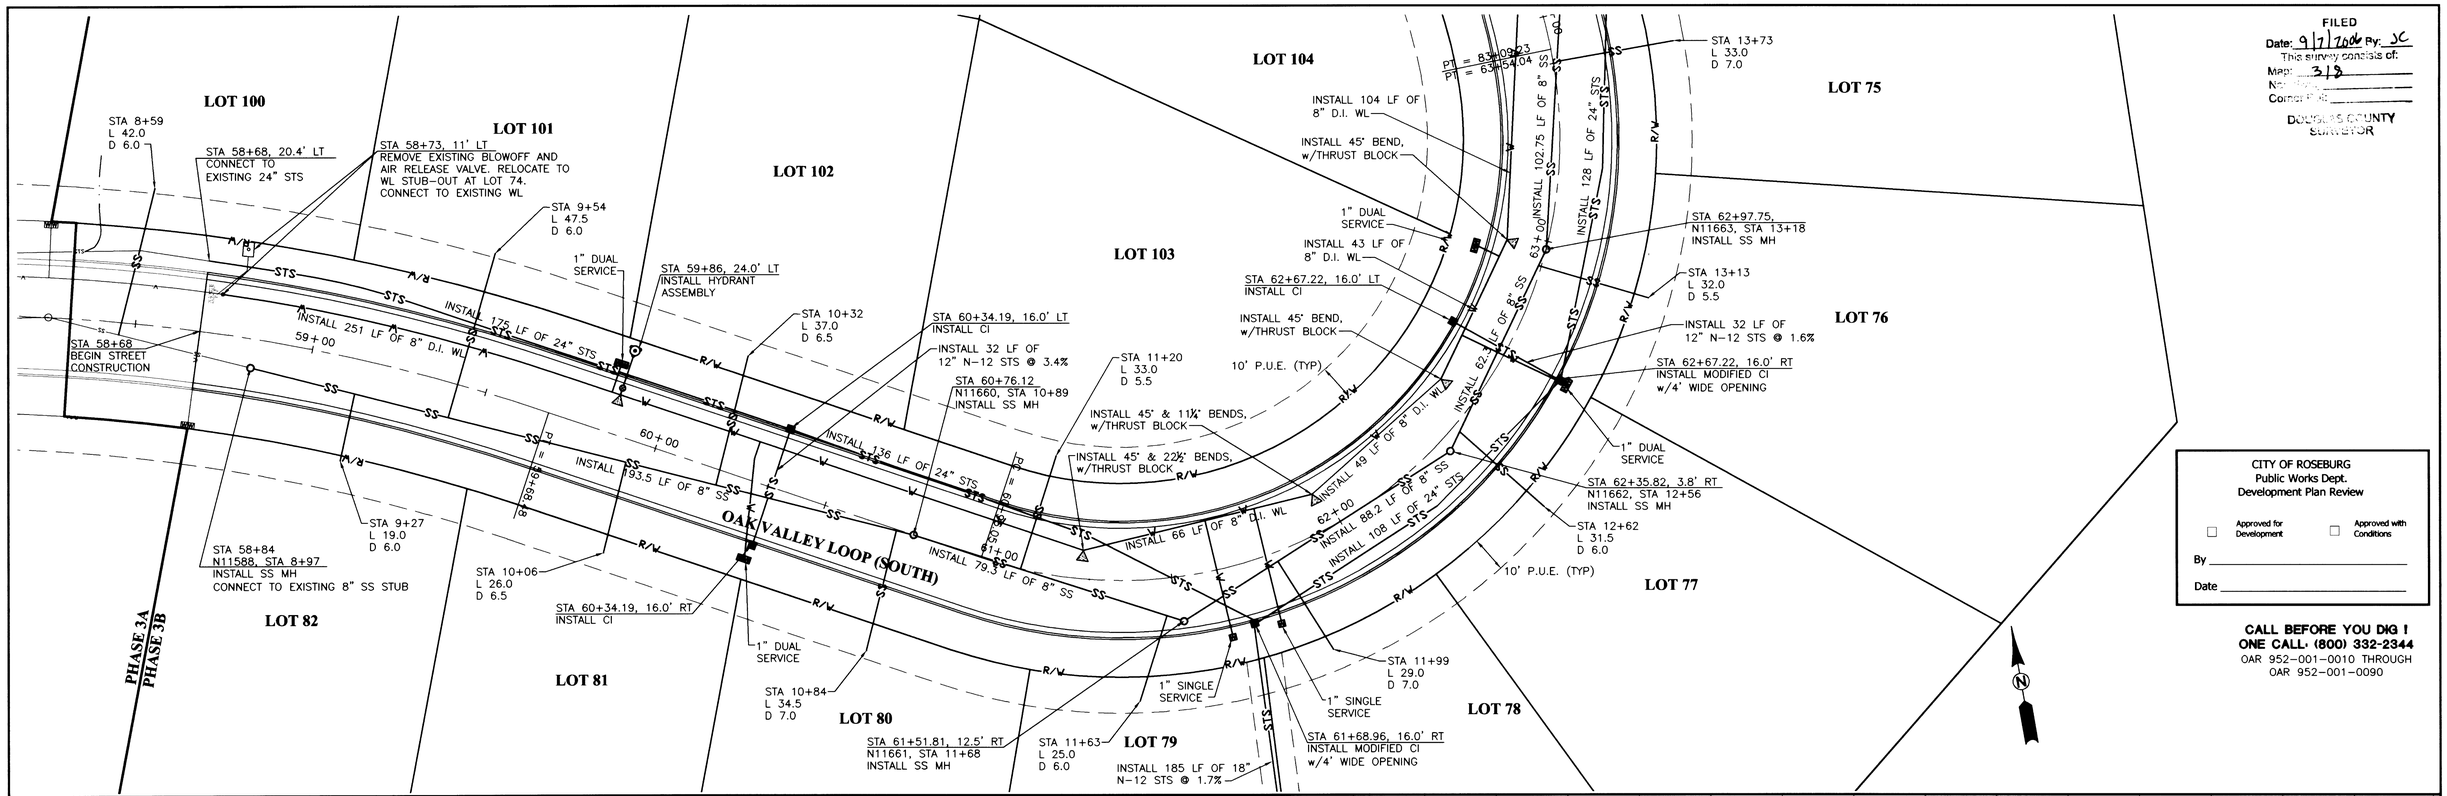

CITY OF ROSEBURG
Public Works Dept.
Development Plan Review

☐ Approved for Development ☐ Approved with Conditions

By _____

Date _____

CALL BEFORE YOU DIG !
ONE CALL: (800) 332-2344
OAR 952-001-0010 THROUGH
OAR 952-001-0090

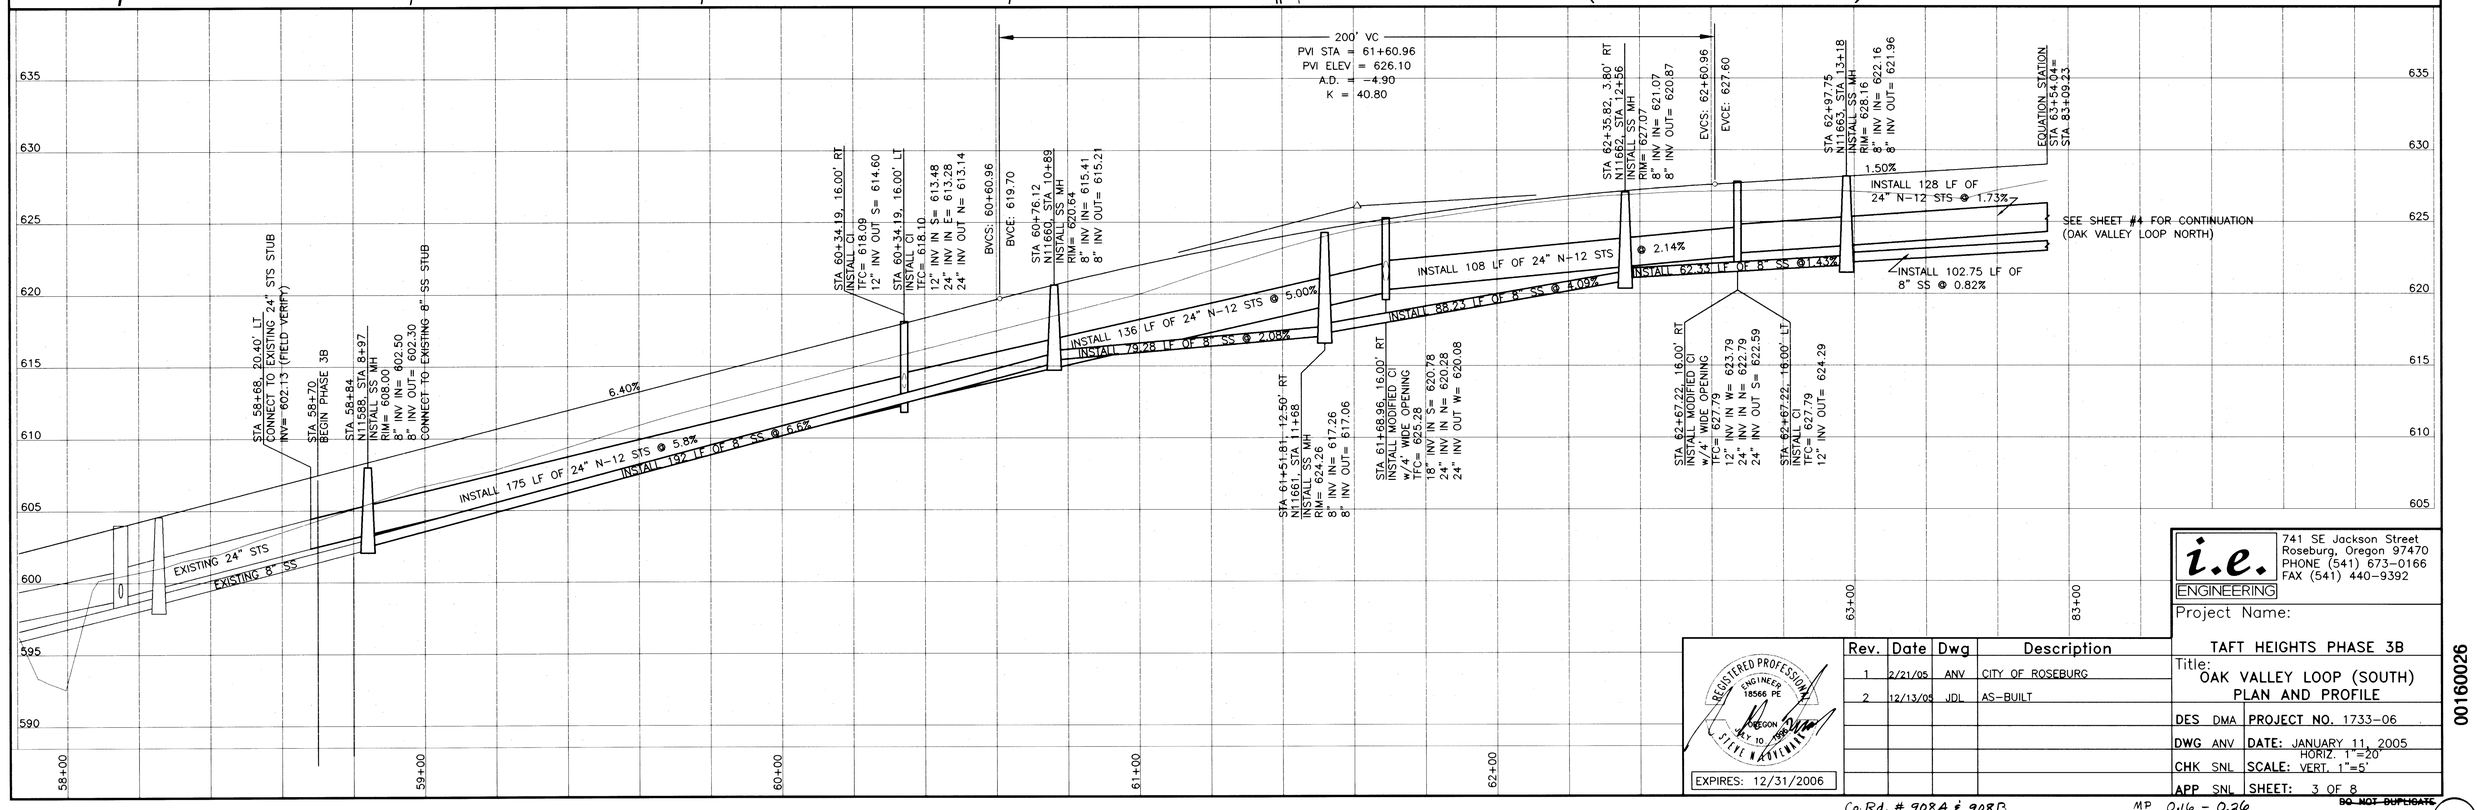

REGISTERED PROFESSIONAL ENGINEER 18566 PE OREGON JULY 10, 1998 STEVE NAGENDRAN
EXPIRES: 12/31/2006

Rev.	Date	Dwg	Description
1	2/21/05	ANV	CITY OF ROSEBURG
2	12/13/05	JDL	AS-BUILT

i.e. ENGINEERING
741 SE Jackson Street
Roseburg, Oregon 97470
PHONE (541) 673-0166
FAX (541) 440-9392

Project Name:
TAFT HEIGHTS PHASE 3B

Title:
OAK VALLEY LOOP (SOUTH)
PLAN AND PROFILE

DES DMA | PROJECT NO. 1733-06
DWG ANV | DATE: JANUARY 11, 2005
CHK SNL | SCALE: HORIZ. 1"=20' VERT. 1"=5'
APP SNL | SHEET: 3 OF 8

~~DO NOT DUPLICATE~~

00160026

Co. Rd. # 908A & 908B MP 0.16 - 0.26

CO RD #908A & 908B

83