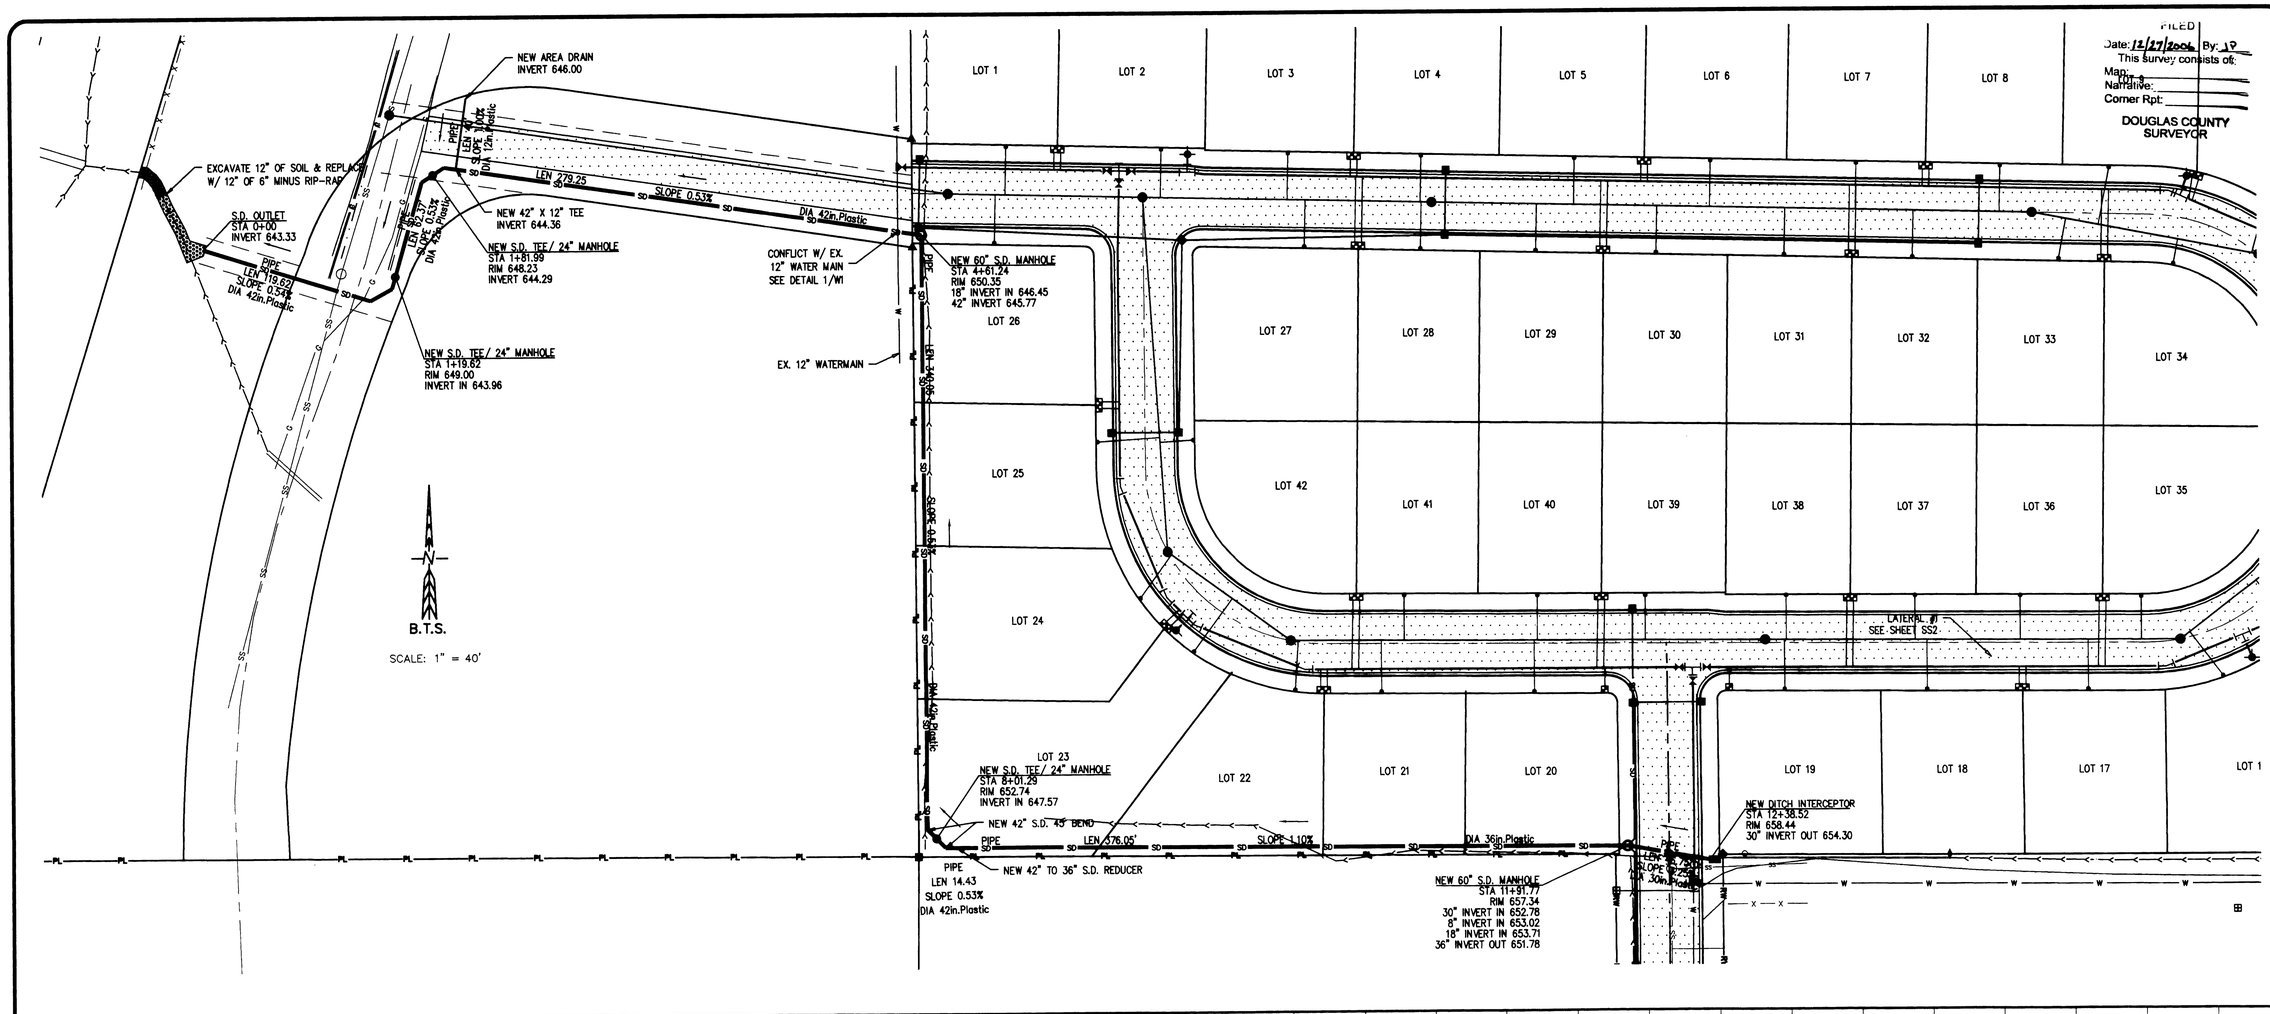

AS-BUILT PLANS - 3/8/06

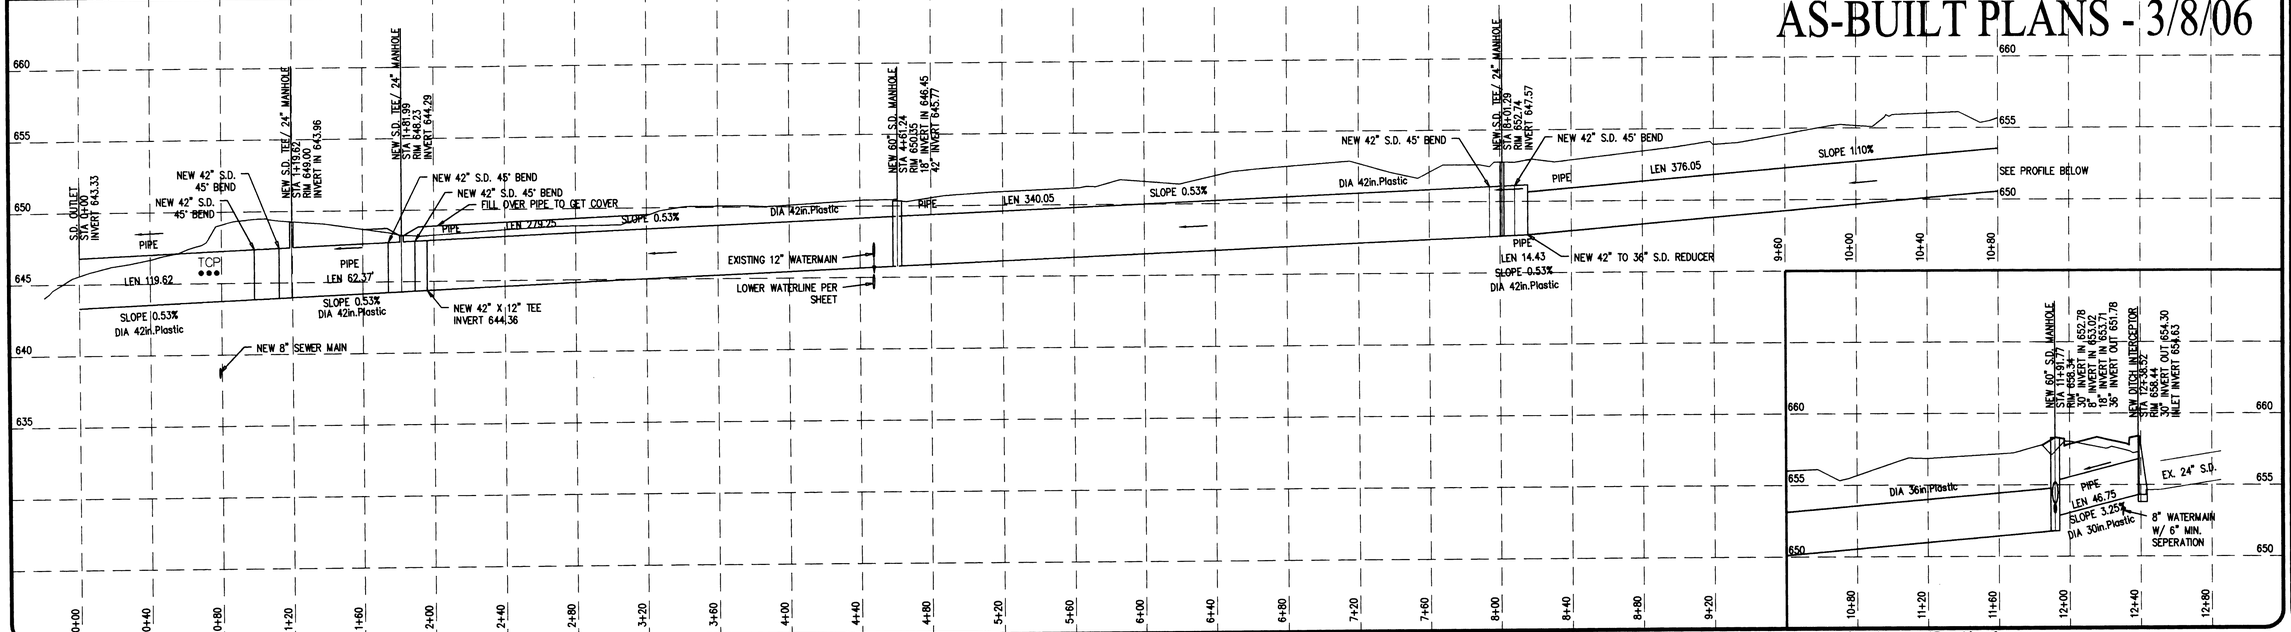

C.Rd. # 911A MP 0.00 - 0.05

CO. RD. #911A STORM DRAIN PLAN & PROFILE

OWNER:

STULL ENTERPRISES

BTS ENGINEERING & SURVEYING, INC.
431 S.E. MAIN ST., ROSEBURG, OR 97470
PHONE: (541) 673-5666 FAX: (541) 673-0105

PROJECT:

GENTRY ESTATES

SHEET TITLE:

STORM DRAIN MAINLINE PLAN & PROFILE

DATE: AUGUST 10, 2005
REV. #1: SEPT. 1, 2005
REV. #2: -
REV. #3: -
REV. #4: -
REV. #5: -

REGISTERED PROFESSIONAL ENGINEER 53297 OREGON JULY 9, 2003 DEREK M. MILLER
EXPIRATION DATE: 12/31/06

PROJ. #05-036

SHEET NO.

SD1 of 2

A0000005

8 of 12