PROPERTY LINE SURVEY OF WINCHESTER SCHOOL & AREA FOR SCHOOL DISTRICT NO. 4, DOUGLAS COUNTY, OREGON IN SEC. 25, T26S, R6W, W.M.

FILED
RECEIVED
APR 5 1963
COUNTY SURVEYOR
DOUGLAS COUNTY, ORE.

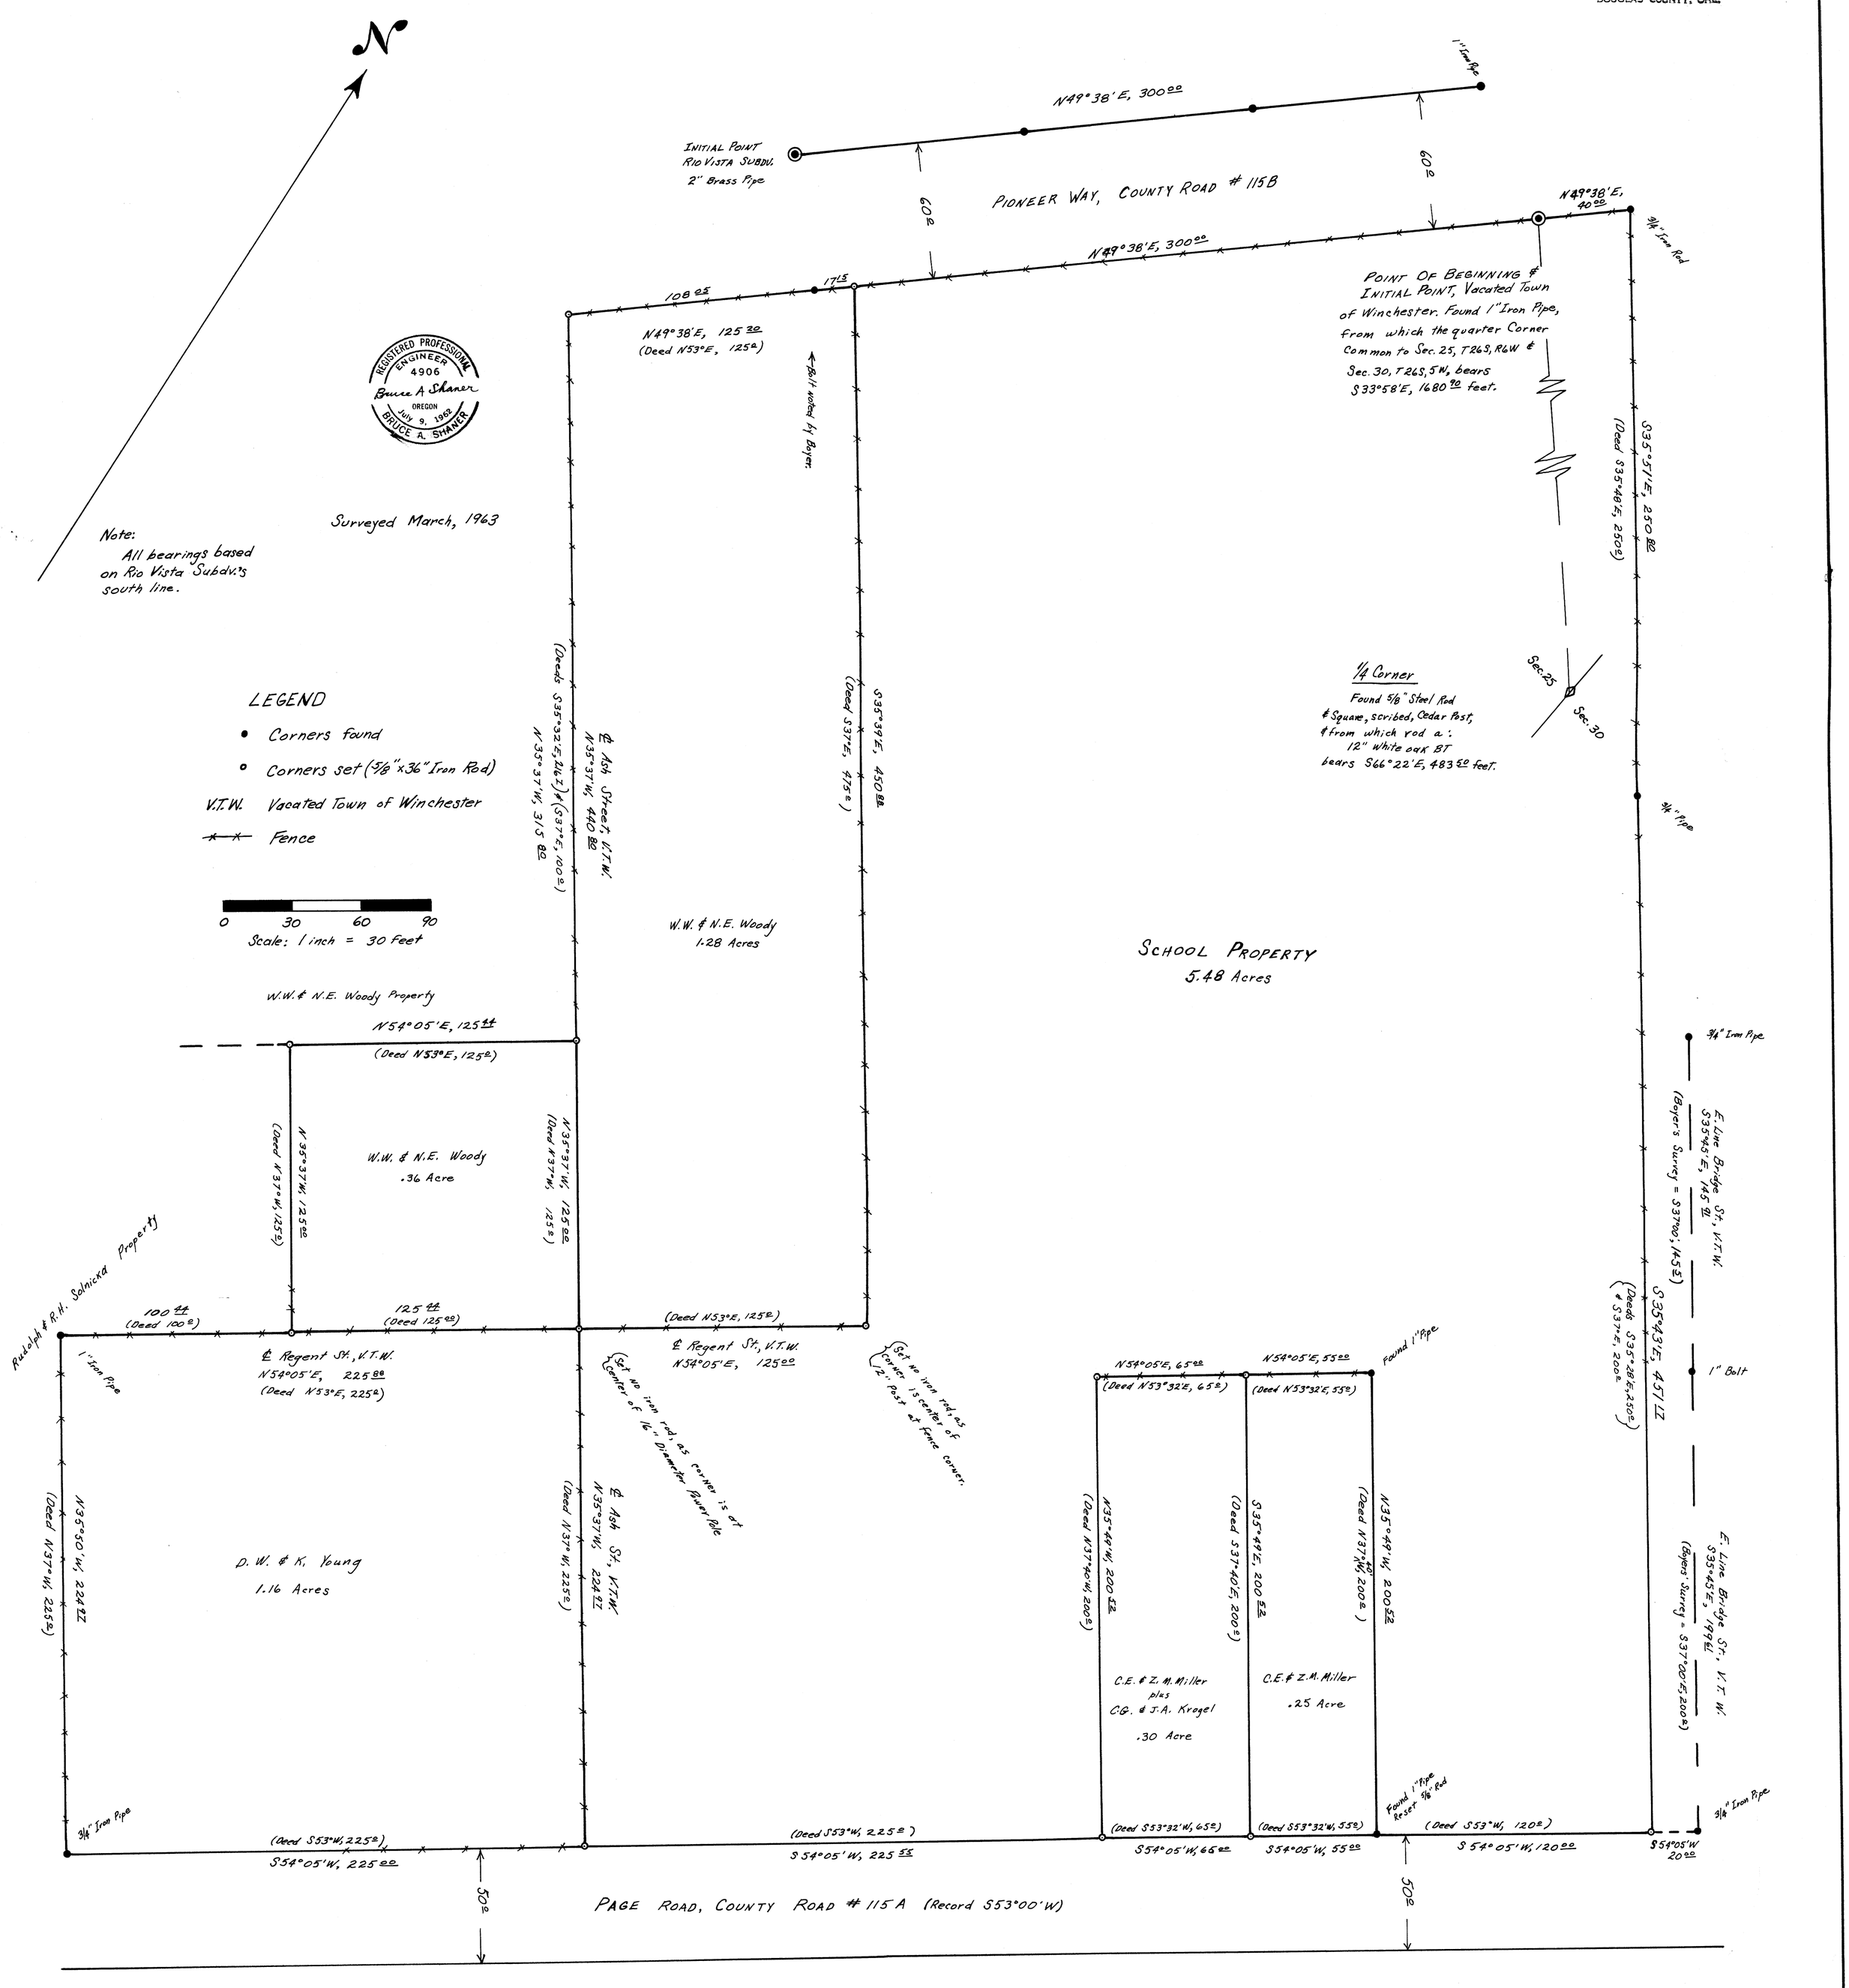

R.M. 1-35