COUNTY SURVEYOR'S OFFICE
DOUGLAS COUNTY, OREGON

DEPENDENT RESURVEY OF A PORTION OF SECTION 29, 30, 31 & 32, T 26 S., R. 5 W., SECTION 36, T. 26 S., R. 6 W., SECTION 1, T 27 S., R. 6 W. & SECTION 6, T 27 S., R. 5 W. W. M.

FRED M. DARBY — COUNTY SURVEYOR
SURVEYED 1964 — BY
MILO E. GODFREY - DEPUTY — SCALE 1" = 400'
SURVEYED FOR DOUGLAS COUNTY

Milo E. Godfrey

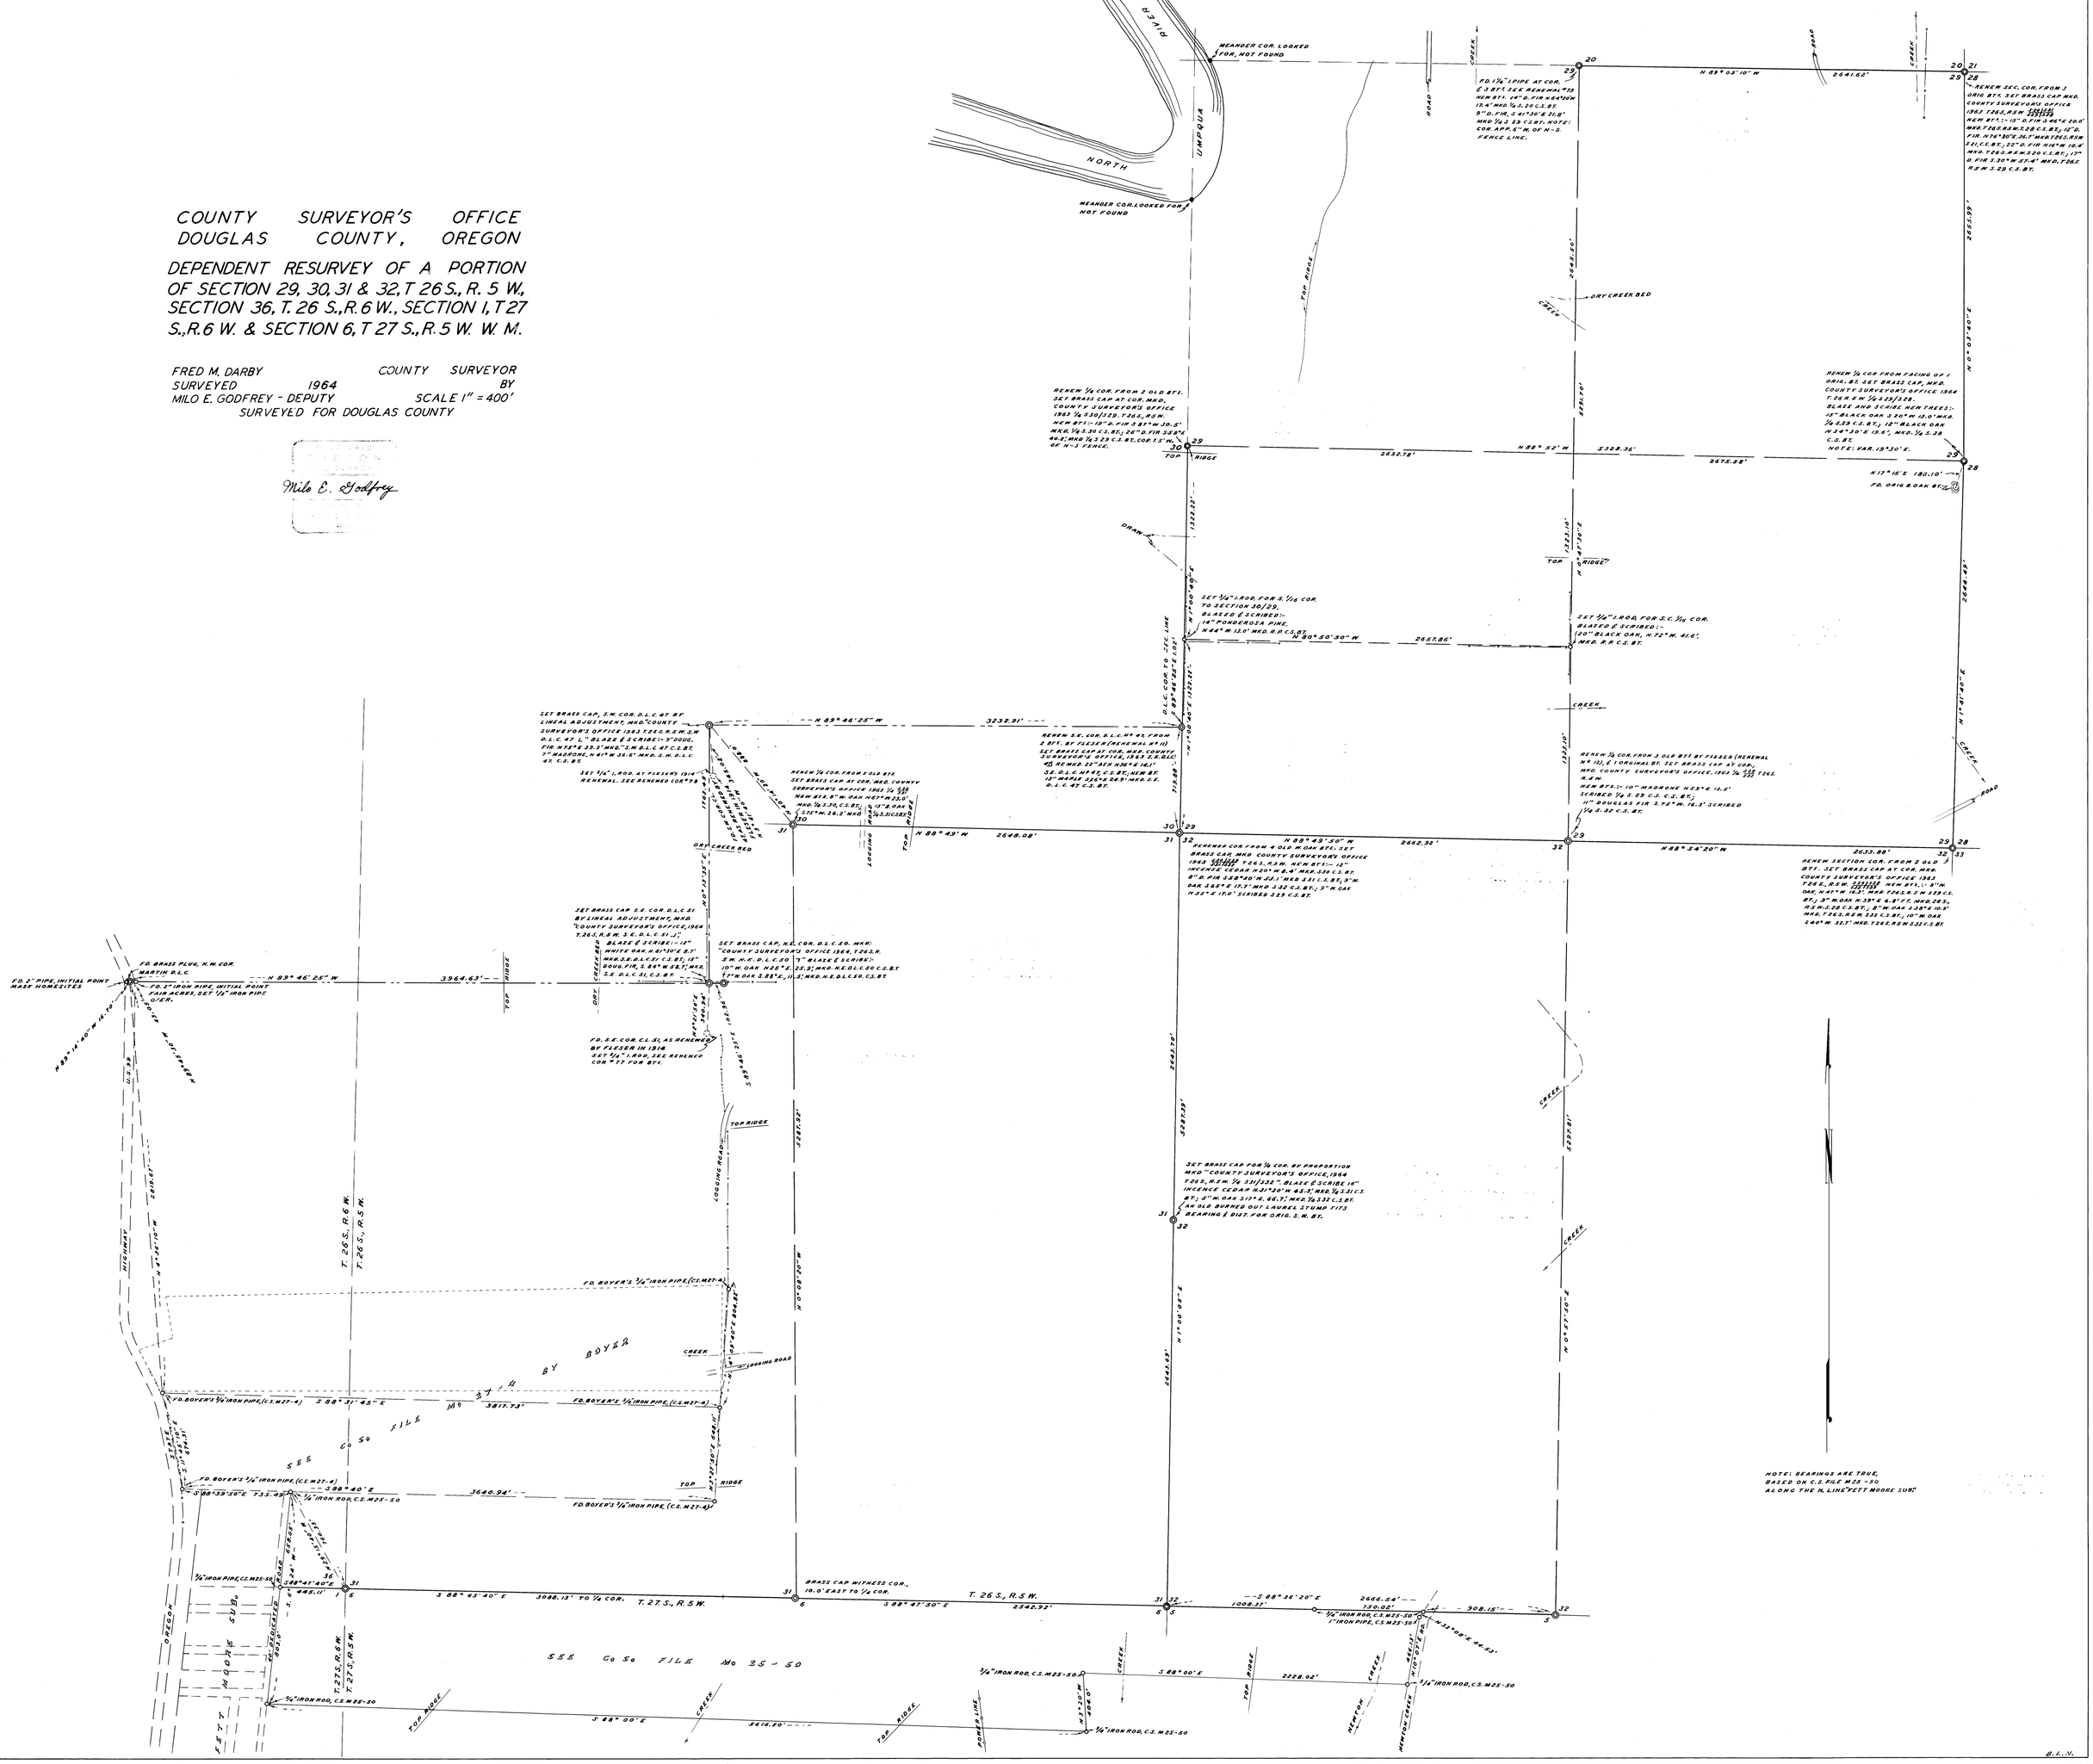

NOTE: BEARINGS ARE TRUE, BASED ON C.S. FILE M25-50 ALONG THE N. LINE FETT MOORE SUBD.

RM 1-42