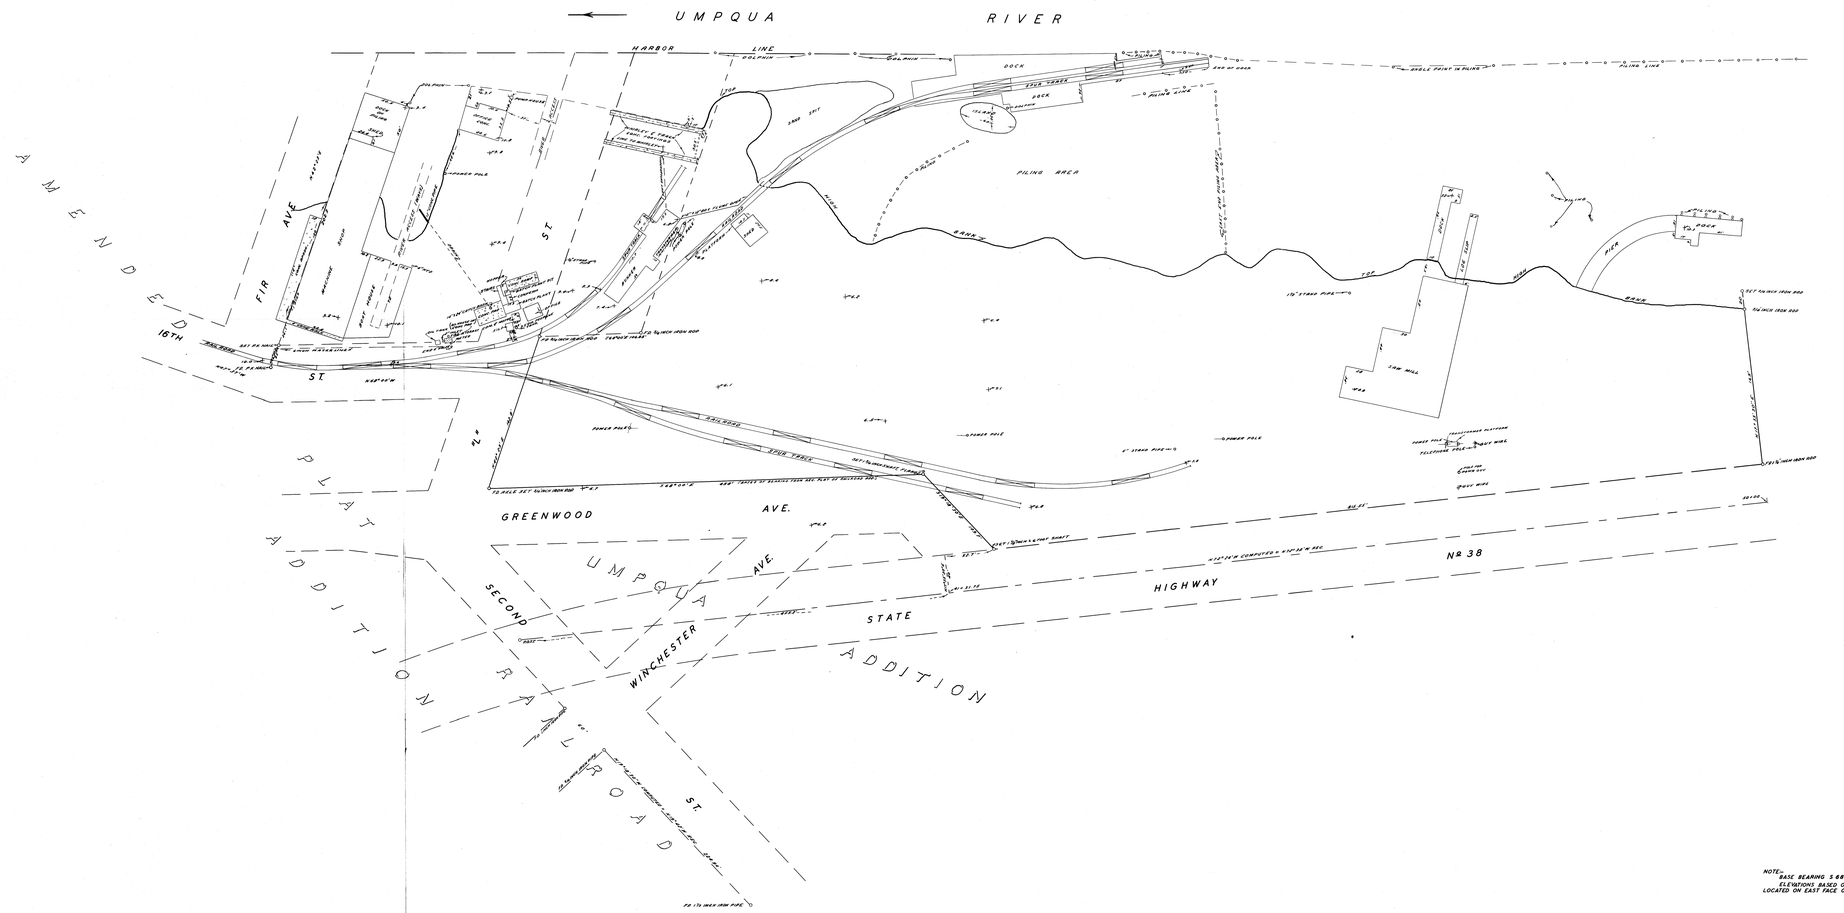

NOTE:
BASE BEARING S 68°00'E ALONG GREENWOOD AVE.
ELEVATIONS BASED ON STATE HIGHWAY B.M. OF 10.85' LOCATED ON EAST FACE OF REEDSPORT GARAGE.

COUNTY SURVEYOR'S OFFICE
DOUGLAS COUNTY, OREGON

SURVEY OF REEDSPORT HOLDINGS
REEDSPORT

BEN B. IRVING COUNTY SURVEYOR
SURVEYED JAN. 25, 1955 BY
JAMES W. BYRON - DEPUTY SCALE 1" = 40'
SURVEYED FOR O. H. HINSDALE

REGISTERED
OREGON
LAND SURVEYOR
JAMES W. BYRON
303

C.S. Plan 48/68
Km 1-5