JIM ROMINE PROPERTY IN SEC.S 17 & 20, T 26 S, R3W. W.M..

ENGINEER - W. S. BARNES

SCALE 1" = 100'

JAN. 1967

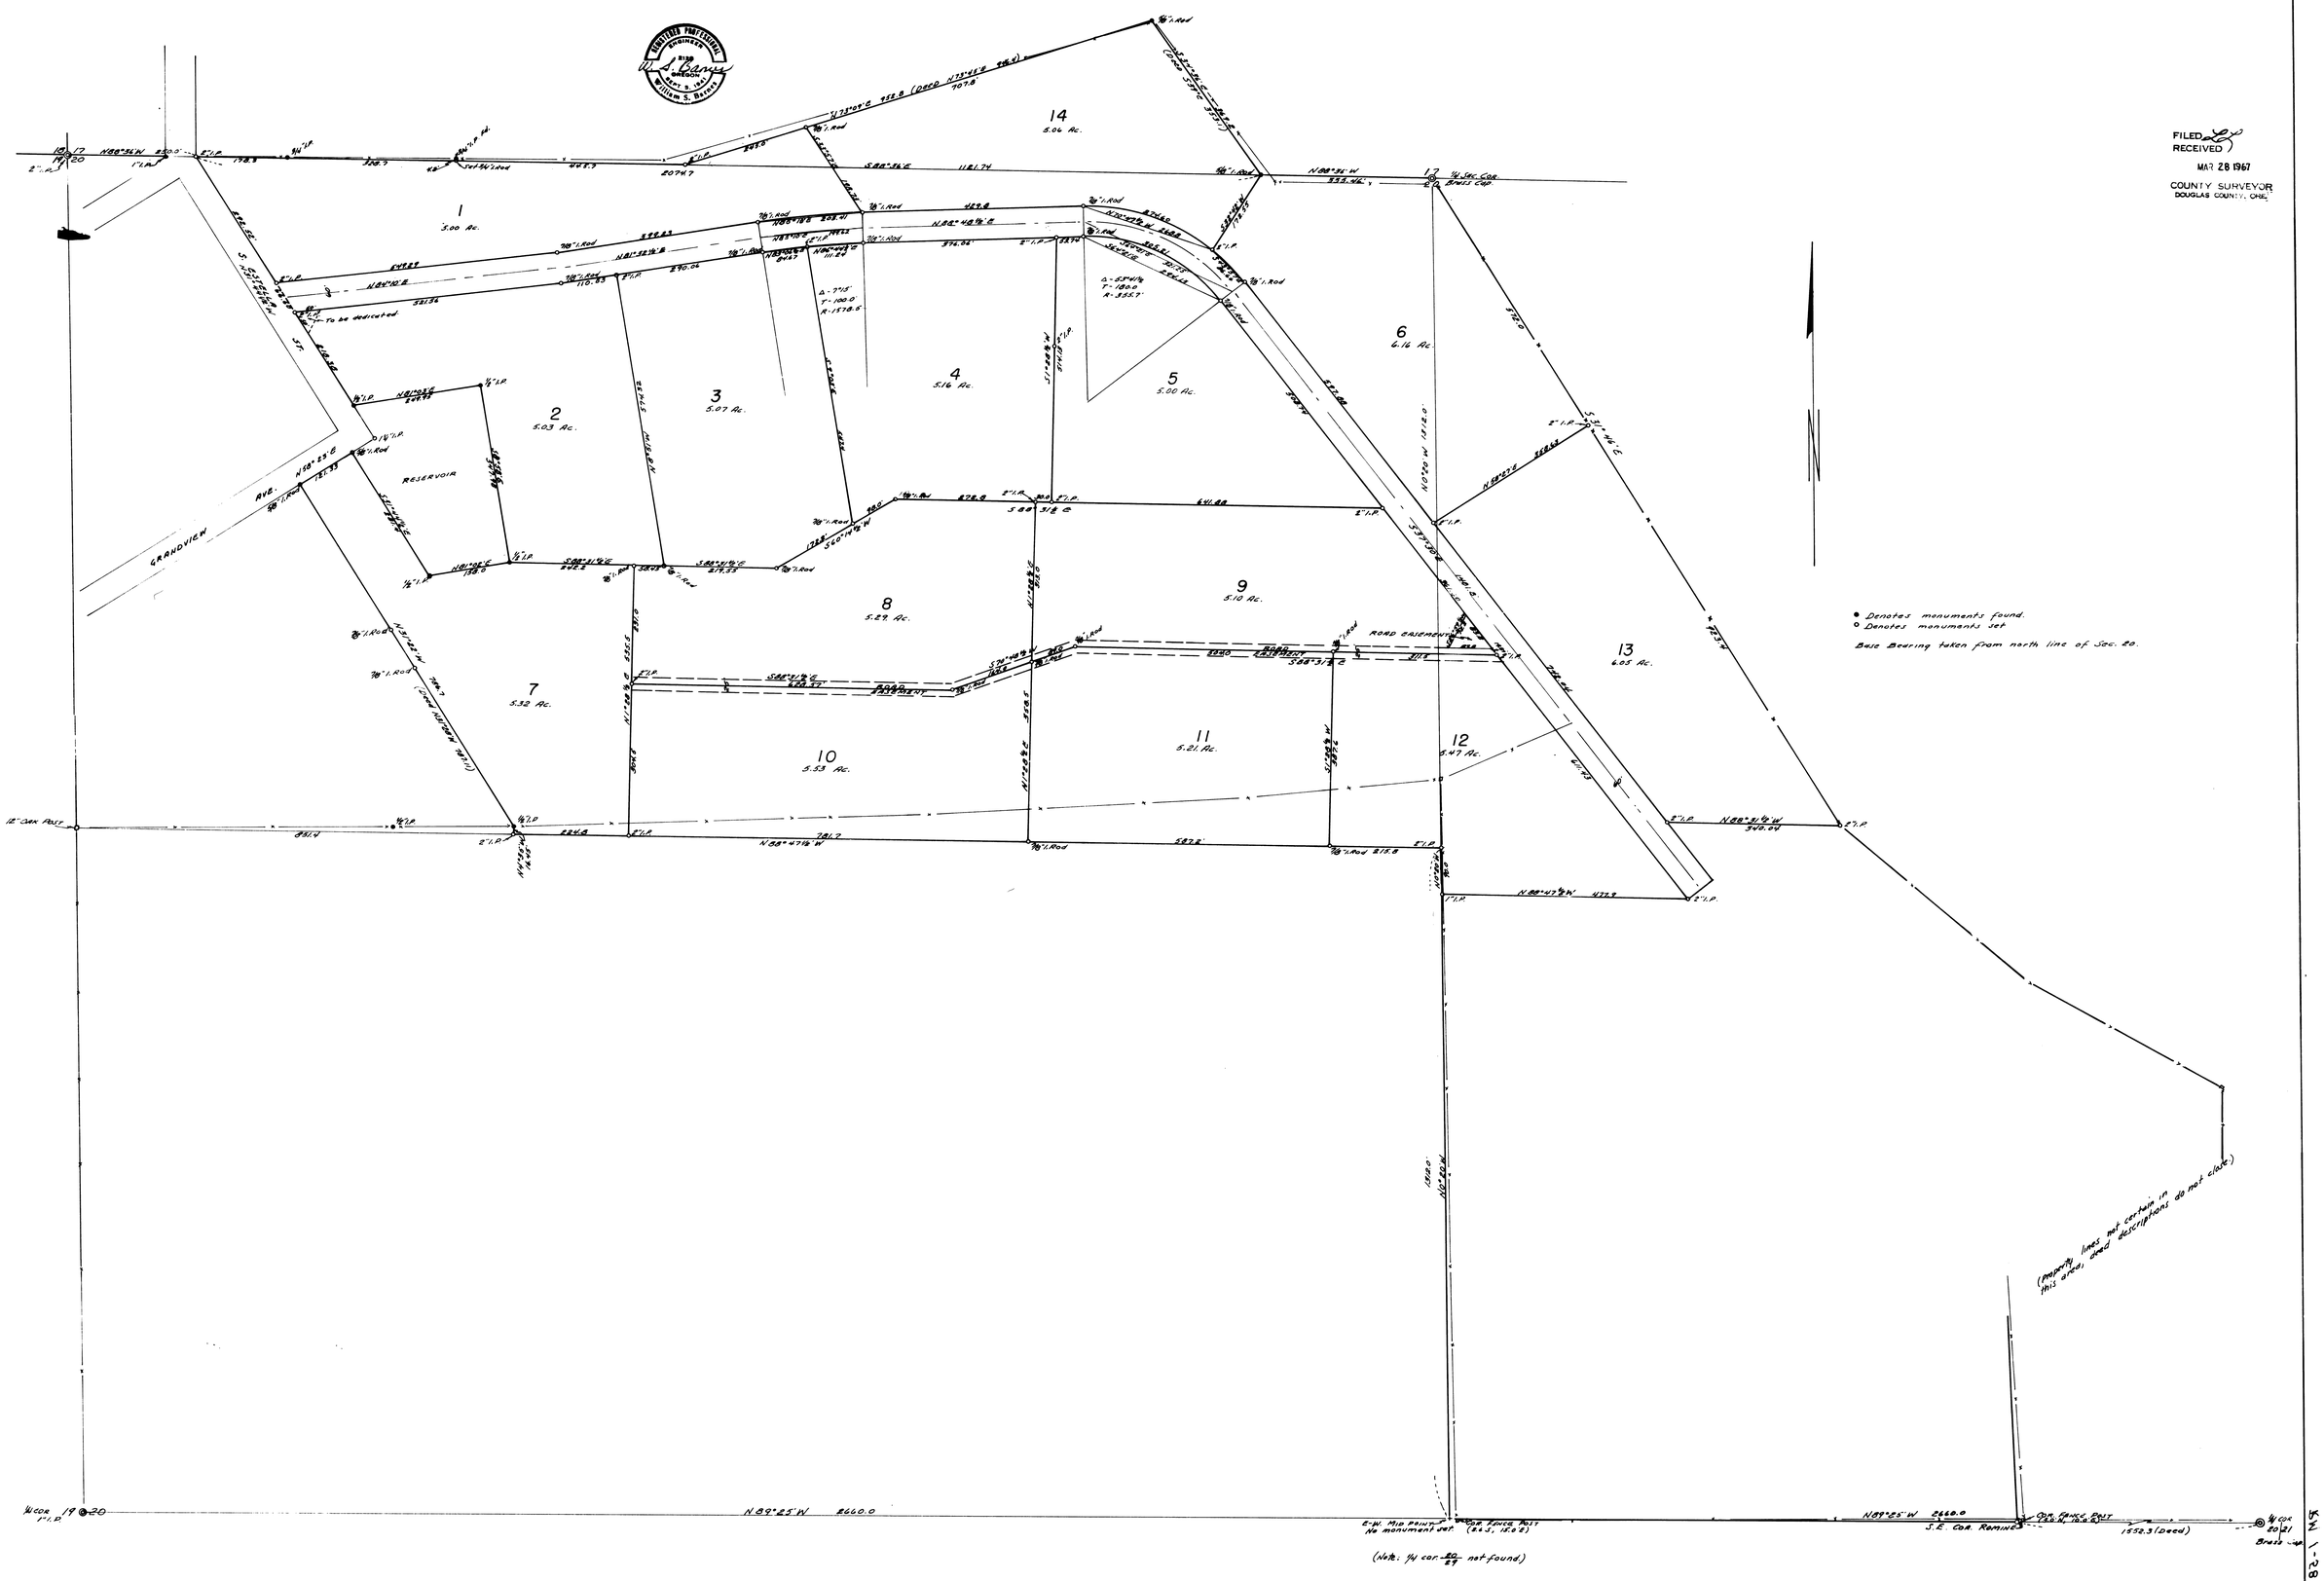

NOTE: Photographic Mylar made of RM 1-58 on 12/99 to pre erave worn original.