RM 1-75

OCT 8 1969
COUNTY SURVEYOR
DOUGLAS COUNTY, ORE.

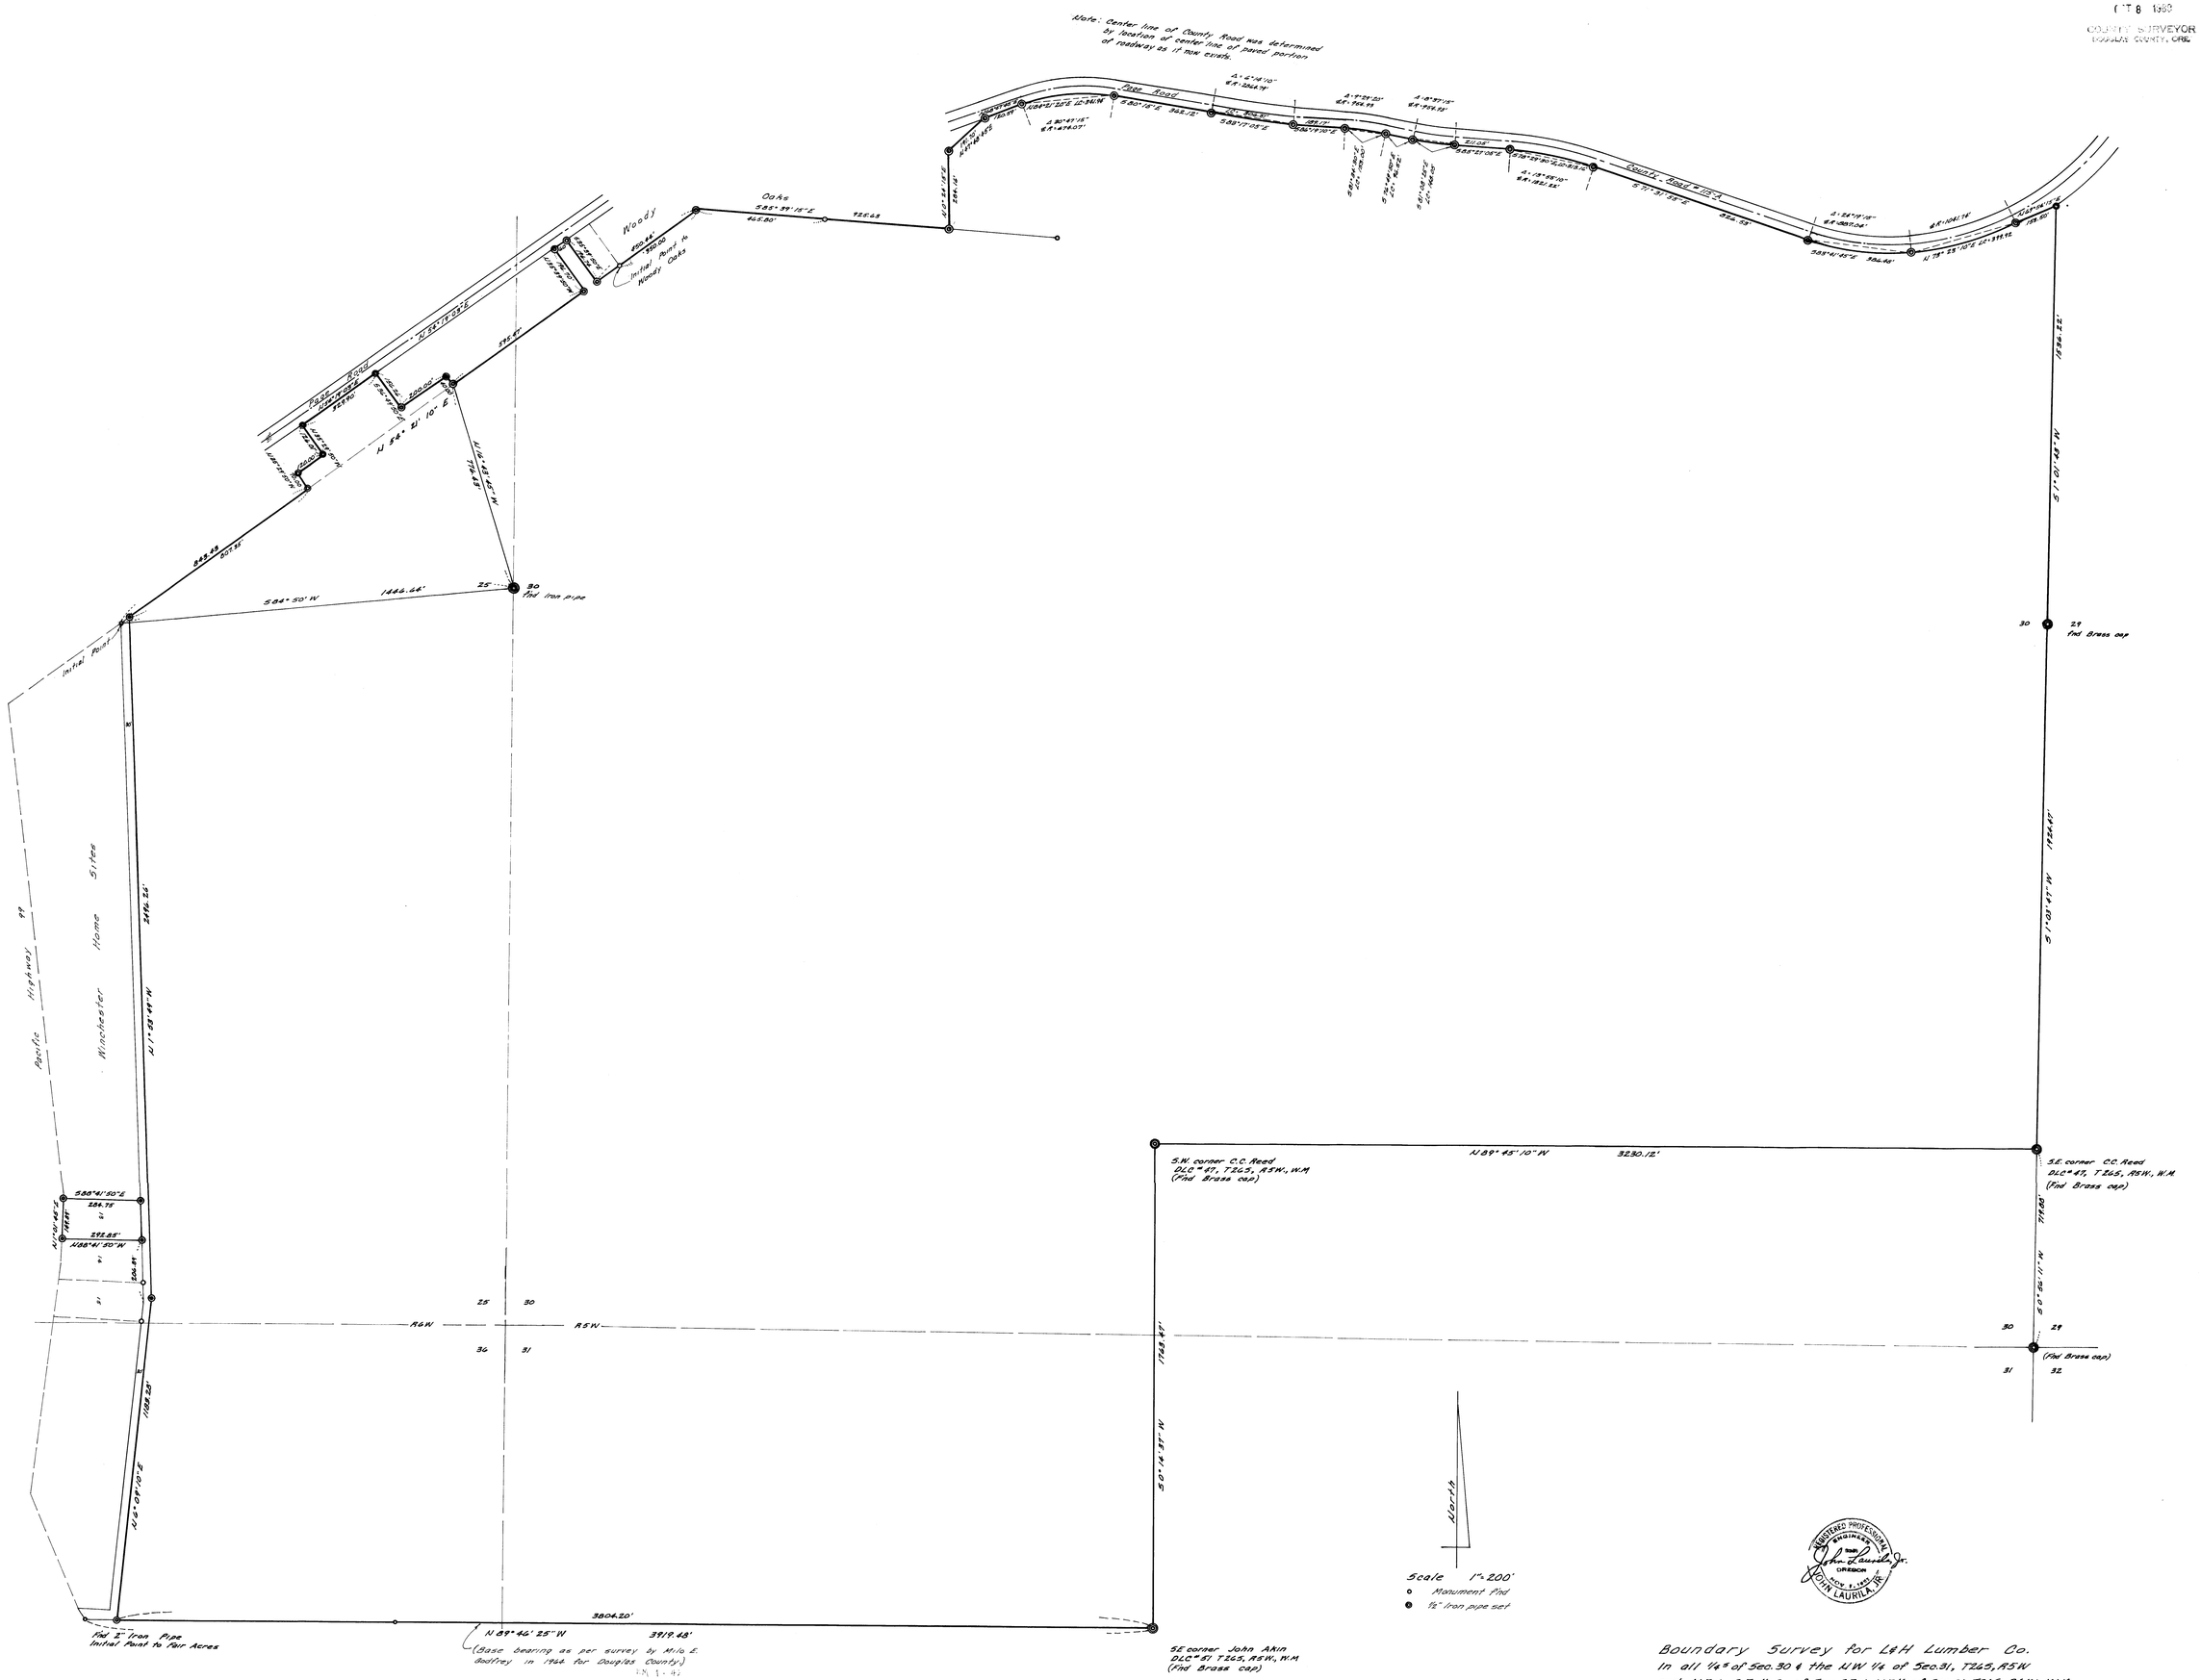

Boundary Survey for L&H Lumber Co.
In all 1/4's of Sec. 30 & the NW 1/4 of Sec. 31, T26S, R5W
and NE & SE 1/4's of Sec. 25 & NE 1/4 of Sec. 36, T26S, R6W, W.M.
In Douglas County, Oregon

Western Engineering Consultants
1445 Willamette Street Eugene, Oregon
Drawn DS; 3-10-69; Checked ; Job No. 5096

Tube # 772

RM 1-75