RM 1-78

SURVEY IN SEC. 31 T.26S., R6W, W.M.

SURVEYED FOR W.L.S. ASSOCIATED INVESTORS
SURVEYED BY DON E. GARRETT
FEBRUARY, 1970 SCALE: 1" = 100'

o— DENOTES SET 5/8" I. ROD

REGISTERED OREGON LAND SURVEYOR
JULY 14, 1961
DON E. GARRETT
544

MAR 19 1970
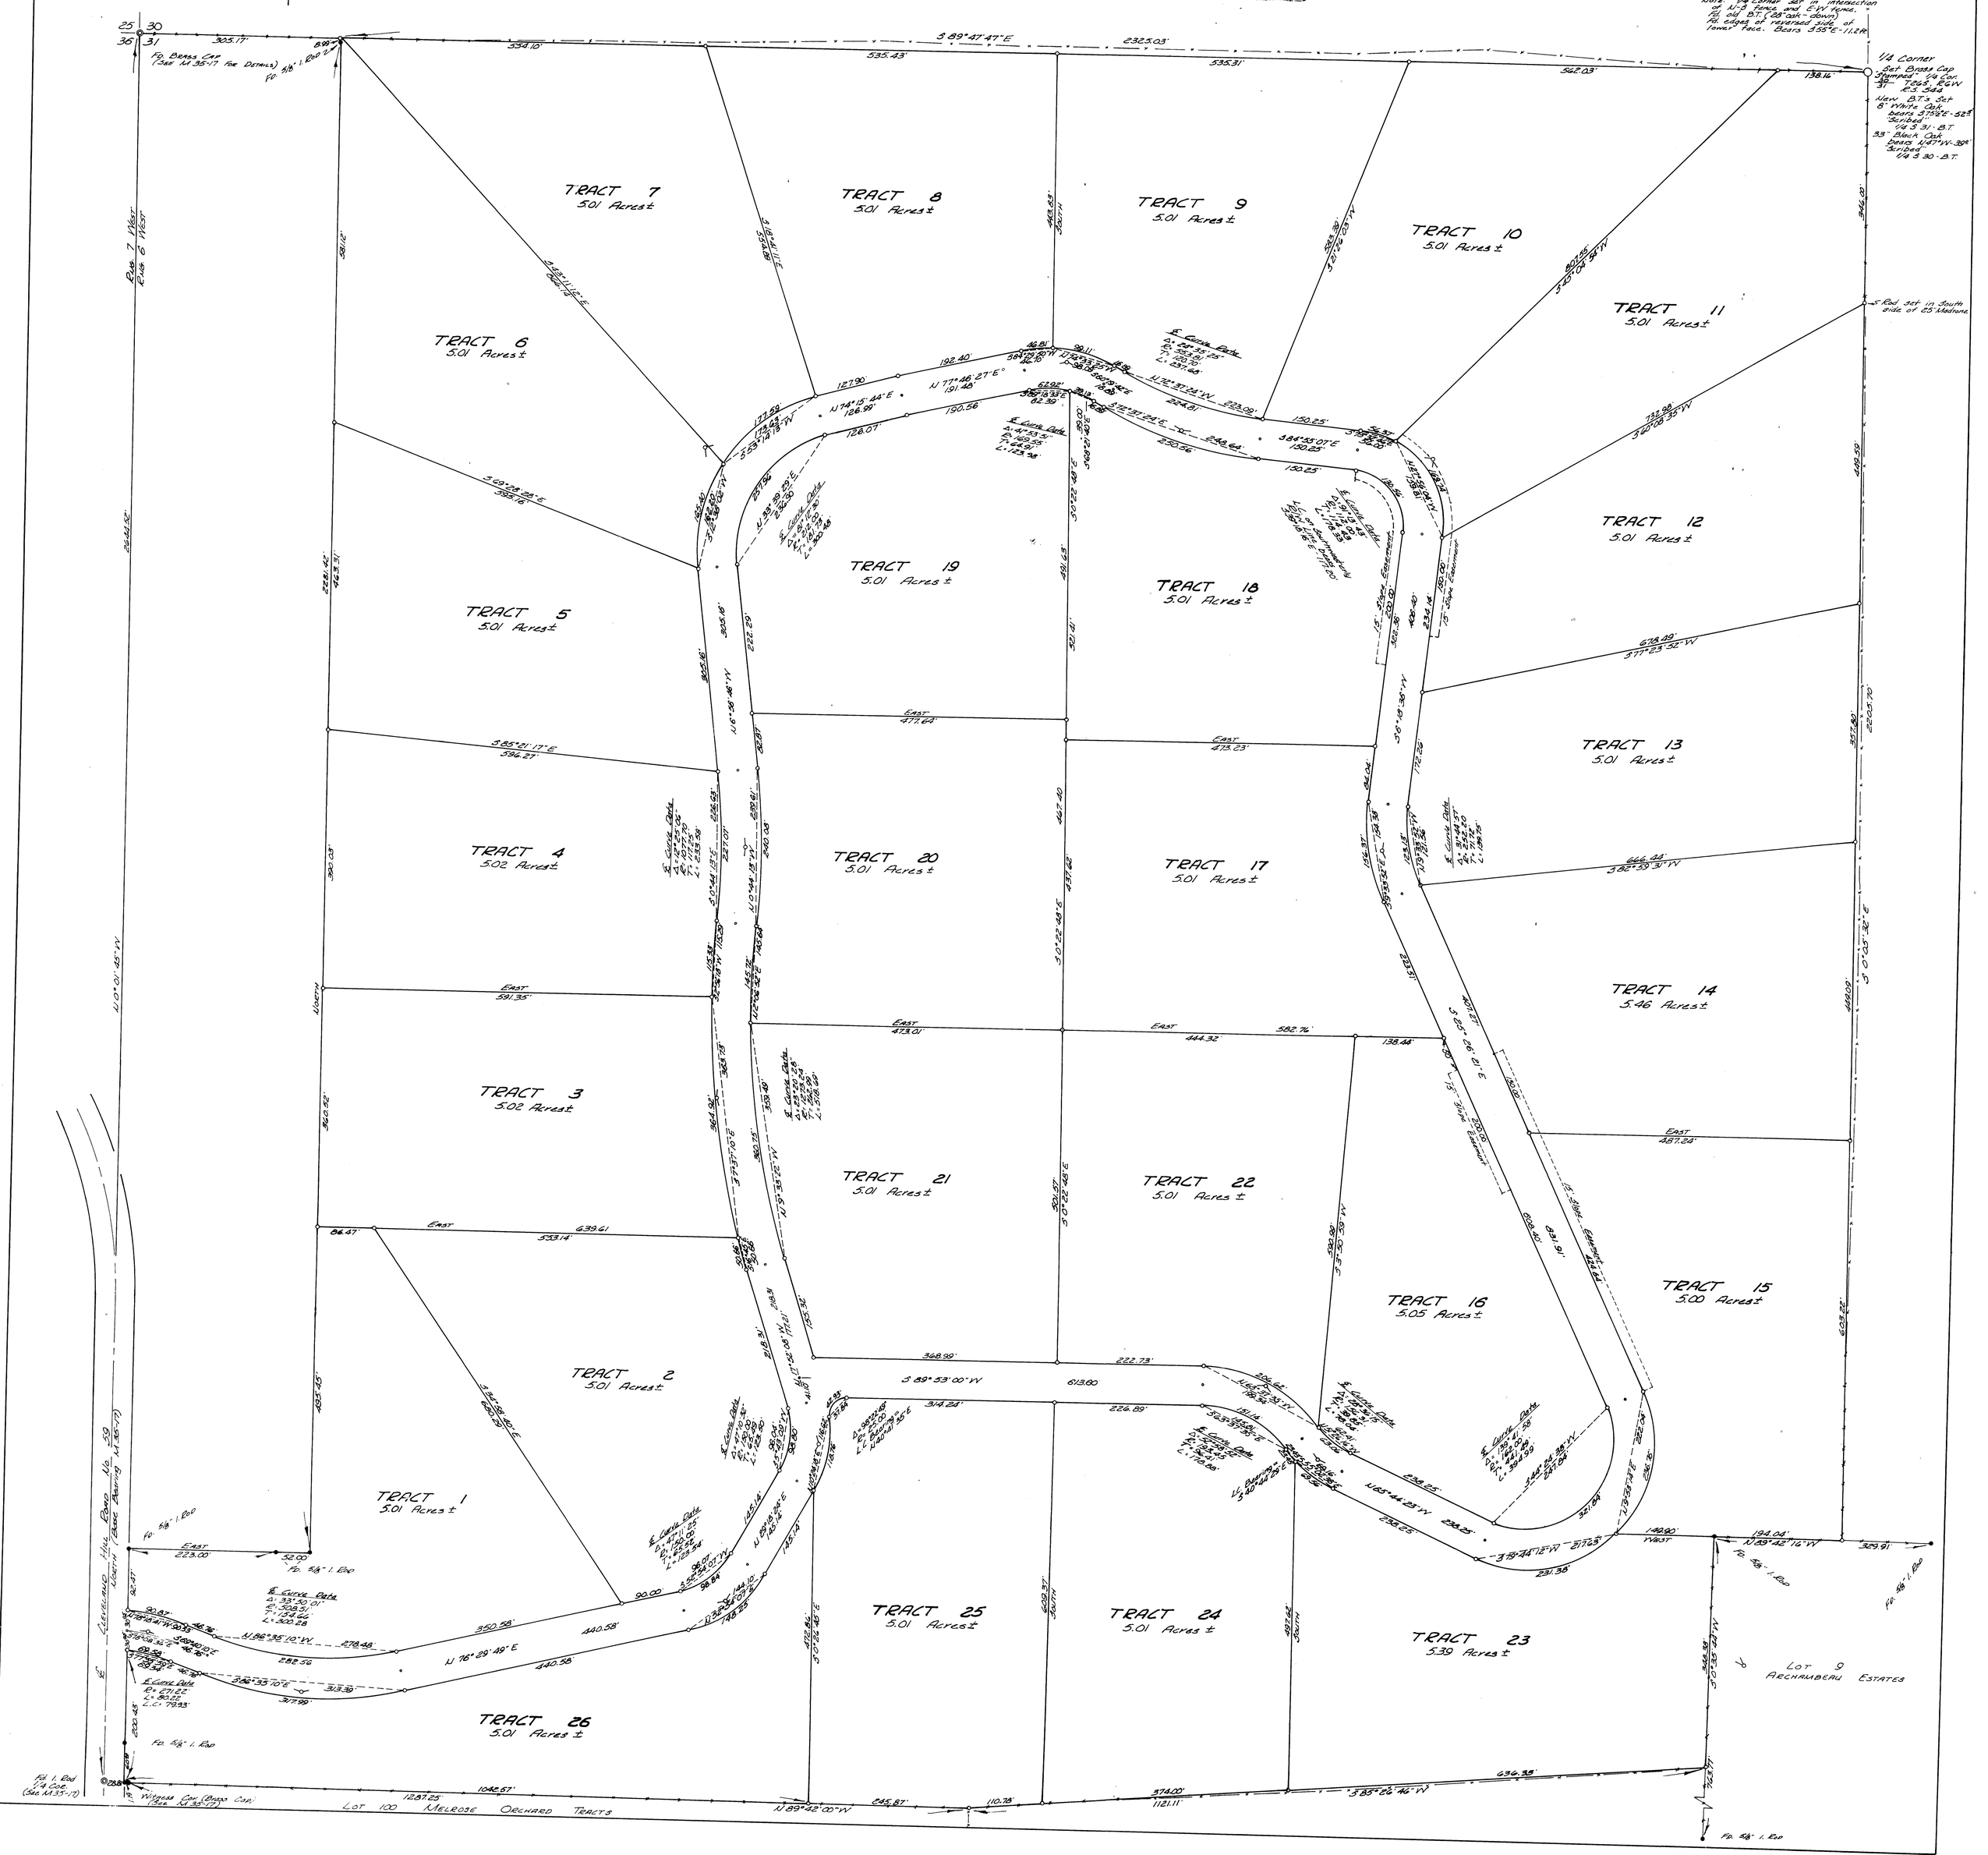
DIAZO COPY MADE
APRIL 1999, USING A
"REPROTECHNOLOGY 5000"
BLUEPRINT MACHINE