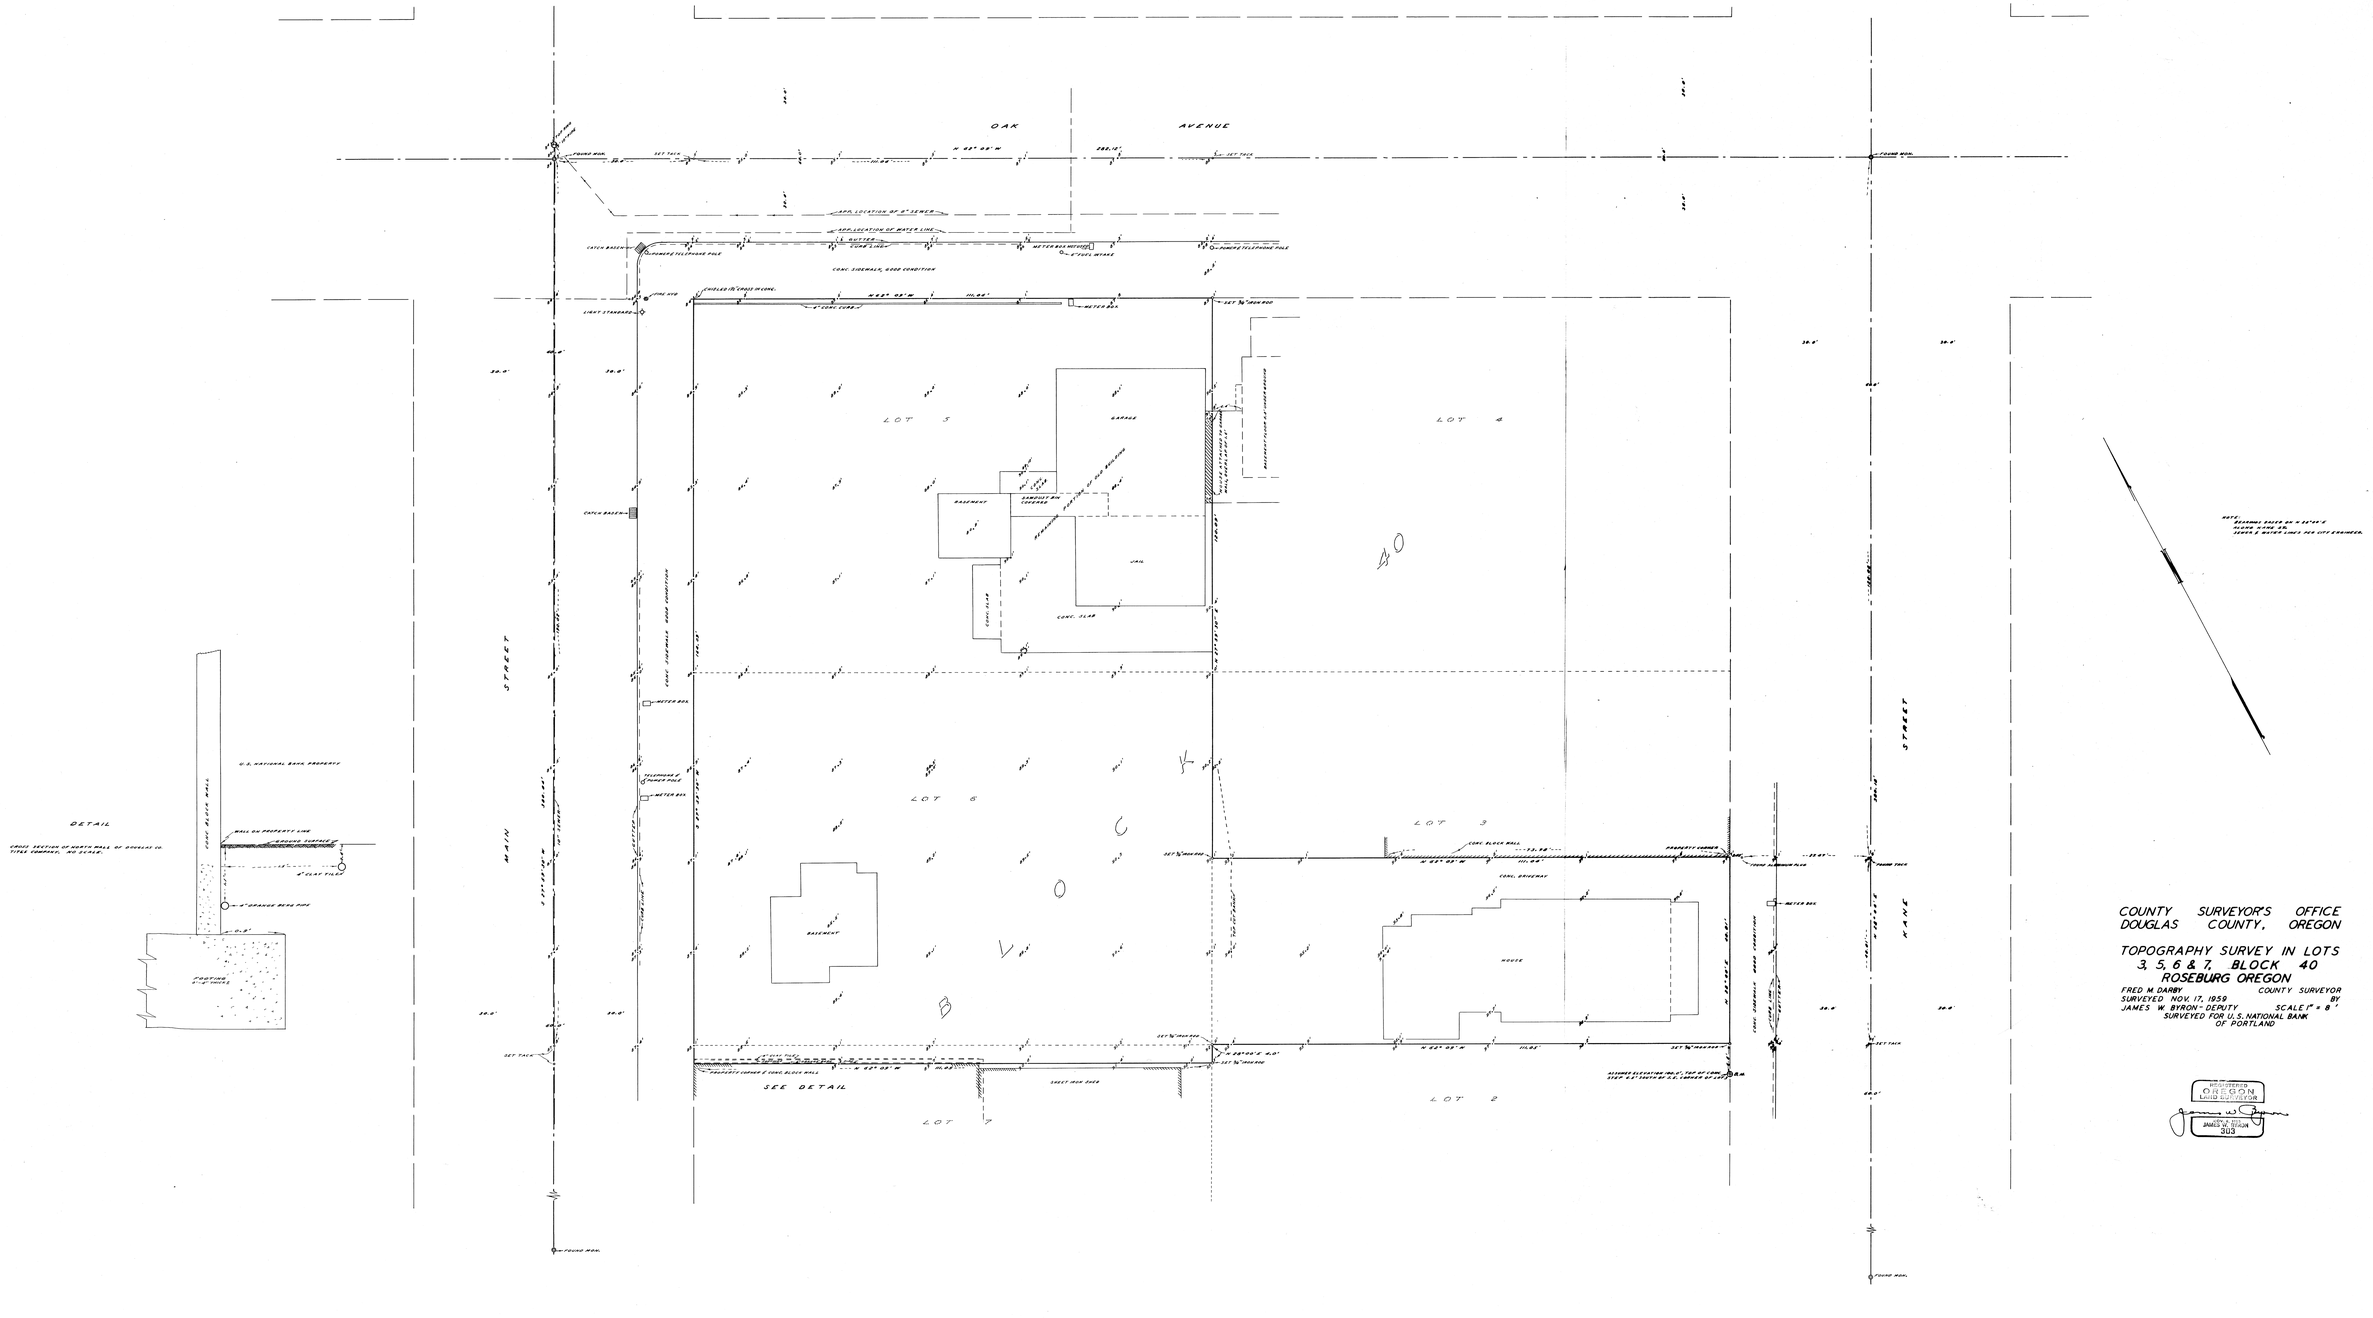
OAK AVENUE
MAIN STREET
KANE STREET
LOT 3
LOT 4
LOT 5
LOT 6
LOT 2
GARAGE
BASEMENT
HOUSE
CONC. SLAB
CONC. DRIVEWAY
CONC. BLOCK WALL
SEE DETAIL
DETAIL
U.S. NATIONAL BANK PROPERTY
FIRST FLOOR WALL
WALL ON PROPERTY LINE
FINISHED SURFACE
FOOTING
NOTE:
BEARINGS BASED ON N 62°49'E
COUNTY SURVEYOR'S OFFICE
DOUGLAS COUNTY, OREGON
TOPOGRAPHY SURVEY IN LOTS
3, 5, 6 & 7, BLOCK 40
ROSEBURG OREGON
FRED M. DARBY COUNTY SURVEYOR
SURVEYED NOV. 17, 1959 BY
JAMES W. BYRON - DEPUTY SCALE 1" = 8'
SURVEYED FOR U.S. NATIONAL BANK
OF PORTLAND
REGISTERED
OREGON
LAND SURVEYOR
JAMES W. BYRON
303