RM 2-49

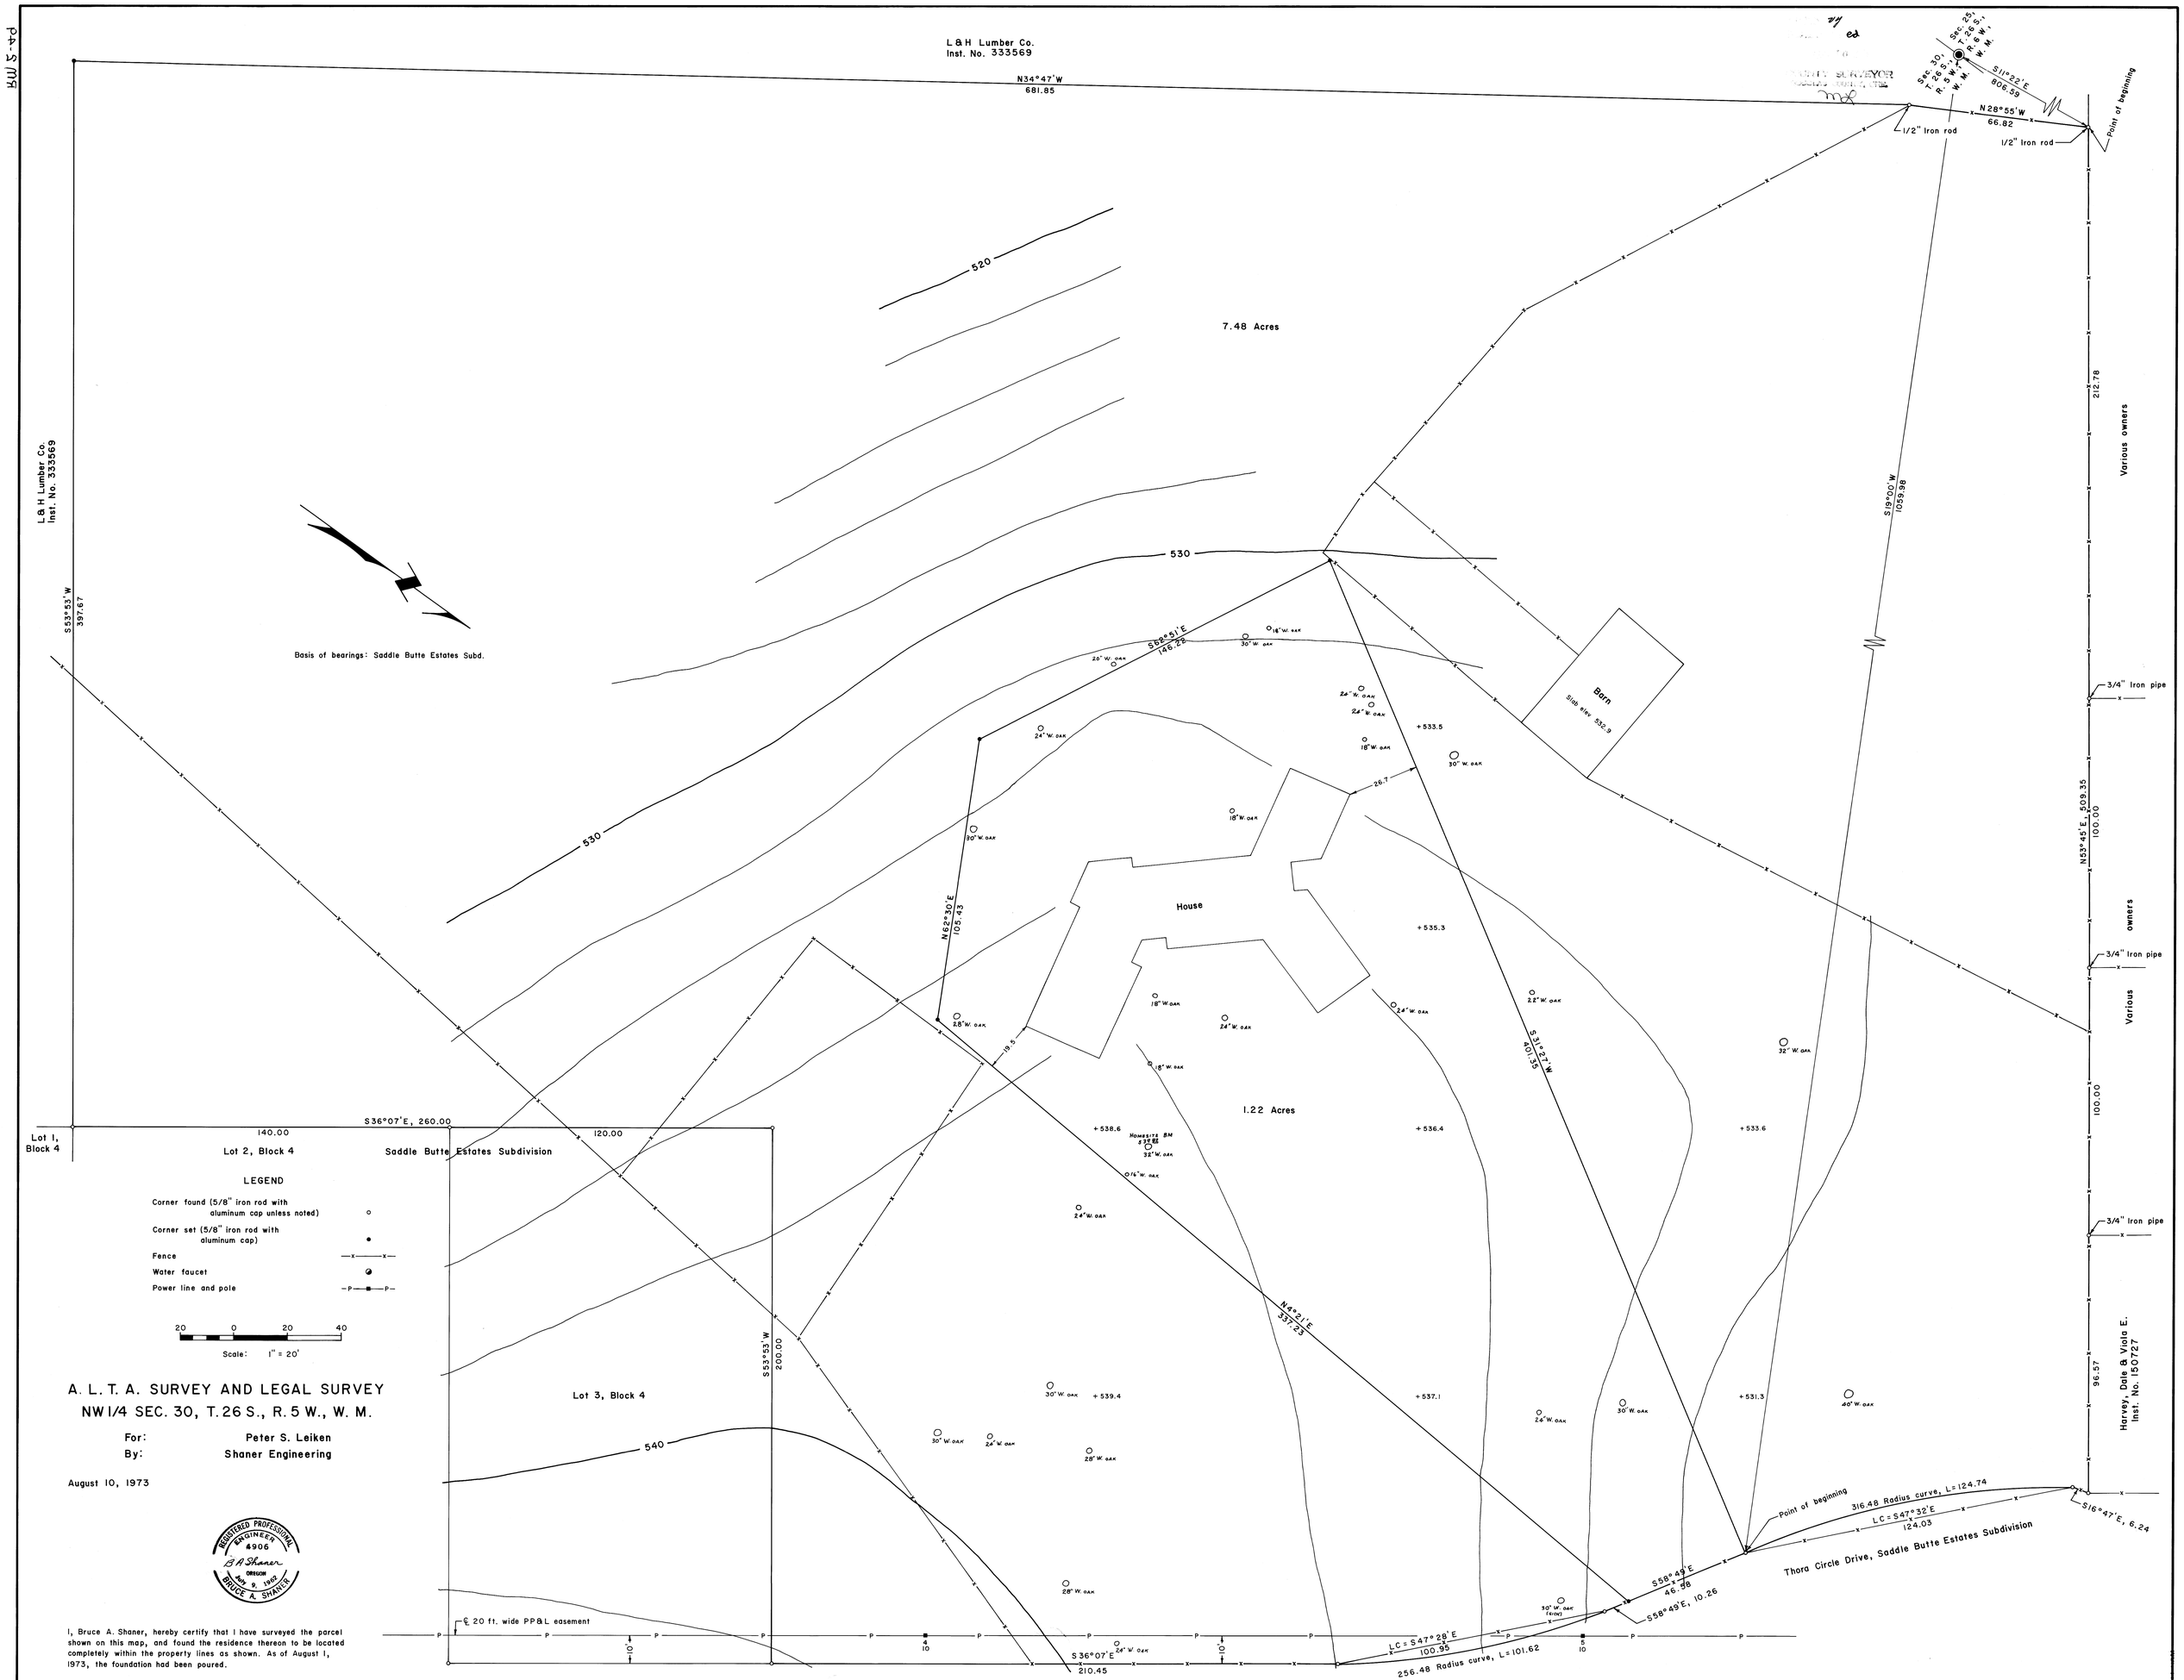

LEGEND

- Corner found (5/8" iron rod with aluminum cap unless noted)
- Corner set (5/8" iron rod with aluminum cap)
- Fence
- Water faucet
- Power line and pole

20 0 20 40

Scale: 1" = 20'

A. L. T. A. SURVEY AND LEGAL SURVEY
NW 1/4 SEC. 30, T. 26 S., R. 5 W., W. M.

For: Peter S. Leiken

By: Shaner Engineering

August 10, 1973

REGISTERED PROFESSIONAL ENGINEER 4906 OREGON July 9, 1968 BRUCE A. SHANER

I, Bruce A. Shaner, hereby certify that I have surveyed the parcel shown on this map, and found the residence thereon to be located completely within the property lines as shown. As of August 1, 1973, the foundation had been poured.

B A Shaner
Bruce A. Shaner

RM 2-49