


SE 1/4 17

B. ST.

A. ST.

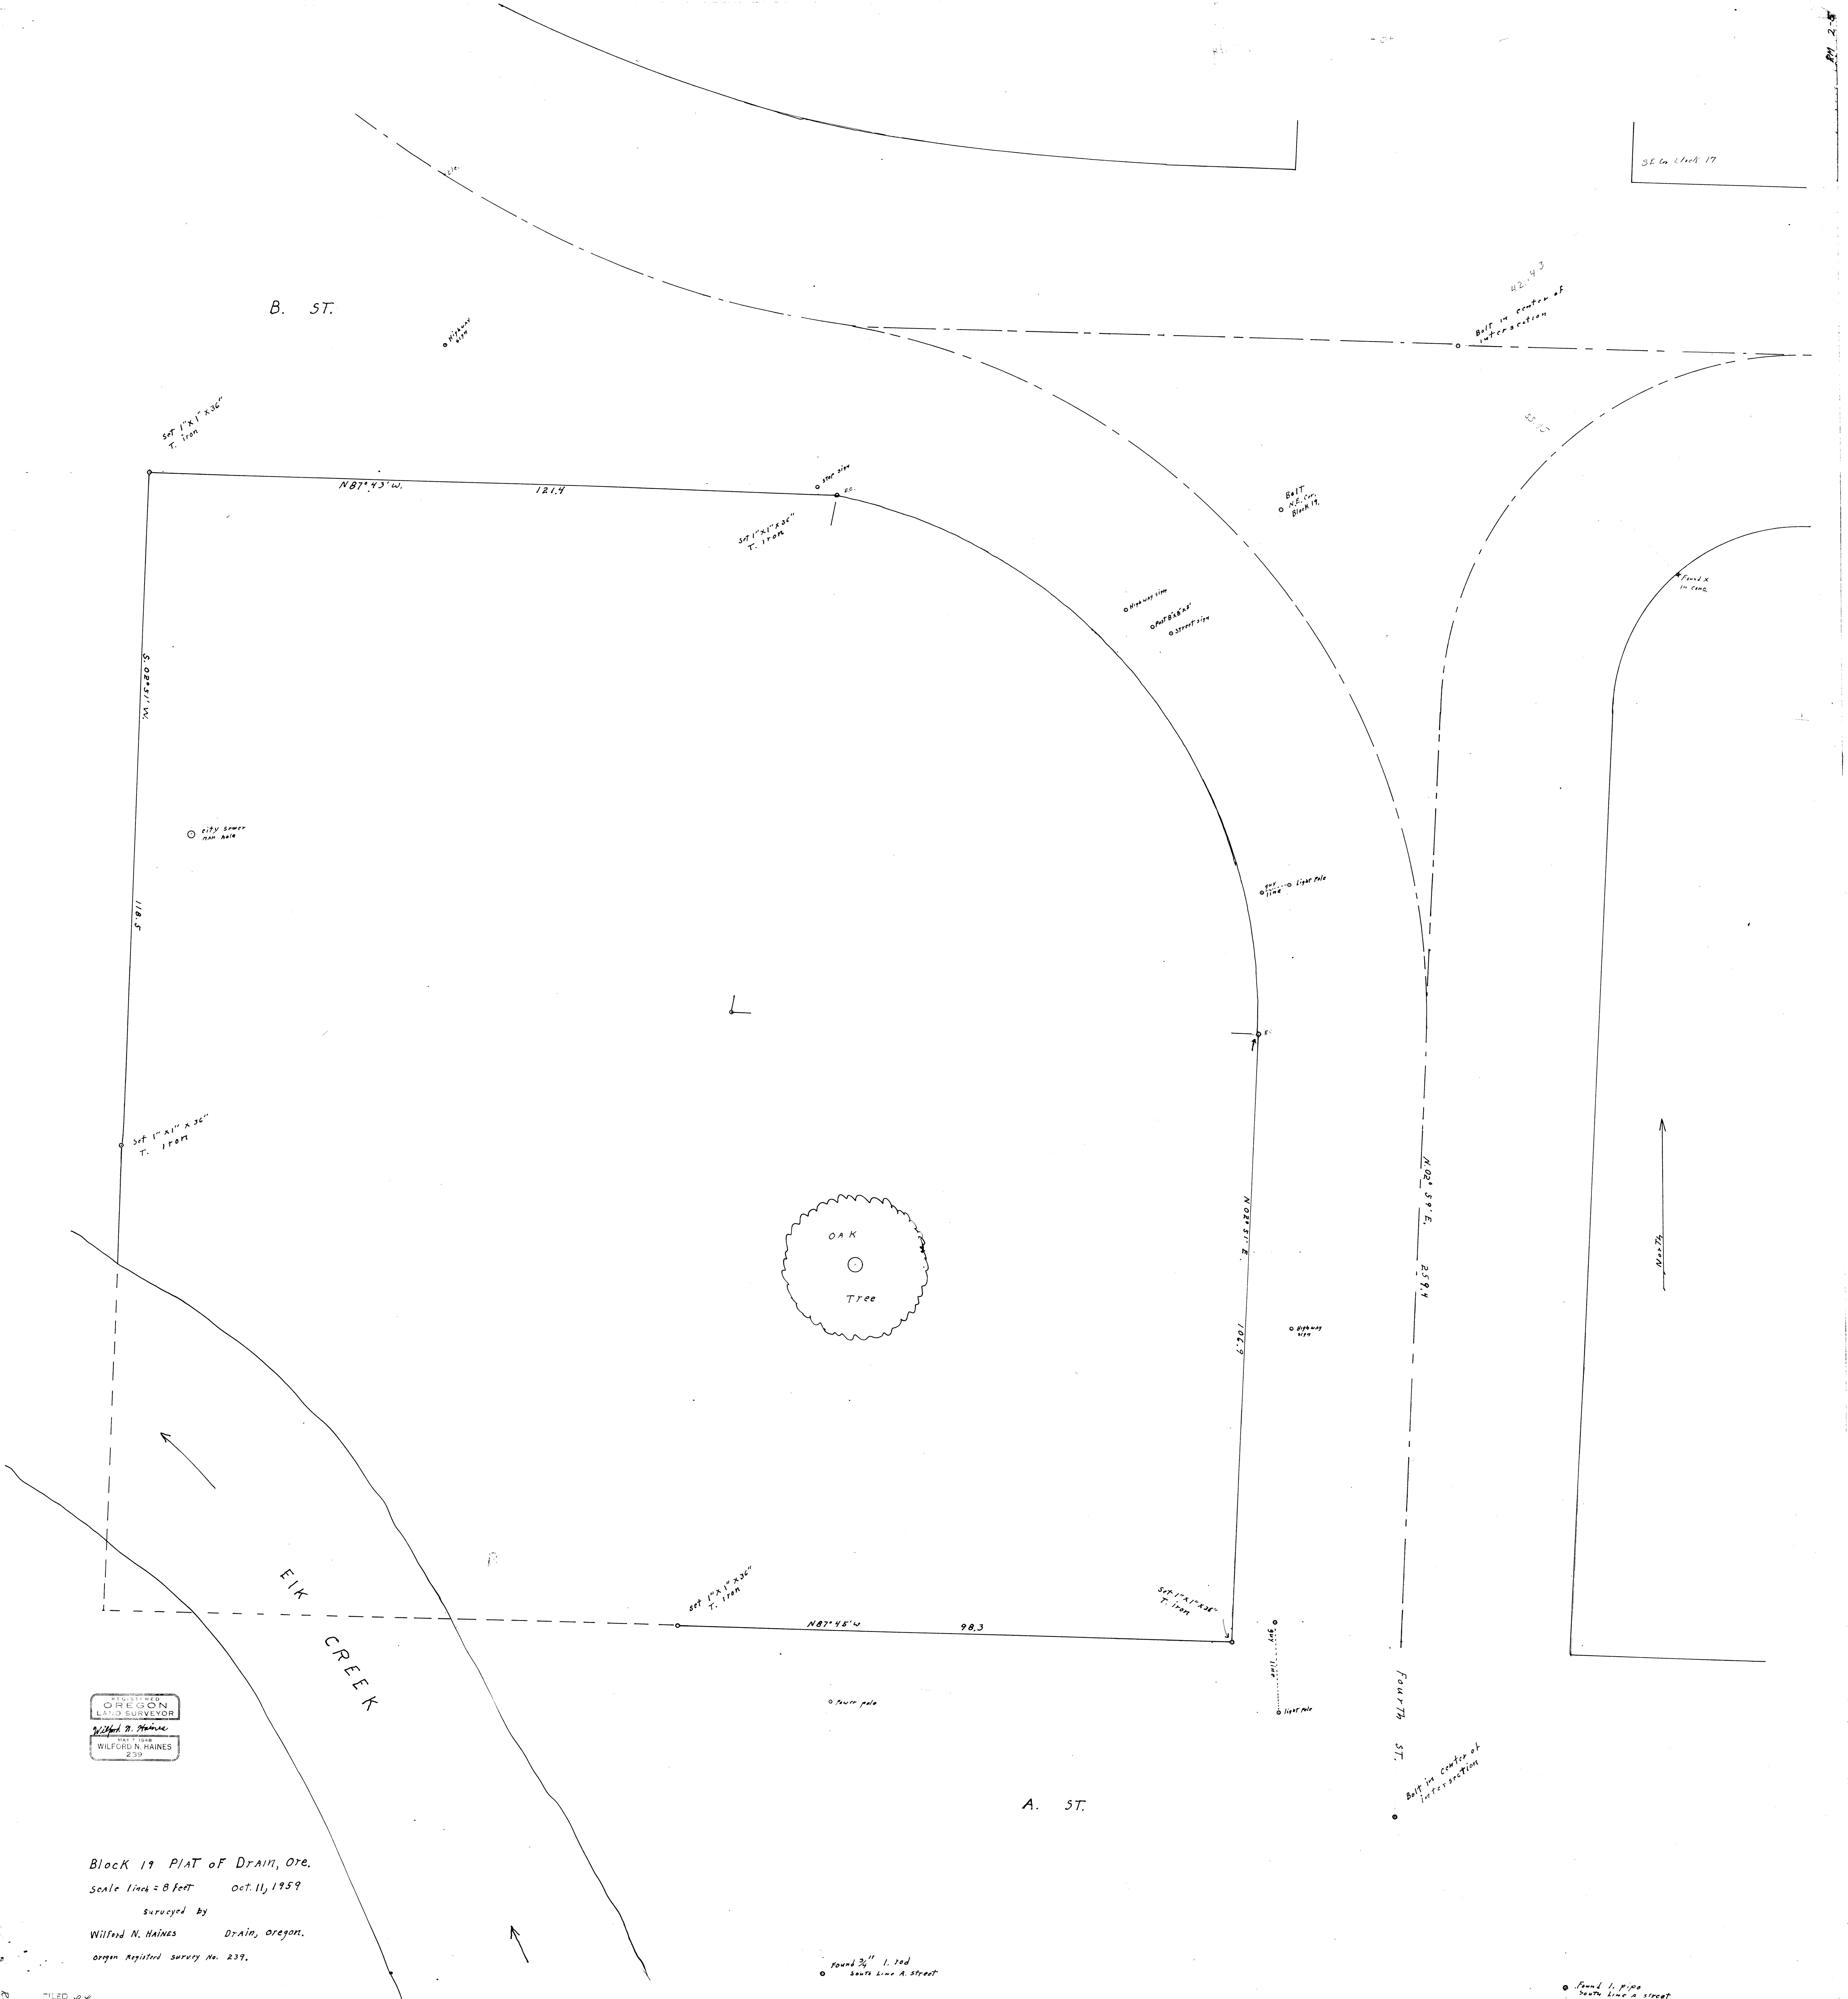

REGISTERED  
 OREGON  
 LAND SURVEYOR  
 Wilford N. Haines  
 WILFORD N. HAINES  
 239

Block 19 PLAT of Drain, Ore.  
 scale 1 inch = 8 feet oct. 11, 1959  
 surveyed by  
 Wilford N. HAINES Drain, Oregon.  
 Oregon Registered Survey No. 239.

FILED  
 COUNTY SURVEYOR  
 DRAIN, OREGON

RM 2-5

RM 2-5

RM 2-5