


Curve Data

- ① R=250'  
Δ=31°16'42"  
L=136.47'  
T=69.98'  
C=134.78'
- ② R=200'  
Δ=62°18'24"  
L=217.49'  
T=120.90'  
C=206.93'
- ③ R=572.96'  
- ④ Cul-de-Sac  
R=60'
- ⑤ R=100'  
Δ=35°15'06"  
L=61.52'  
T=31.77'  
C=60.55'
- ⑥ R=200'  
Δ=18°17'58"  
L=63.87'  
T=32.21'  
C=63.60'
- ⑦ R=200'  
Δ=33°32'09"  
L=117.06'  
T=60.26'  
C=115.39'
- ⑧ Cul-de-Sac  
R=60'
- ⑨ R=100'  
T=94.15'  
C=137.09'
- ⑩ R=150'  
Δ=66°48'14"  
L=174.69'  
T=90.91'  
C=165.15'
- ⑪ R=250'  
Δ=25°33'05"  
C=110.56'
- ⑫ Cul-de-Sac  
R=60'
- ⑬ R=100'  
T=85.94'  
C=130.35'
- ⑭ Cul-de-Sac  
R=60'
- ⑮ R=150'  
Δ=56°49'09"  
L=148.75'  
T=81.13'  
C=142.73'
- ⑯ R=572.96'  
Δ=8°30'55"  
L=85.15'  
T=42.65'  
C=85.07'
- ⑰ R=150'  
Δ=35°06'53"  
L=91.83'  
T=47.45'  
C=90.49'

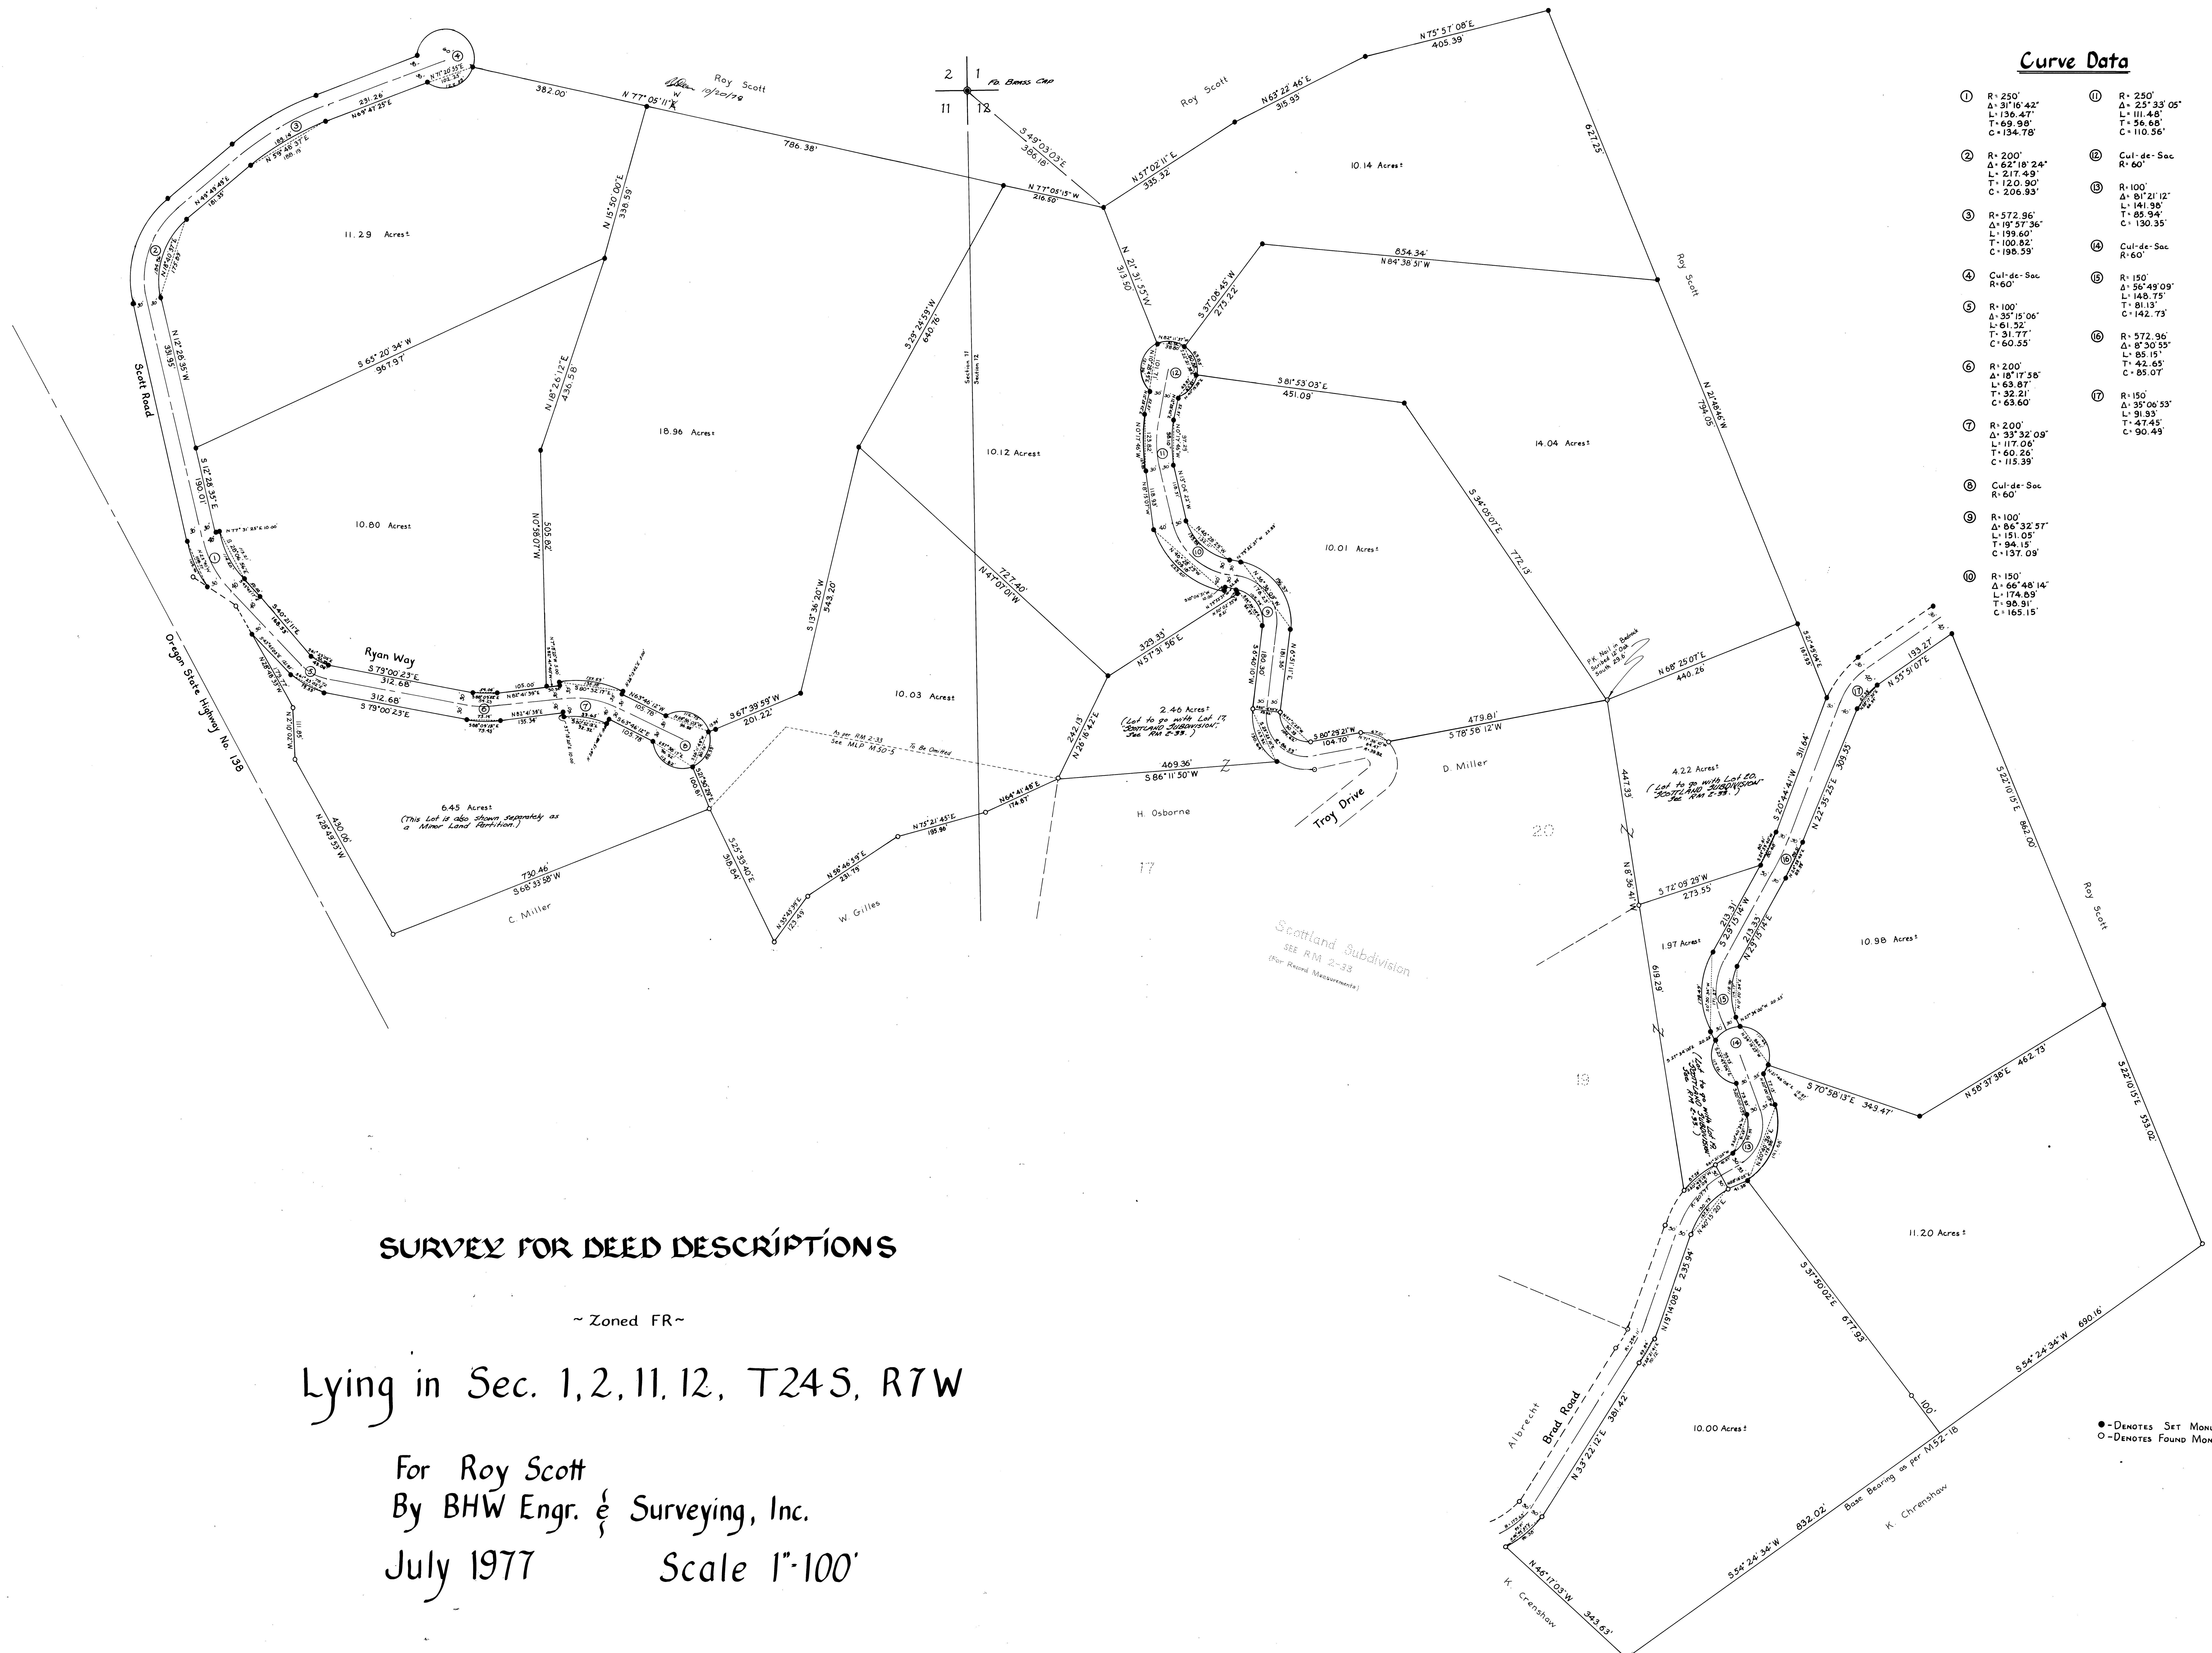

SURVEY FOR DEED DESCRIPTIONS

~ Zoned FR ~

Lying in Sec. 1, 2, 11, 12, T24S, R7W

For Roy Scott  
 By BHW Engr. & Surveying, Inc.  
 July 1977      Scale 1"=100'

● - DENOTES SET MONUMENTS  
 ○ - DENOTES FOUND MONUMENTS

*Bill B...*