SURVEY IN THE S.E. ¼ OF SECTION 5, T22S, R8W, W.M.
ALSO LOCATED IN THE ANDREW SAWYER D.L.C. Nº 49

Scale: 1" = 50'

August 1980

FOR: ROGER FICKLE

BY: BHW ENGINEERING & SURVEYING, INC.

NARRATIVE:

SURVEY MADE FOR THE PURPOSE OF TOPOGRAPHY AND MONUMENTING THE PERIMETER OF THAT PROPERTY DESCRIBED IN INSTRUMENT NO. 78-19309. PERIMETER WAS DETERMINED BY LOCATING THE FOUND MONUMENTS AS SHOWN AND PROJECTING THE PROPERTY LINES THEREFROM. THE BEARING OF THE WEST LINE WAS PROJECTED FROM DEED, BUT IT SHOULD BE NOTED THAT MAINTENANCE (BY THE PROPERTY OWNER) HAS BEEN MADE APPROXIMATELY 50 FEET WEST OF THAT LINE IN THE FORM OF GRASS AND BRUSH CUTTING. REFERENCE SURVEYS ARE M 2-29, M 59-50, C.S. 50/70 AND C.S. 58/92. SURVEY CREW: ROMEY WARE, GREG LANG AND BOB OSTEN. COMPUTATIONS: ROMEY WARE. DRAFTING: DEBBIE HOPKINS. FIELD EQUIPMENT: WILD T-1 THEODOLITE AND LEITZ RED-1 E.D.M.

LEGEND:

- ● — SET 5/8" x 30" IRON ROD
- ◉ — FD. BRASS CAP
- ○ — FD. MONUMENT AS NOTED
- △ — POINT IN RIVER

REGISTERED PROFESSIONAL LAND SURVEYOR
Romanus E. Ware
OREGON
DEC. 31, 1981
ROMANUS E. WARE
1005

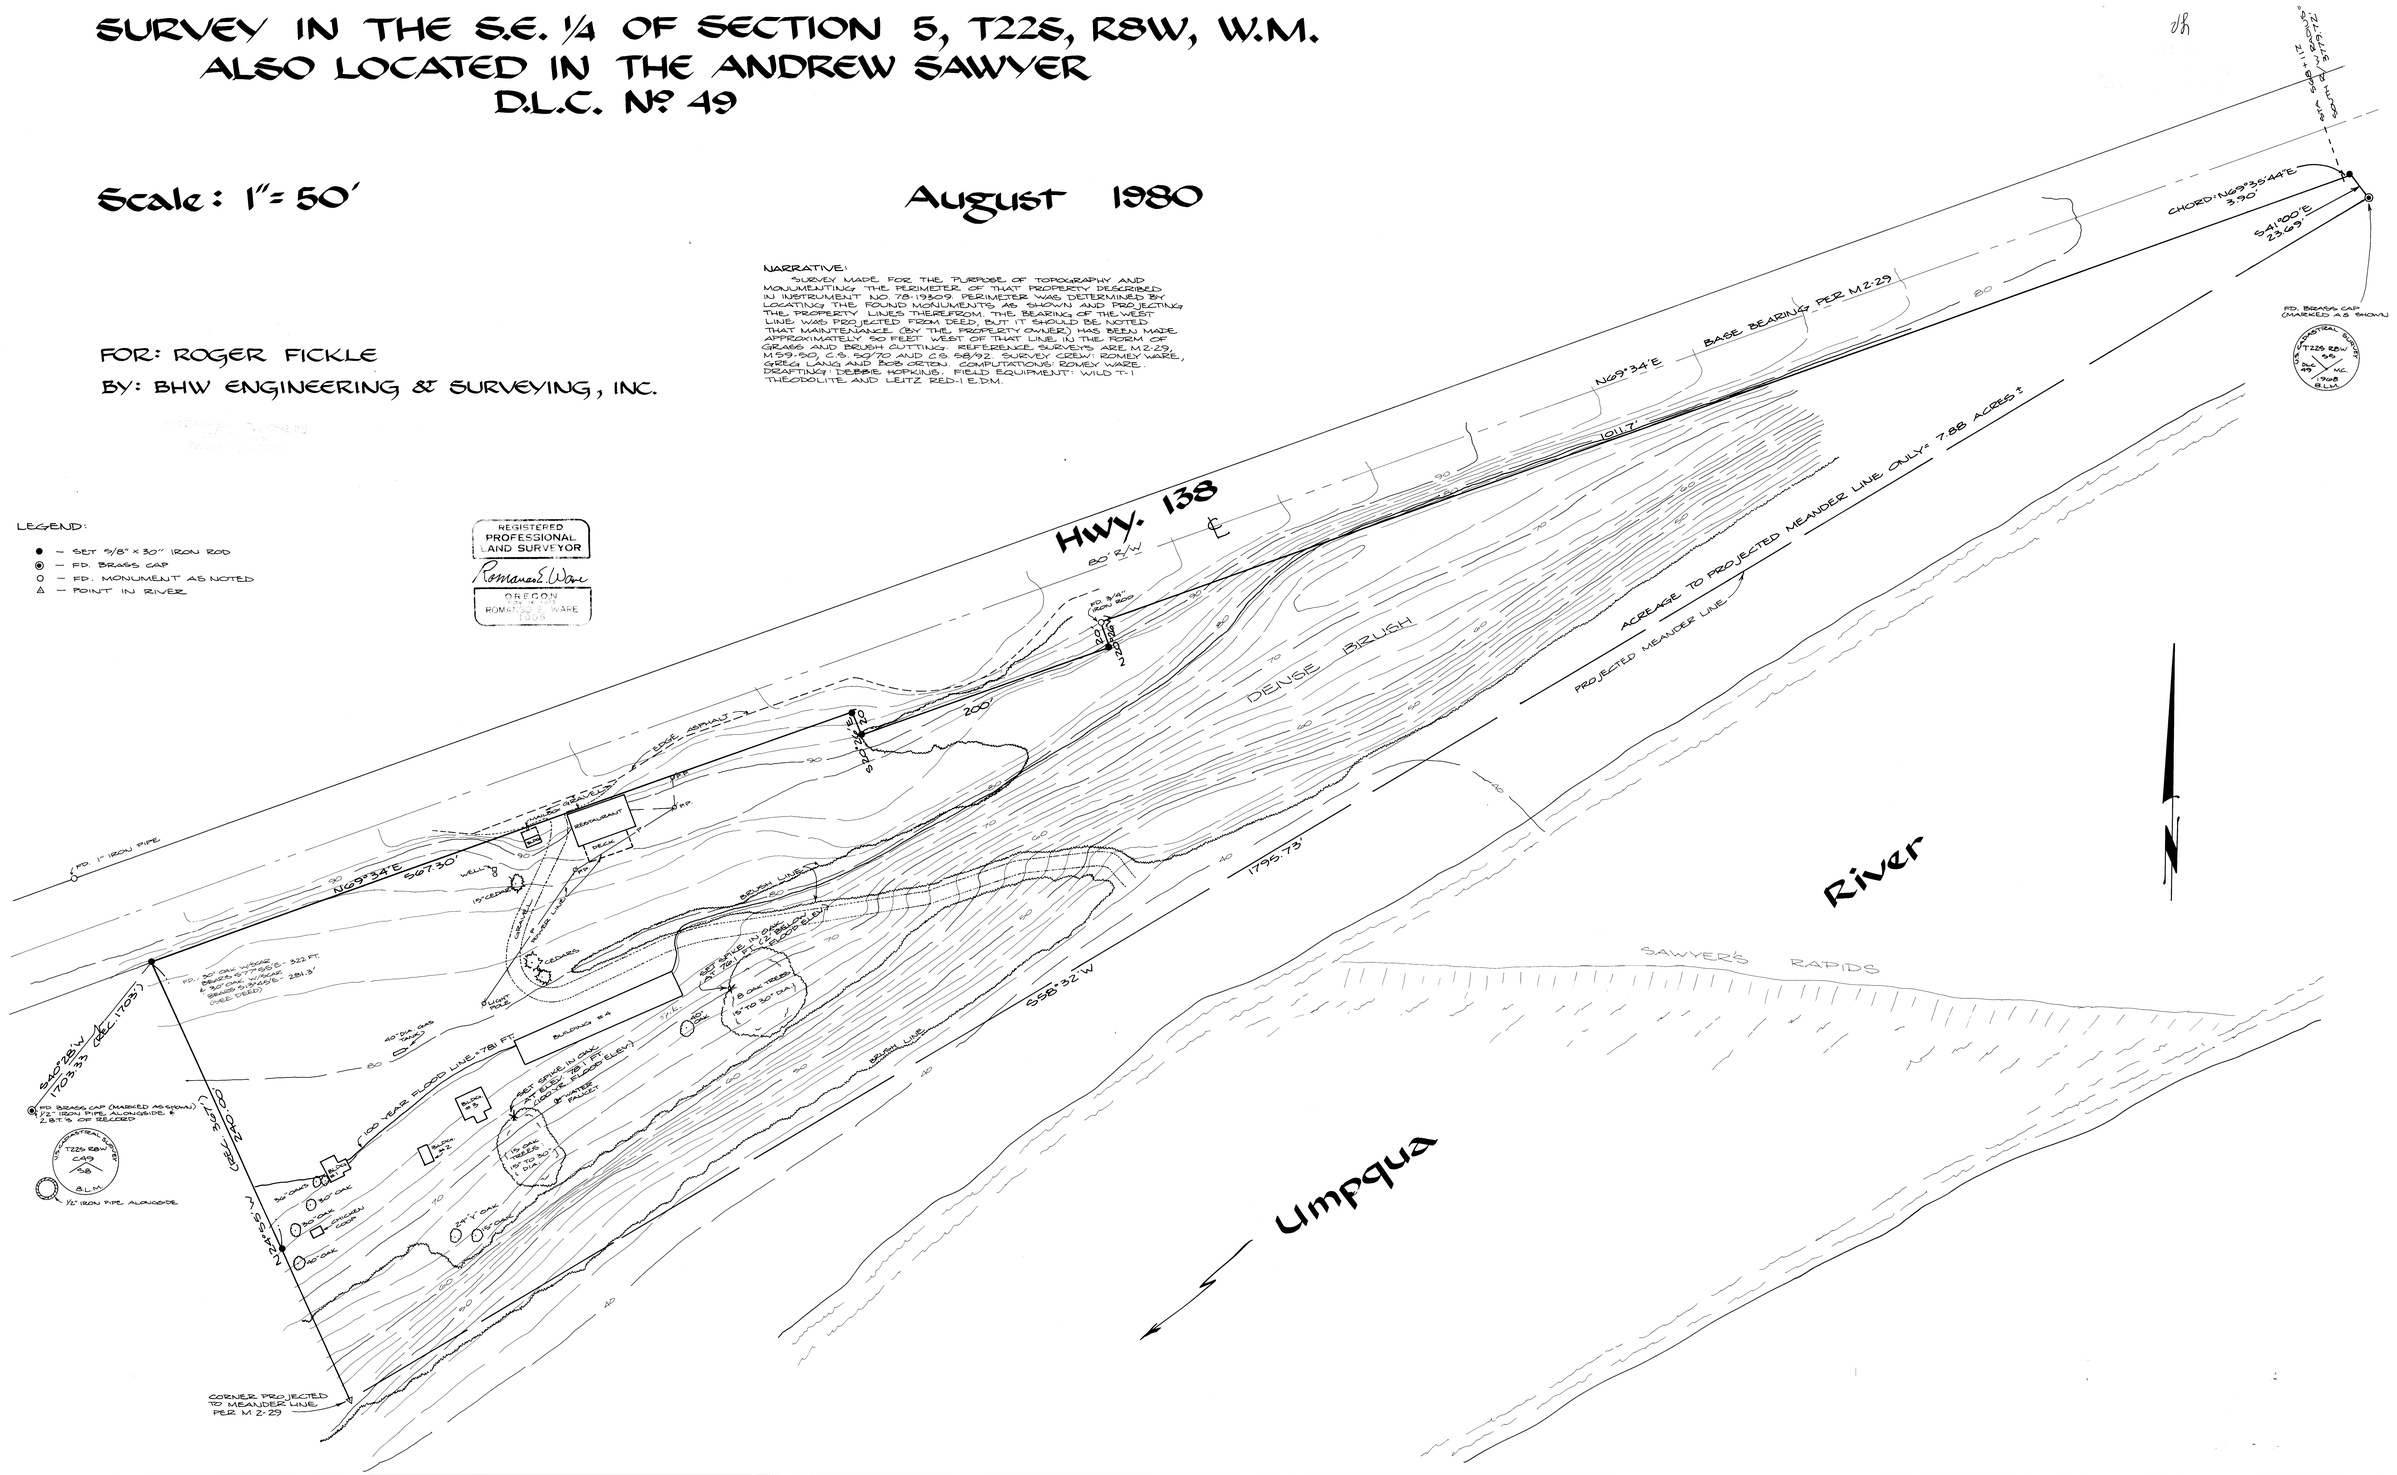

RM3-34