FILED
RECEIVED
JUL 31 1984
COUNTY SURVEYOR
DOUGLAS COUNTY, ORE.

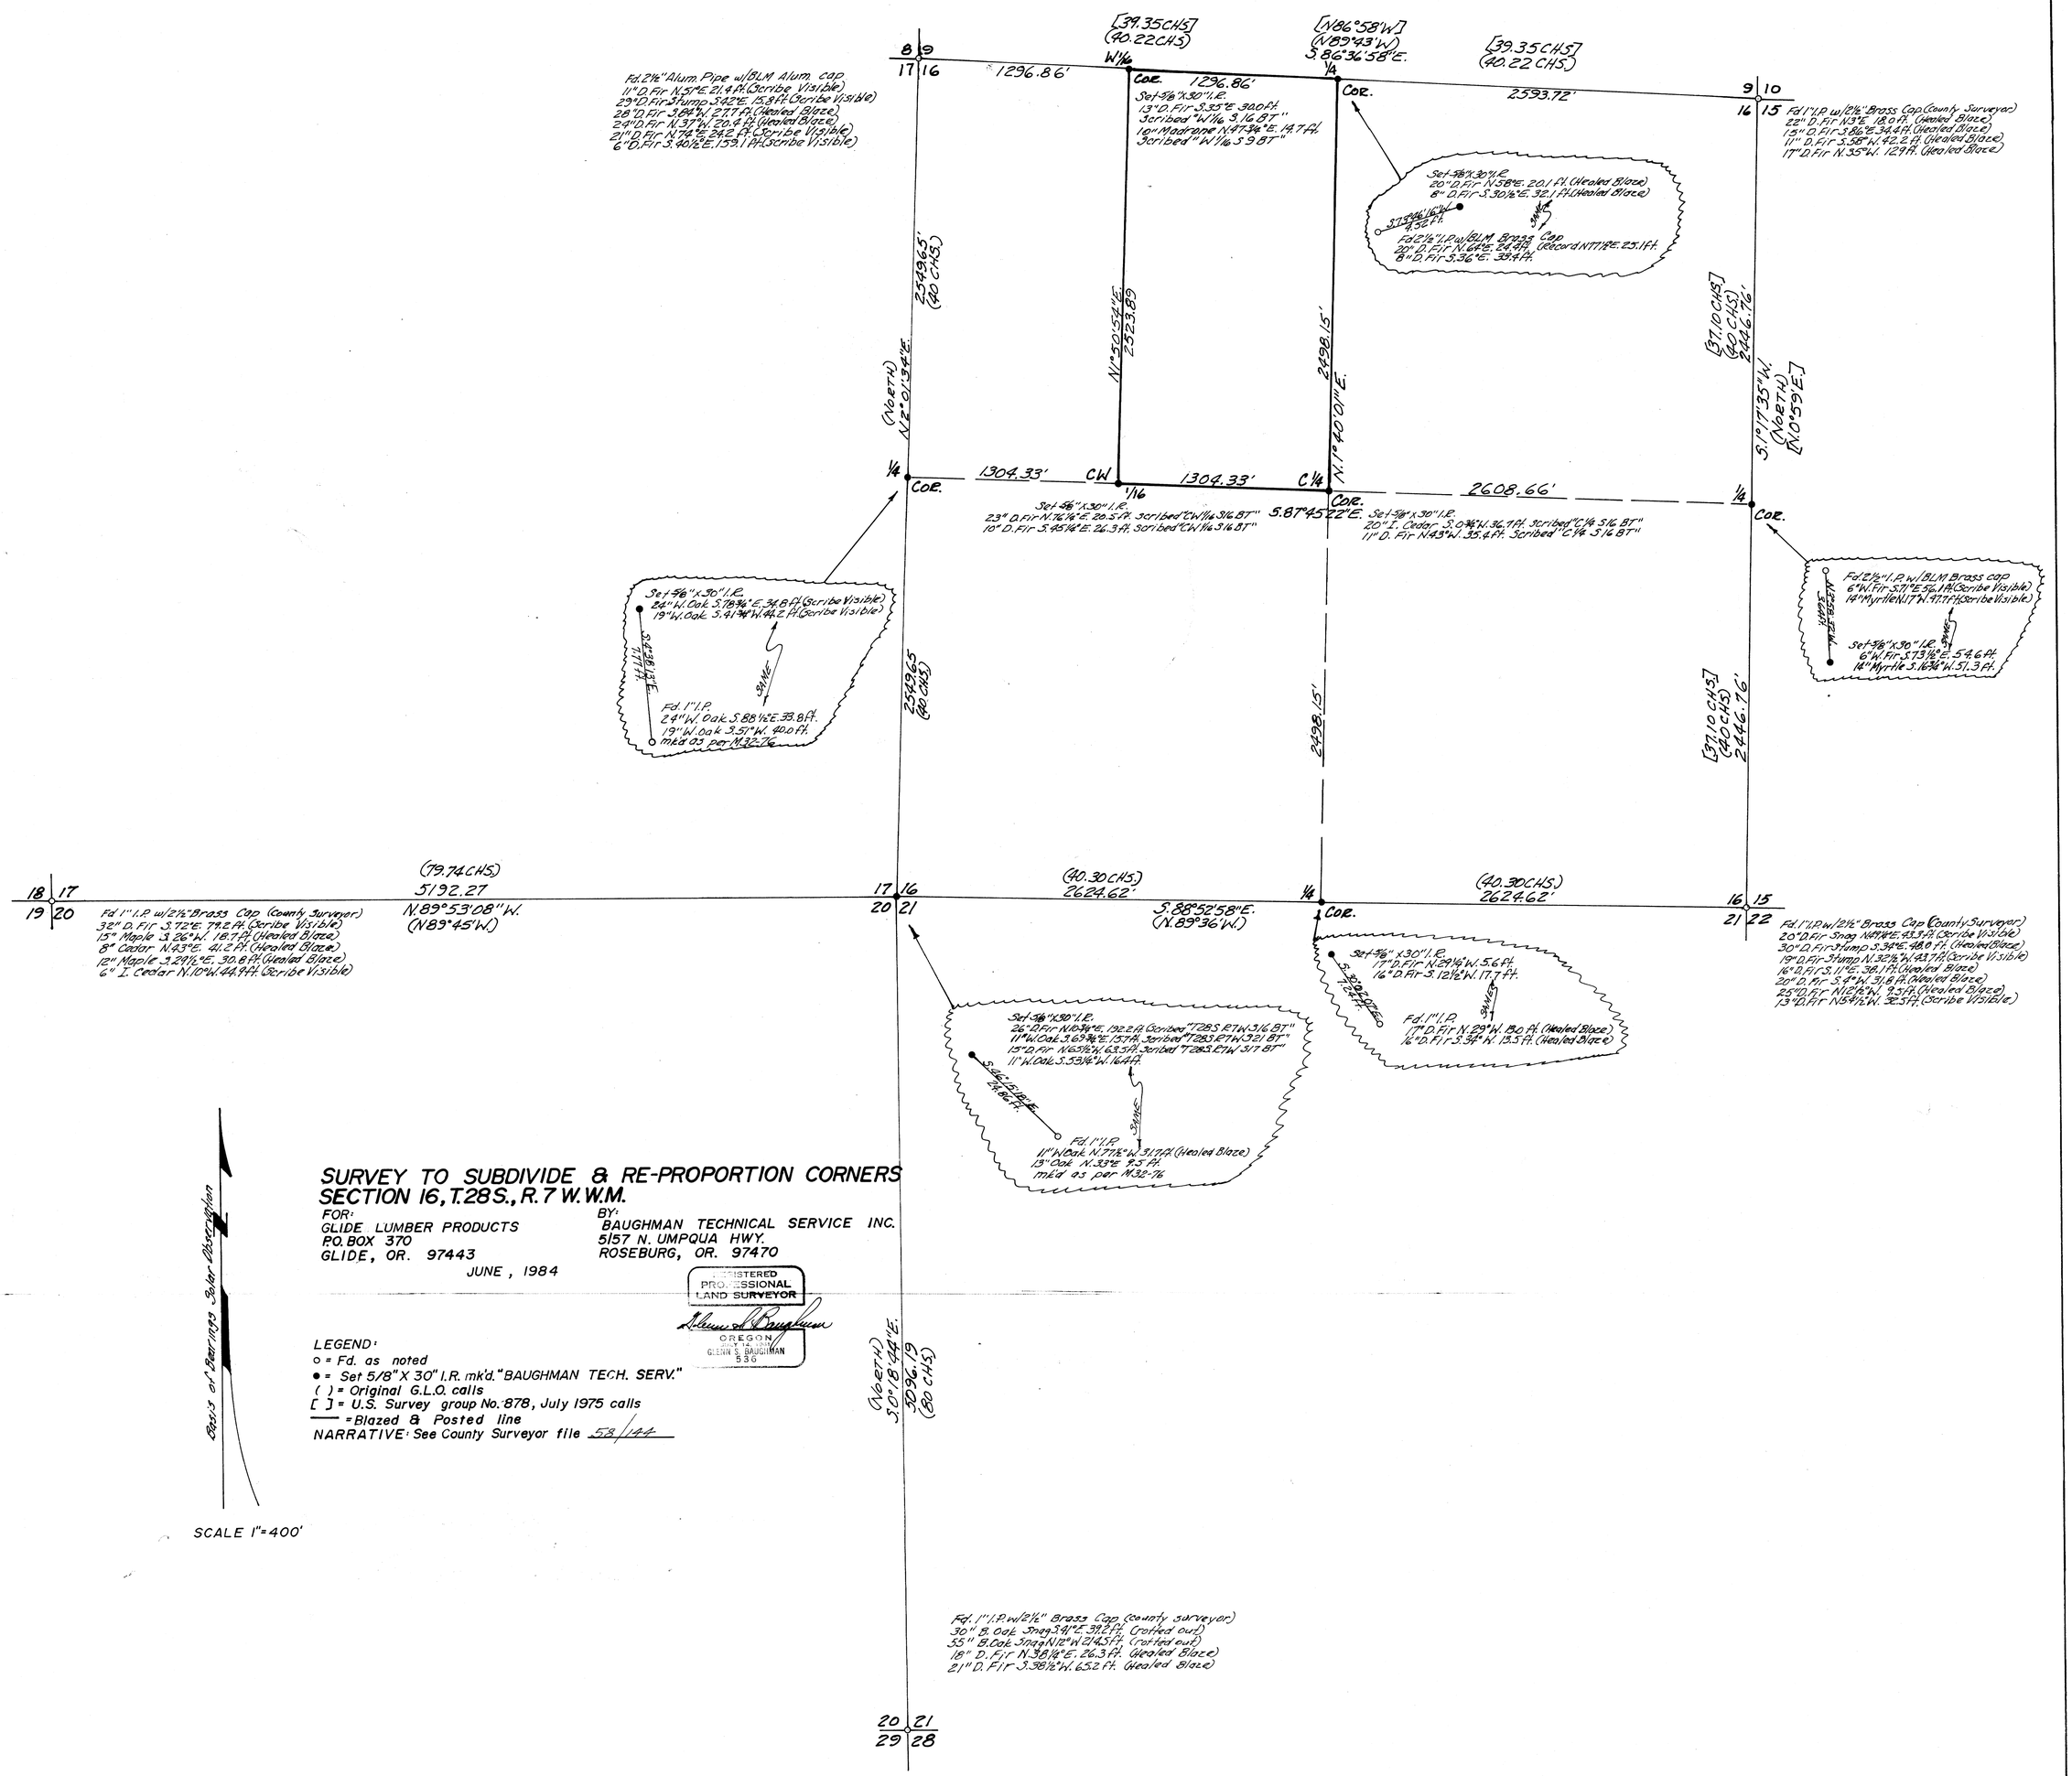

SURVEY TO SUBDIVIDE & RE-PROPORTION CORNERS
SECTION 16, T.28S., R.7 W.W.M.

FOR:
GLIDE LUMBER PRODUCTS
P.O. BOX 370
GLIDE, OR. 97443

BY:
BAUGHMAN TECHNICAL SERVICE INC.
5157 N. UMPQUA HWY.
ROSEBURG, OR. 97470

JUNE, 1984

REGISTERED PROFESSIONAL LAND SURVEYOR
OREGON JULY 14, 1978 GLENN S. BAUGHMAN 530

LEGEND:
o = Fd. as noted
● = Set 5/8" X 30" I.R. mk'd. "BAUGHMAN TECH. SERV."
( ) = Original G.L.O. calls
[ ] = U.S. Survey group No. 878, July 1975 calls
—— = Blazed & Posted line
NARRATIVE: See County Surveyor file 58/144

SCALE 1"=400'

C.S. File 58/144(N)
Map File R.M. 3-62