


PROPERTY SURVEY

Located in:
 SECTION 26, the EAST 1/2 of SECTION 27,
 the EAST 1/2 of SECTION 34,
 the NORTH 1/2 of SECTION 35,
 and the SOUTHEAST 1/4 of SECTION 35,
 TOWNSHIP 28 SOUTH, RANGE 6 WEST,
 and in the:
 NORTHEAST 1/4 of SECTION 3,
 TOWNSHIP 29 SOUTH, RANGE 6 WEST,
 WILLAMETTE MERIDIAN,
 DOUGLAS COUNTY, OREGON

JUNE 2006 - OCTOBER 2007
 SCALE: 1" = 400'

Prepared by:
 COW CREEK BAND of the
 UMPQUA TRIBE of INDIANS
 2371 N.E. STEPHENS ST., SUITE 100
 ROSEBURG, OREGON 97470

Prepared by:
 RAYMOND F. BROWN - P.L.S. # 2391
 P.O. BOX 539
 CANYONVILLE, OREGON 97417
 Phone: (541) 839-6185

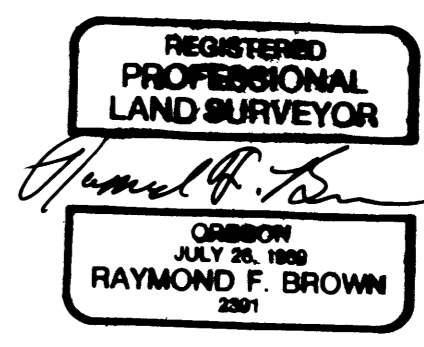

EXP. 12/31/07

ROUND PRARIE
 926.42 ± ACRES

NARRATIVE:

PURPOSE OF THE SURVEY WAS TO DEFINE THE PROPERTY AS SHOWN. FIELD INVESTIGATION LOCATED THE SAID FOUND MONUMENTS AND CONDITIONS. THE WEST BOUNDARY AND THE WESTERLY HALF OF THE NORTH BOUNDARY WAS CONTROLLED BY SURVEY MAP FILE NUMBER RM 2-44 AND THE EXISTING FENCE ALONG THE SAID BOUNDARIES (BOTH MATCH EACH OTHER WELL). THE EASTERLY PORTION OF THE NORTH BOUNDARY WAS CONTROLLED BY THE ACTUAL CENTER OF ROBERTS MOUNTAIN ROAD (THEN OFFSET 30 FOOT TO THE SOUTH FOR THE RIGHT OF WAY BOUNDARY) AND BY FOUND MONUMENTS PER MINOR LAND PARTITION MAP FILE NUMBER 1992-0032. THE EASTERLY BOUNDARY OF THE SURVEY WAS CONTROLLED BY SURVEY FILE NUMBERS M 134-19 AND C.S. 58/103-8. THE WESTERLY RIGHT OF WAY BOUNDARY OF U.S. INTERSTATE HIGHWAY NUMBER 5, AND BY THE WESTERLY RIGHT OF WAY BOUNDARY OF COUNTY ROAD NUMBER 123 (30 FOOT WESTERLY OF THE ACTUAL CENTER LINE) AND THE SOUTHERLY BOUNDARY WAS CONTROLLED BY THE RIGHT OF WAY BOUNDARIES FOR SOUTHERN PACIFIC RAILROAD (DEFINED BY ACTUAL PLACEMENT) AND BY THE NORTH BANK OF THE SOUTH UMPQUA RIVER. THE CALCULATED TIE FROM THE 1/4 CORNER COMMON TO SECTION 34, TOWNSHIP 28 SOUTH, RANGE 6 WEST AND FOR SECTION 3, TOWNSHIP 29 SOUTH, RANGE 6 WEST TO THE SECTION CORNER COMMON TO SECTIONS 22, 23, 26 AND 27, TOWNSHIP 28 SOUTH, RANGE 6 WEST, AS DEFINED AND COMPUTED FROM SURVEY MAP FILE NUMBER RM 2-44, WAS USED AS "BASIS OF BEARING".

NOTE:
 ALL FENCES ARE ON OR NEAR THE PROPERTY LINES.

LINE INDEX:

- ① S 19° 38' 02" E 89.42' (S 19° 38' 02" E 89.46') - 1
- ② S 31° 57' 17" E 100.2' (S 31° 57' 17" E 100.7') - 1
- ③ S 45° 59' 22" E 115.56' (S 45° 59' 22" E 116.62') - 1
- ④ S 57° 45' 14" E 94.64' (S 57° 45' 14" E 94.69') - 1
- ⑤ S 69° 59' 11" E 102.78' (S 69° 59' 11" E 102.83') - 1
- ⑥ S 79° 44' 21" E 135.28' (S 79° 44' 21" E 135.35') - 1
- ⑦ S 86° 21' 58" E 157.30' (S 86° 21' 58" E 157.38') - 1
- ⑧ N 77° 44' 40" E 216.49' (N 77° 44' 40" E 216.60') - 1
- ⑨ N 62° 21' 15" E 136.62' (N 62° 21' 15" E 136.69') - 1
- ⑩ N 41° 55' 38" E 115.64' (N 41° 55' 38" E 115.90') - 1
- ⑪ N 79° 49' 28" E 168.38' (N 79° 49' 28" E 168.46') - 1
- ⑫ N 61° 18' 33" E 184.14' (N 61° 18' 33" E 184.23') - 1
- ⑬ N 42° 00' 20" E 184.81' (N 42° 00' 20" E 184.90') - 1
- ⑭ N 59° 24' 09" E 123.32' (N 59° 24' 09" E 123.38') - 1

LEGEND:

- FD. GOVERNMENT MONUMENTS AS NOTED.
- FD. 5/8" IRON ROD PER 1992-0032.
- FD. 1-1/2" IRON PIPE PER 1992-0032.
- FD. 5/8" IRON ROD PER M 134-19.
- FD. 5/8" IRON ROD PER M 112-56.
- FD. 5/8" IRON ROD PER M 147-12.
- FD. 5/8" IRON ROD PER STATE R/W.
- FD. 1/2" IRON ROD PER M 112-56.
- FD. 3/4" IRON PIPE PER C.S. 58/103-8.
- SET 5/8" X 30" IRON ROD WITH PLASTIC CAP ATTACHED, MKD. "R. BROWN, PLS 2391".
- () RECORD AS PER RM 2-44.
- () RECORD AS PER VOLUME 3, PAGE 44.
- () RECORD AS PER 1992-0032.
- () RECORD AS PER M 134-19.
- () RECORD AS PER M 147-12.
- () RECORD AS PER M 123-70.
- () RECORD AS PER STATE R/W.
- () RECORD AS PER C.S. 58/103-8.
- () RECORD AS PER M 112-56.