LOCATION HORIZONTAL CONTROL SURVEY AND RECOVERY MAP

SURVEYORS FILE DATA
NOT REMOVE FROM OFFICE

FOR THE OREGON DEPARTMENT OF TRANSPORTATION

In the NW1/4 and the NE1/4 of Section 22
The SE1/4 and the NE1/4 of Section 15
The SW1/4 and the NW1/4 and the NE1/4 of Section 14
The SE1/4 of Section 11
And the SW1/4 of Section 12
T 22 S, R 7 W, WM Douglas County, Oregon

Note: Coordinates Are Assumed

Scale: 1" = 200'

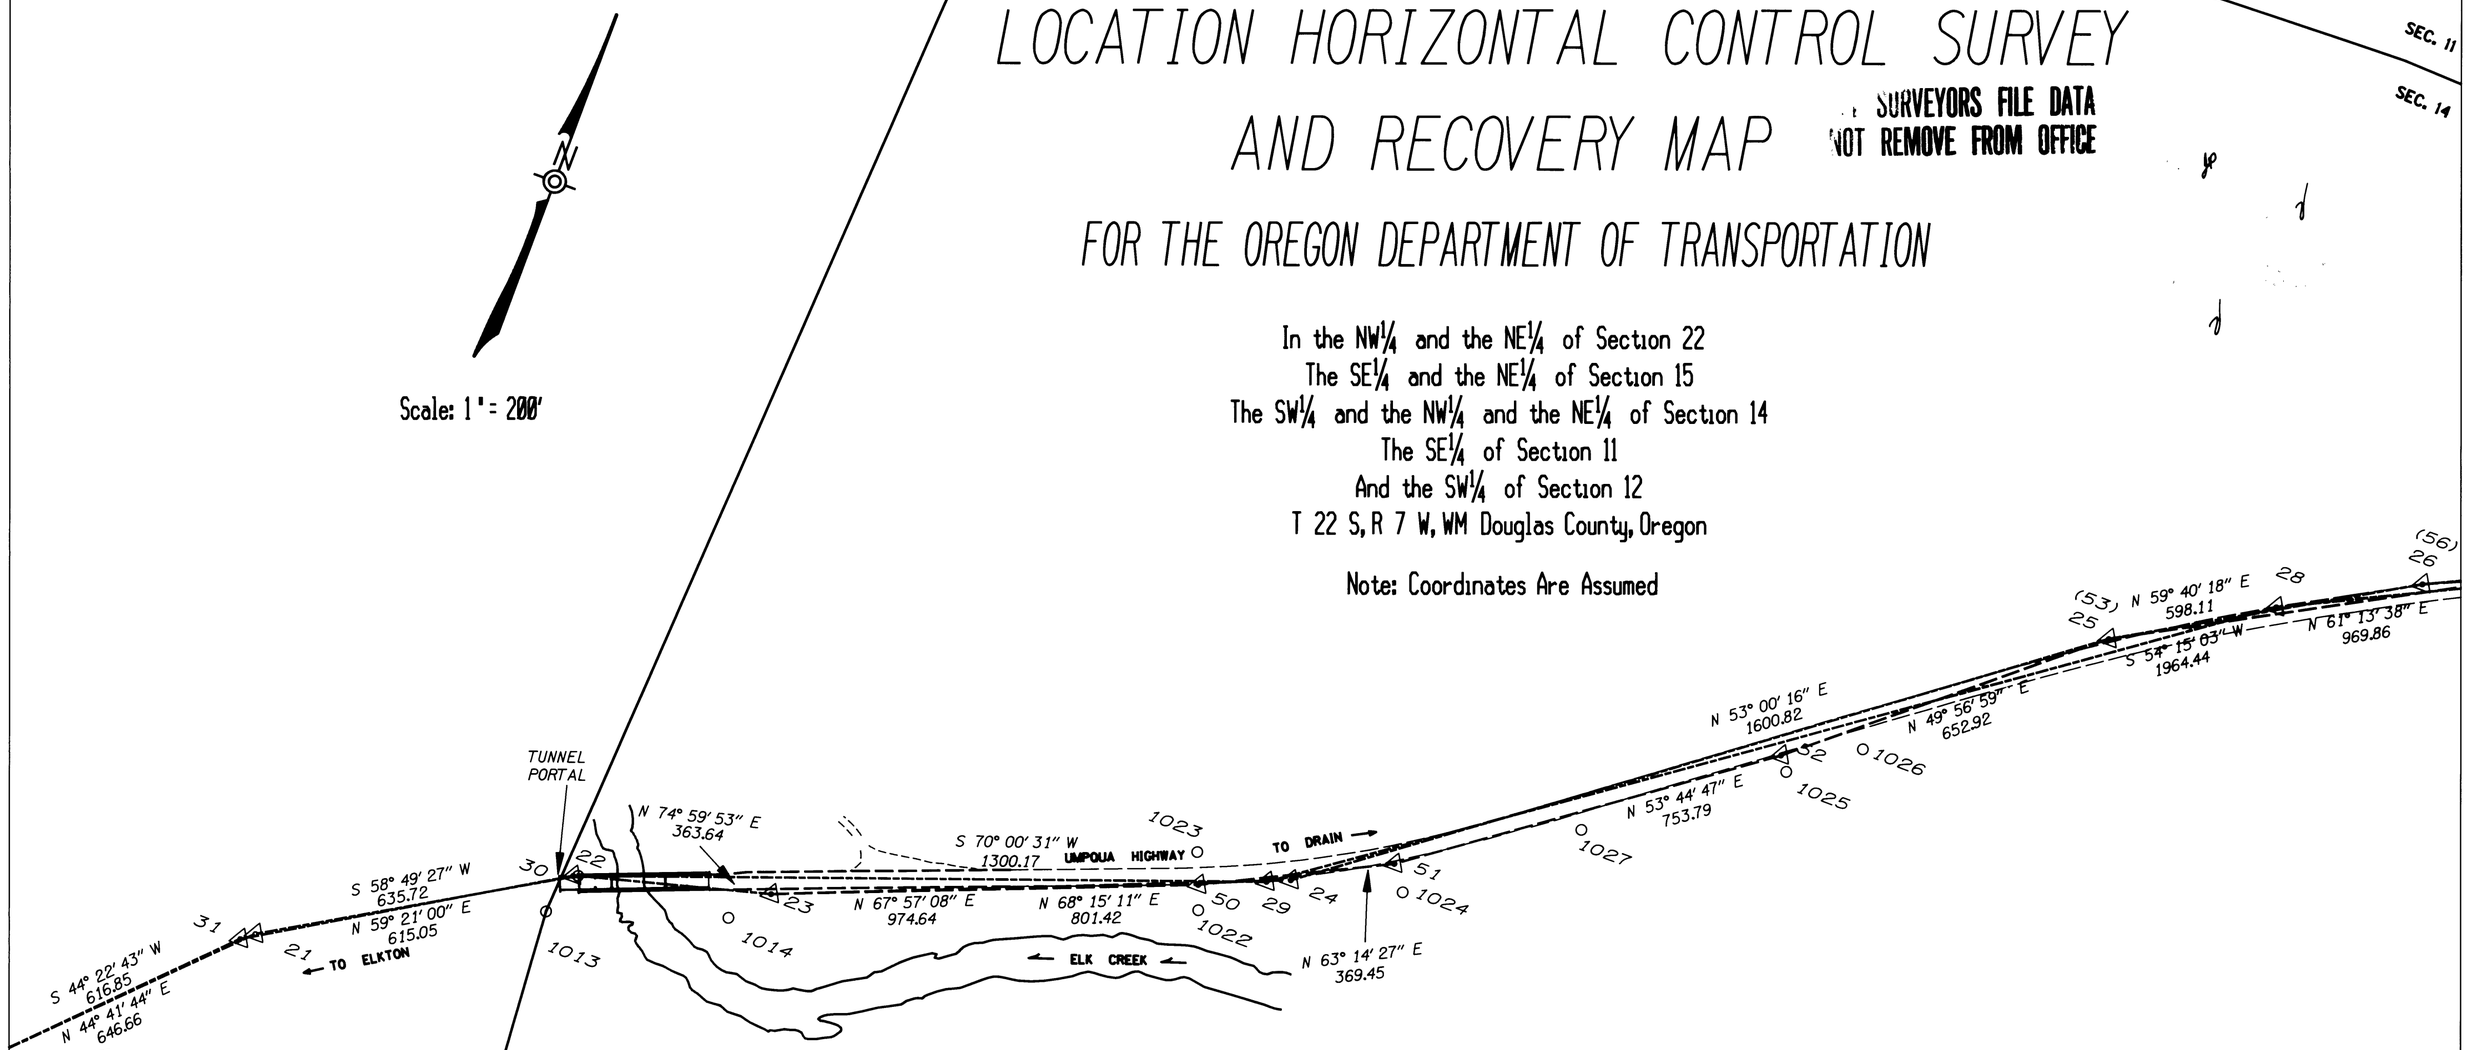

OREGON DEPARTMENT OF TRANSPORTATION
3099 N.E. DIAMOND LAKE BLVD., ROSEBURG, OR 97470

ELK CREEK - BRUSH CREEK (TUNNEL)
HORIZONTAL CONTROL MAP

COUNTY: DOUGLAS — HIGHWAY: DRAIN - ELKTON
COORDINATES: ASSUMED — EA: C0101807
BEARINGS: ODOT R/W Map 4B-16-12 — KEY NO.: 03470
DESIGNER: BOB PAPPE — PROJECT MANAGER: ROGER E. PATITZ, P.L.S.
CADD FILE LOCATION: R3220: /usr/r3/projects/03470/03470cm.dgn
SCALE: ONE INCH EQUALS 200 FEET
JULY 1992

REGISTERED PROFESSIONAL LAND SURVEYOR
OREGON
JULY 11, 1989
ROGER E. PATITZ
906

SYMBOL LEGEND	
△	SET TRAVERSE POINT AS NOTED IN TABLE
○	FOUND MONUMENT AS NOTED IN TABLE
———	Control Traverse
.....	Secondary Traverses

MAP FILE M.115-38.1B

/usr/r3/projects/03470/03470cm.dgn Jul. 17, 1992 08:57:00

ST. HWY. 38-001B