SE 1/4 SECTION 13 T22S R10W WM   SW 1/4 SECTION 18 T22S R9W WM

FILED
Date: 2-22-2024 By: [illegible]
This survey consists of:
Map: ST. HWY 38-031 A-G
Narrative:
Corner Rpt:
DOUGLAS COUNTY SURVEYOR

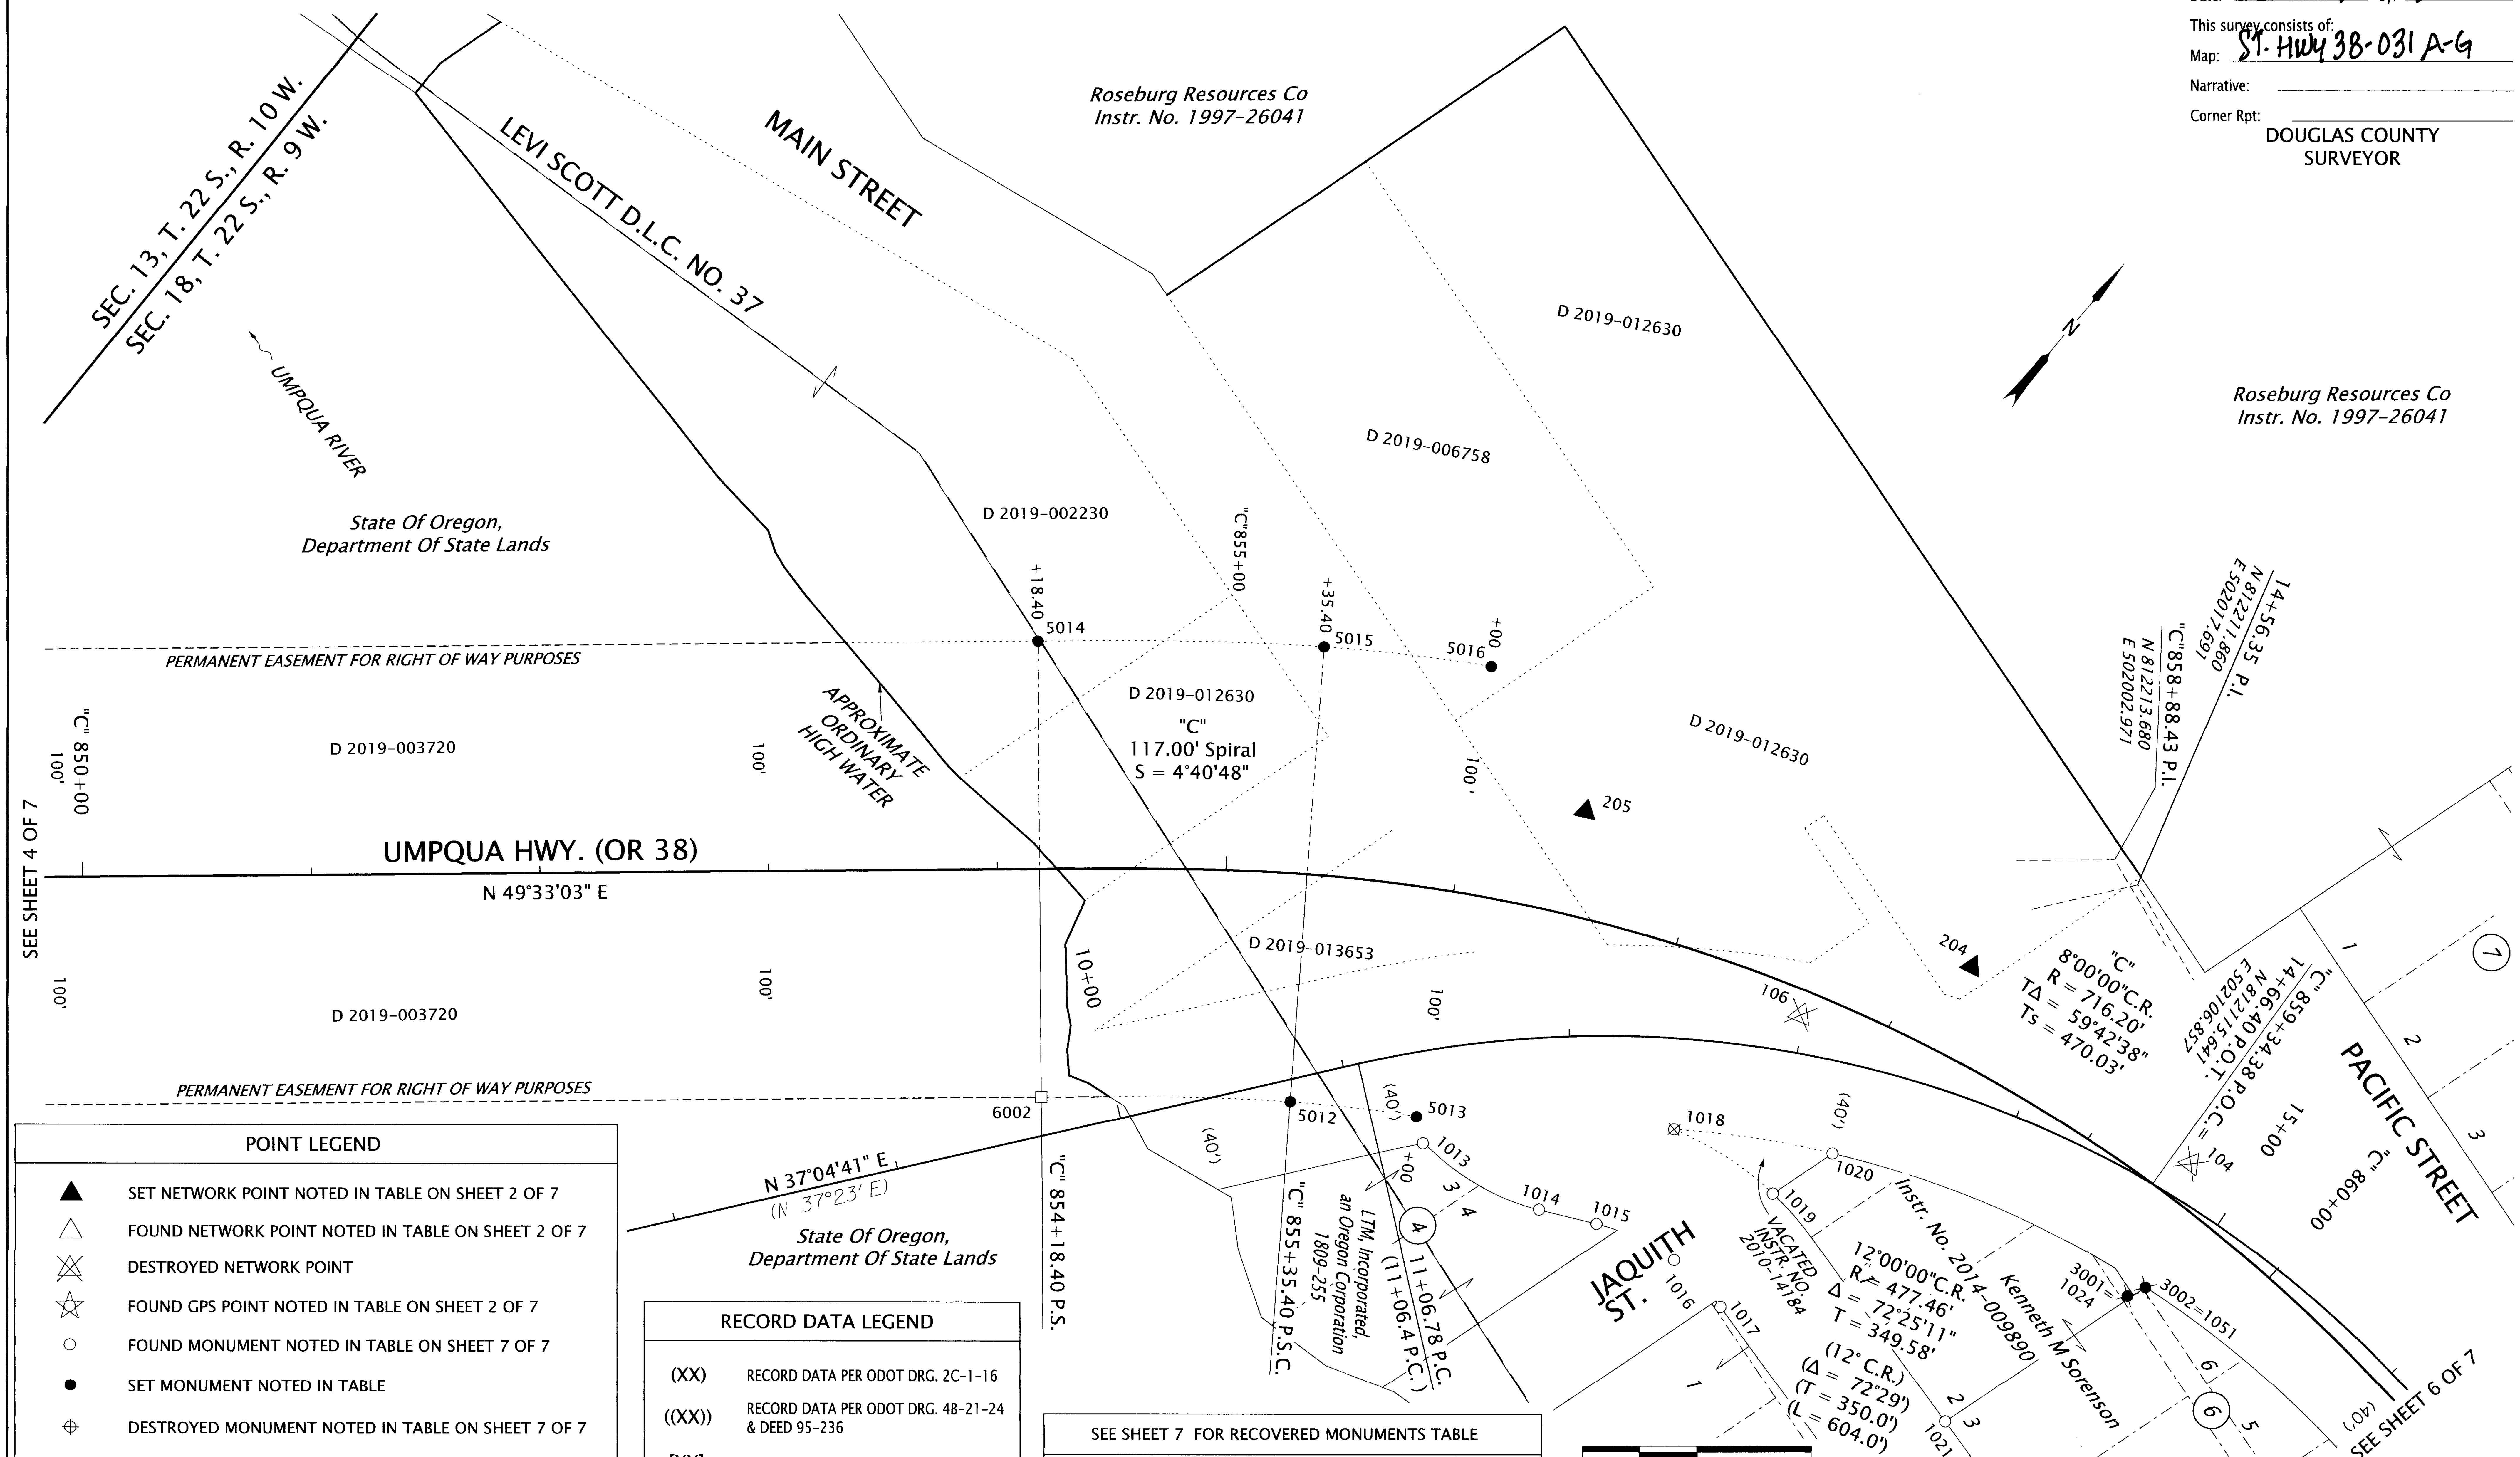

POINT LEGEND	
▲	SET NETWORK POINT NOTED IN TABLE ON SHEET 2 OF 7
△	FOUND NETWORK POINT NOTED IN TABLE ON SHEET 2 OF 7
☒	DESTROYED NETWORK POINT
☆	FOUND GPS POINT NOTED IN TABLE ON SHEET 2 OF 7
○	FOUND MONUMENT NOTED IN TABLE ON SHEET 7 OF 7
●	SET MONUMENT NOTED IN TABLE
⊕	DESTROYED MONUMENT NOTED IN TABLE ON SHEET 7 OF 7
✱	RESET MONUMENT NOTED IN TABLE

RECORD DATA LEGEND	
(XX)	RECORD DATA PER ODOT DRG. 2C-1-16
((XX))	RECORD DATA PER ODOT DRG. 4B-21-24 & DEED 95-236
[XX]	RECORD DATA PER ODOT DRG. 2B-24-20

SEE SHEET 7 FOR RECOVERED MONUMENTS TABLE

SEE SHEET 2 FOR CONTROL TABLE AND LINE LEGEND

SCALE BAR: 50' 25' 0 50' FEET

SET MONUMENT TABLE

RP = REFERENCE POINT FC = FALSE CALL

PT. NO.	STATION	OFFSET	OCRS NORTHING	OCRS EASTING	DATE	DESCRIPTION
3001	14+83.41	47.49	812071.17	502130.06	12/20/2023	SET 5/8" X 30" REBAR w/ 2" ALUMINUM CAP STAMPED "ODOT RESET" (RESET OF POINT 1024)
3002	14+88.42	40.11	812079.08	502133.61	12/20/2023	SET 5/8" X 30" REBAR w/ 2" ALUMINUM CAP STAMPED "ODOT RESET" (RESET OF POINT 1051)
5012	"C" 855+35.40	100.00	811901.03	501794.78	12/20/2023	SET 5/8" X 30" REBAR w/ 2" ALUMINUM CAP STAMPED "ODOT RP"
5013	"C" 856+00.00	100.00	811931.44	501841.28	12/20/2023	SET 5/8" X 30" REBAR w/ 2" ALUMINUM CAP STAMPED "ODOT FC"
5014	"C" 854+18.40	-100.00	811984.83	501580.41	12/20/2023	SET 5/8" X 30" REBAR w/ 2" ALUMINUM CAP STAMPED "ODOT RP"
5015	"C" 855+35.40	-100.00	812063.31	501677.87	12/20/2023	SET 5/8" X 30" REBAR w/ 2" ALUMINUM CAP STAMPED "ODOT RP"
5016	"C" 856+00.00	-100.00	812103.59	501739.46	12/20/2023	SET 5/8" X 30" REBAR w/ 2" ALUMINUM CAP STAMPED "ODOT FC"
6002	"C" 854+18.40	100.00	811832.64	501710.16	-	CALCULATED RIGHT OF WAY POINT, NO MONUMENT SET

REGISTERED PROFESSIONAL LAND SURVEYOR

OREGON
JULY 15, 2003
ANDREW DAVID AUSLAND
56136

EXPIRES: 12/31/2025

OREGON DEPARTMENT OF TRANSPORTATION

RIGHT-OF-WAY BOUNDARY MONUMENTATION MAP
OR38: UMPQUA RIVER (SCOTTSBURG) BRIDGE REPLACEMENT
UMPQUA HIGHWAY (MP 15.9 - MP 17.1)
DOUGLAS COUNTY

ODOT REGION 3 TECH CENTER
100 ANTELOPE ROAD
WHITE CITY, OREGON 97503
KEY NO. 18578

FEBRUARY 14, 2024
SCALE: 1" = 50'
SHEET 5 OF 7

ST. HWY. 38-031 E