COUNTY SURVEYORS FILE DATA
DO NOT REMOVE FROM OFFICE
MAP FILE M129-18B

FILED
Date: 10-19-1998 By: JP
This survey consists of: 2 Pgs.
Map: M129-18B
Narrative:
Corner Rpt:
DOUGLAS COUNTY SURVEYOR

RIGHT OF WAY MONUMENTATION MAP

BY THE OREGON DEPARTMENT OF TRANSPORTATION
FOR OLALLA CREEK BRIDGE TO HOOVER HILL ROAD SECTION
COOS BAY - ROSEBURG HIGHWAY #42
DOUGLAS COUNTY
(PAGE 2 OF 2)

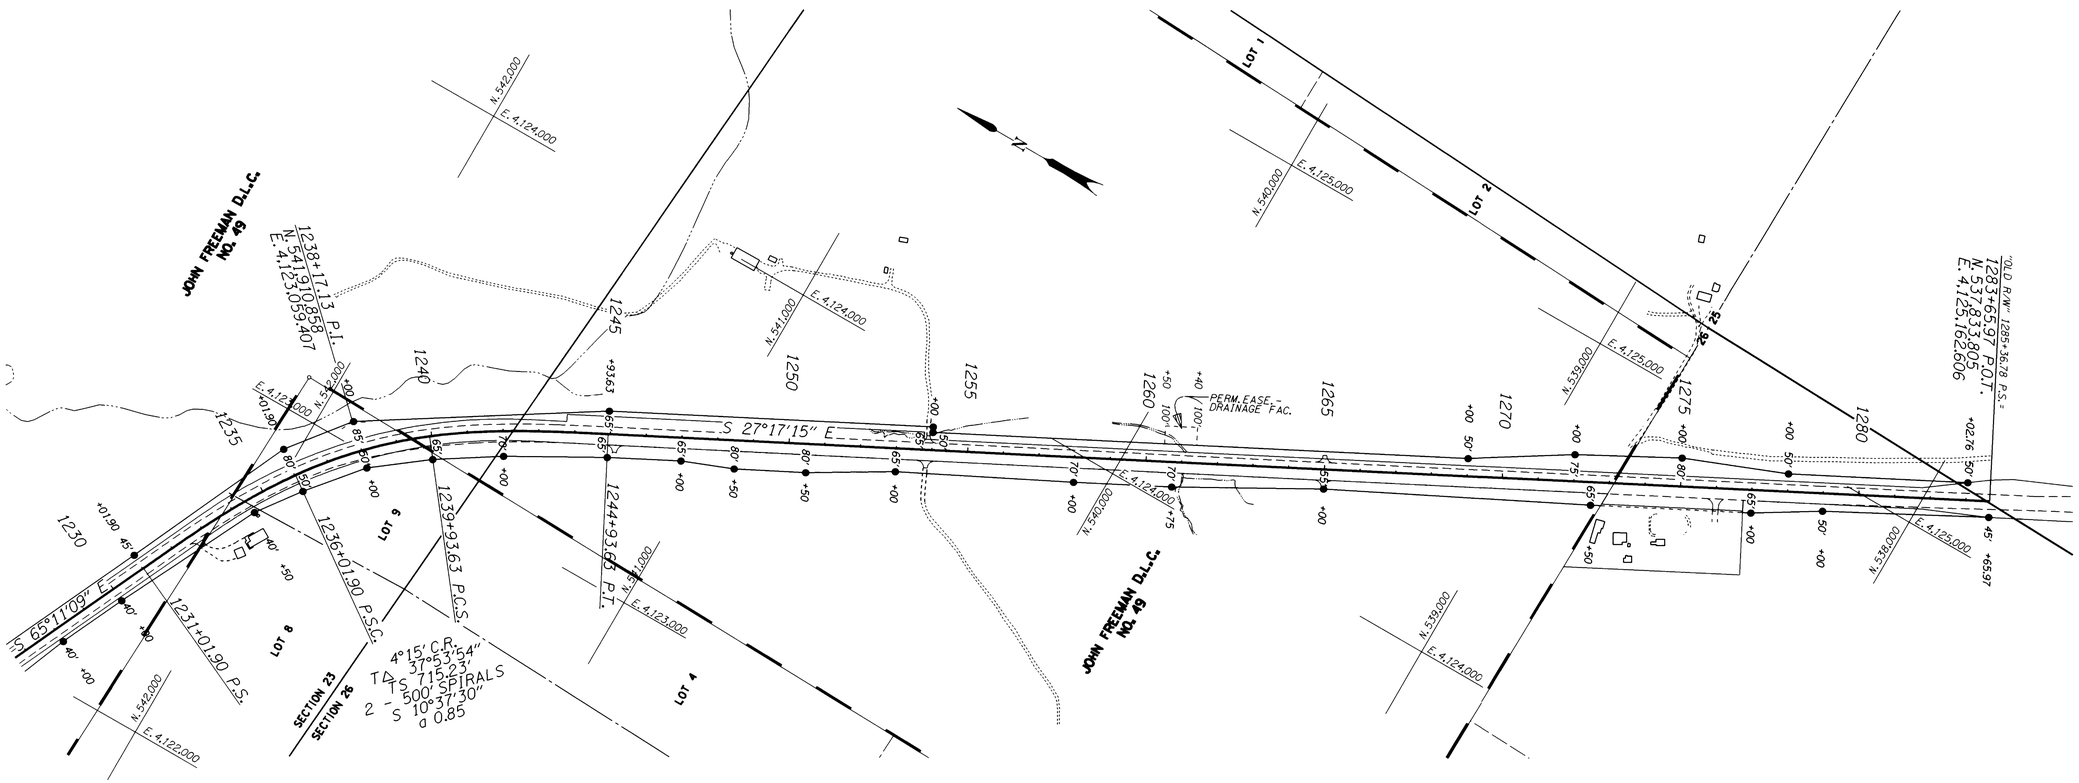

REGISTERED PROFESSIONAL LAND SURVEYOR
OREGON JANUARY 29, 1991
ROBERT G. PAPPE
2483
EXPIRES DEC. 31, 1998

LEGEND
- NEW CONST. & R/W ℄
- OLD R/W LINE
- NEW R/W LINE
- EASEMENT LINE
- R/W MONUMENT SET

SCALE 1 INCH = 200 FEET
0 100 200 400 800

OREGON DEPARTMENT OF TRANSPORTATION

RIGHT OF WAY MONUMENTATION MAP

COOS BAY-ROSEBURG HIGHWAY
DOUGLAS COUNTY

ADDRESS - 3500 STEWART PARKWAY, SUITE 140
ROSEBURG, OREGON 97470

CADD FILE: 06930RWM.DGN

ST. HWY. 42-003B

MAP FILE M129-18B