SE 1/4, NE 1/4, & NW 1/4, SEC. 21, T. 28 S., R. 6 W., W. M.

COUNTY SURVEYORS FILE DATA
DO NOT REMOVE FROM OFFICE

FILED
Date: 4-29-2002 By: JC
This survey consists of:
Map: ST HWY 42-007A-H
Narrative:
Corner Rpt:

DOUGLAS COUNTY SURVEYOR

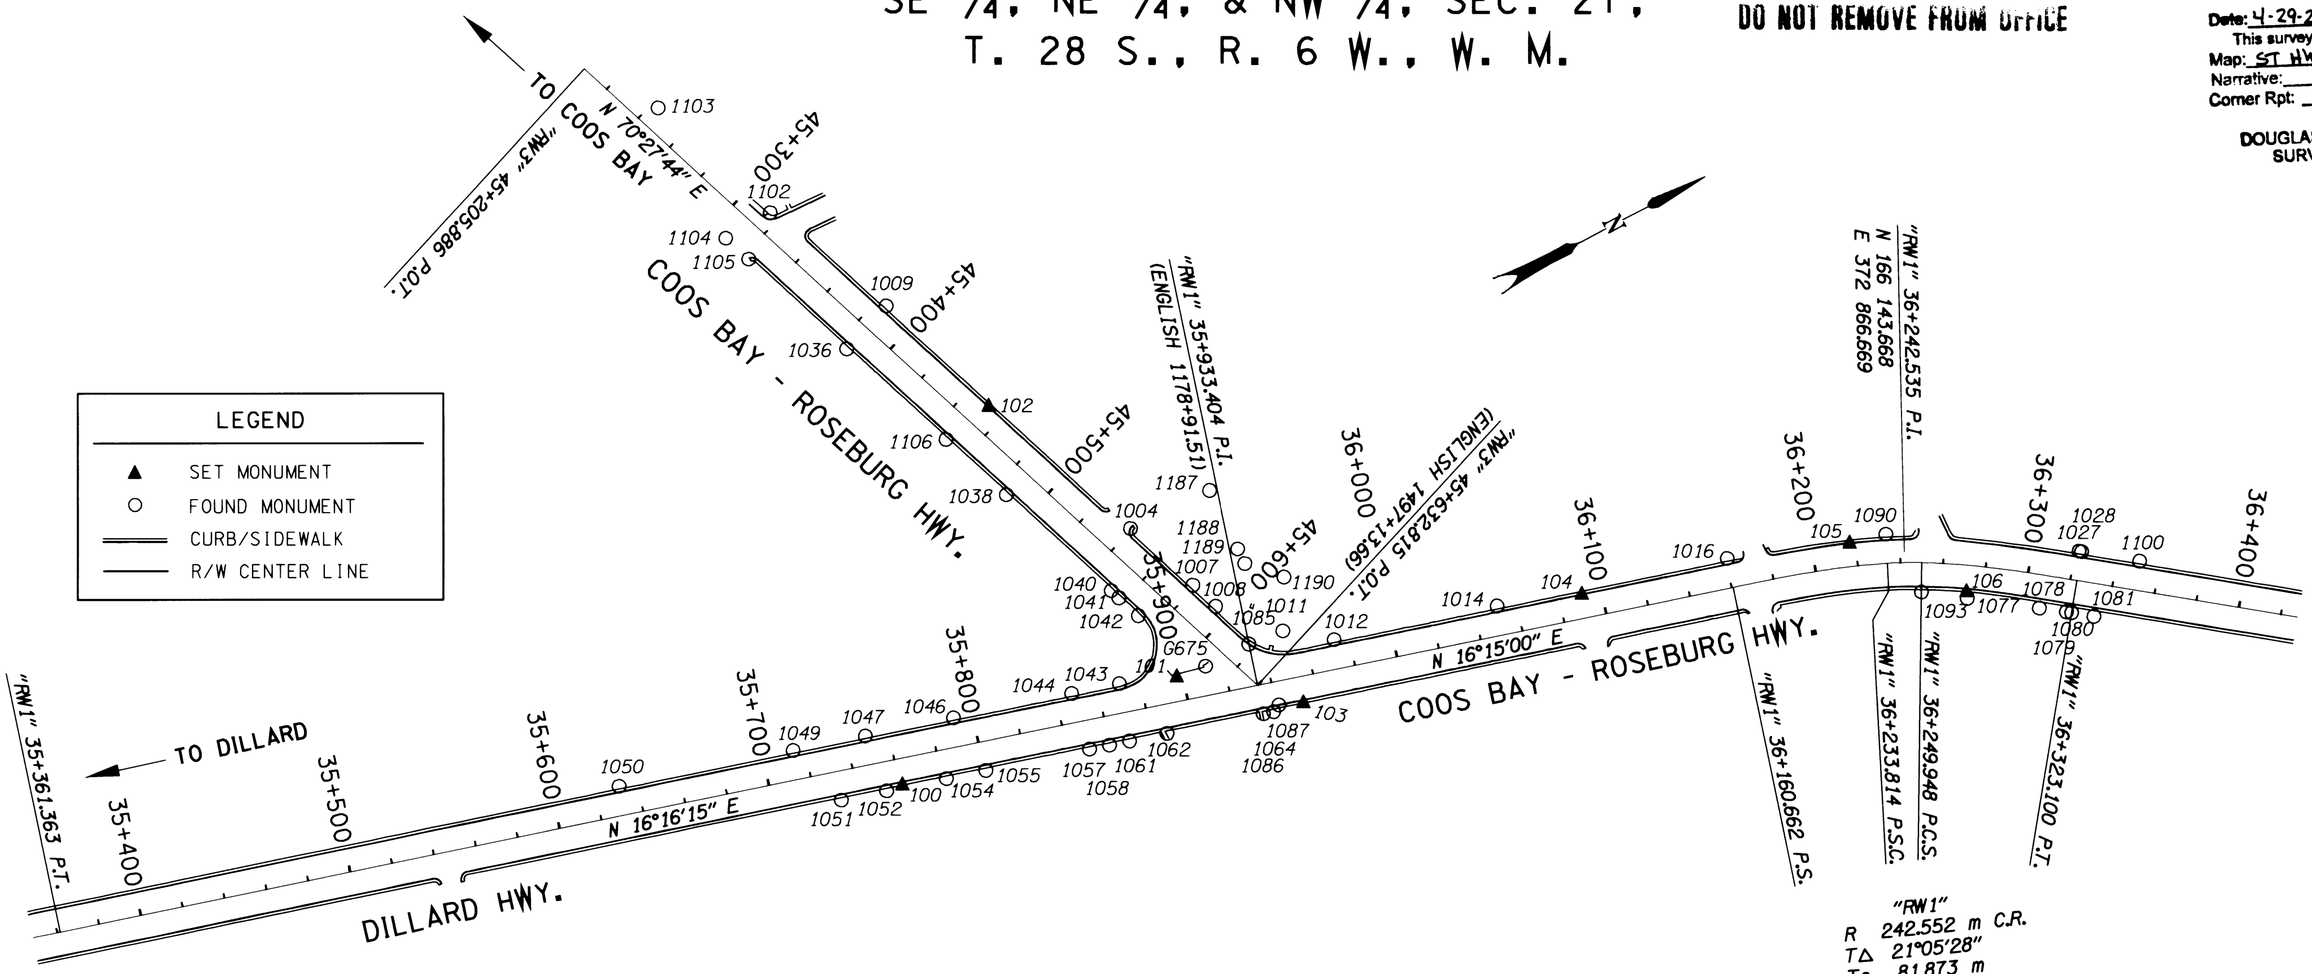

POINT ID	LDP NORTHING	LDP EASTING	DESCRIPTION
100	165678.530	372743.302	SET 29 mm BRASS DISK IN CONC. SIDEWALK STAMPED "ODOT CONTROL 100".
101	165815.696	372758.463	SET 29 mm BRASS DISK IN CONC. SIDEWALK STAMPED "ODOT CONTROL 101".
102	165797.349	372605.371	SET 29 mm BRASS DISK IN CONC. SIDEWALK STAMPED "ODOT CONTROL 102".
103	165862.408	372796.886	SET 29 mm BRASS DISK IN CONC. SIDEWALK STAMPED "ODOT CONTROL 103".
104	166001.330	372812.948	SET 29 mm BRASS DISK IN CONC. SIDEWALK STAMPED "ODOT CONTROL 104".
105	166123.306	372850.397	SET 29 mm BRASS DISK IN CONC. SIDEWALK STAMPED "ODOT CONTROL 105".
106	166161.042	372896.211	SET 29 mm BRASS DISK IN CONC. SIDEWALK STAMPED "ODOT CONTROL 106".
1004	165828.775	372687.518	FOUND 1 1/4" BRASS CAP FLUSH IN CONC. CURB IN GOOD CONDITION. (REF. SURVEY *M74-37)
1007	165842.017	372724.612	FOUND 3/4" IRON ROD 50 mm ABOVE SURFACE. (REF. SURVEY *M74-37)
1008	165846.897	372738.336	FOUND 1 1/2" ALUM. CAP STAMPED "OREG. STATE HWY. DIV." 150 mm BELOW SURFACE IN GOOD CONDITION. R/W STA. 1495+84.13, 45.0 FT. LT.
1009	165776.890	372541.893	FOUND 1 1/2" ALUM. CAP STAMPED "OREG. STATE HWY. DIV. R/W 50.0". (STA. 1489+00, 50 FT. LT.)
1011	165869.376	372763.206	FOUND 1" PIN 340 mm BELOW SURFACE IN GOOD CONDITION. (REF. JUNCTION SUBD., VOL. 6, PG. 18)
1012	165888.615	372778.047	FOUND 1 1/2" ALUM. CAP STAMPED "OREG. STATE HWY. DIV." 20 mm BELOW SURFACE IN GOOD CONDITION.
1014	165963.324	372799.827	FOUND 5/8" IRON REBAR FLUSH WITH SURFACE IN GOOD CONDITION. (REF. SURVEY *M71-26)
1016	166068.942	372830.602	FOUND 1 1/2" ALUM. CAP STAMPED "OREG. STATE HWY. DIV." IN ASPHALT CONC. IN GOOD CONDITION.
1027	166216.113	372904.708	FOUND 5/8" IRON REBAR FLUSH WITH SURFACE IN GOOD CONDITION. (REF. SURVEY *M81-32)
1028	166217.101	372905.464	FLUSH 1 1/2" ALUM. CAP STAMPED "OREG. STATE HWY. DIV. 1191+70.29 45.0" FLUSH WITH ASPHALT CONC. IN GOOD CONDITION.

REGISTERED
PROFESSIONAL
LAND SURVEYOR
Christine V. Blevins
OREGON
JULY 19, 1994
CHRISTINE V. BLEVINS
2669
EXPIRES: DEC. 31, 2003

SCALE 1:2000 METERS
0 20 40 80 160

METRIC SURVEY
1 METER = 3937 U.S. FEET / 1200
TO CONVERT A METRIC DISTANCE DIVIDE BY 0.30480061

OREGON DEPARTMENT OF TRANSPORTATION

HORIZONTAL CONTROL, RECOVERY, AND RETRACEMENT MAP

WINSTON - INTERSTATE 5
COOS BAY - ROSEBURG HWY.
DOUGLAS COUNTY

3500 STEWART PARKWAY, SUITE 140
ROSEBURG, OREGON 97470

APRIL 23, 2002
PROJECT KEY *09841

ST. HWY. 42-007B