COUNTY SURVEYORS FILE DATA
DO NOT REMOVE FROM OFFICE

NE 1/4, SE 1/4, & SW 1/4 SEC. 11, T. 28 S., R. 6 W., W. M.

FILED
Date: 4-29-2002 By: JC
This survey consists of:
Map: ST HWY 42-007A-H
Narrative:
Corner Rpt:
DOUGLAS COUNTY
SURVEYOR

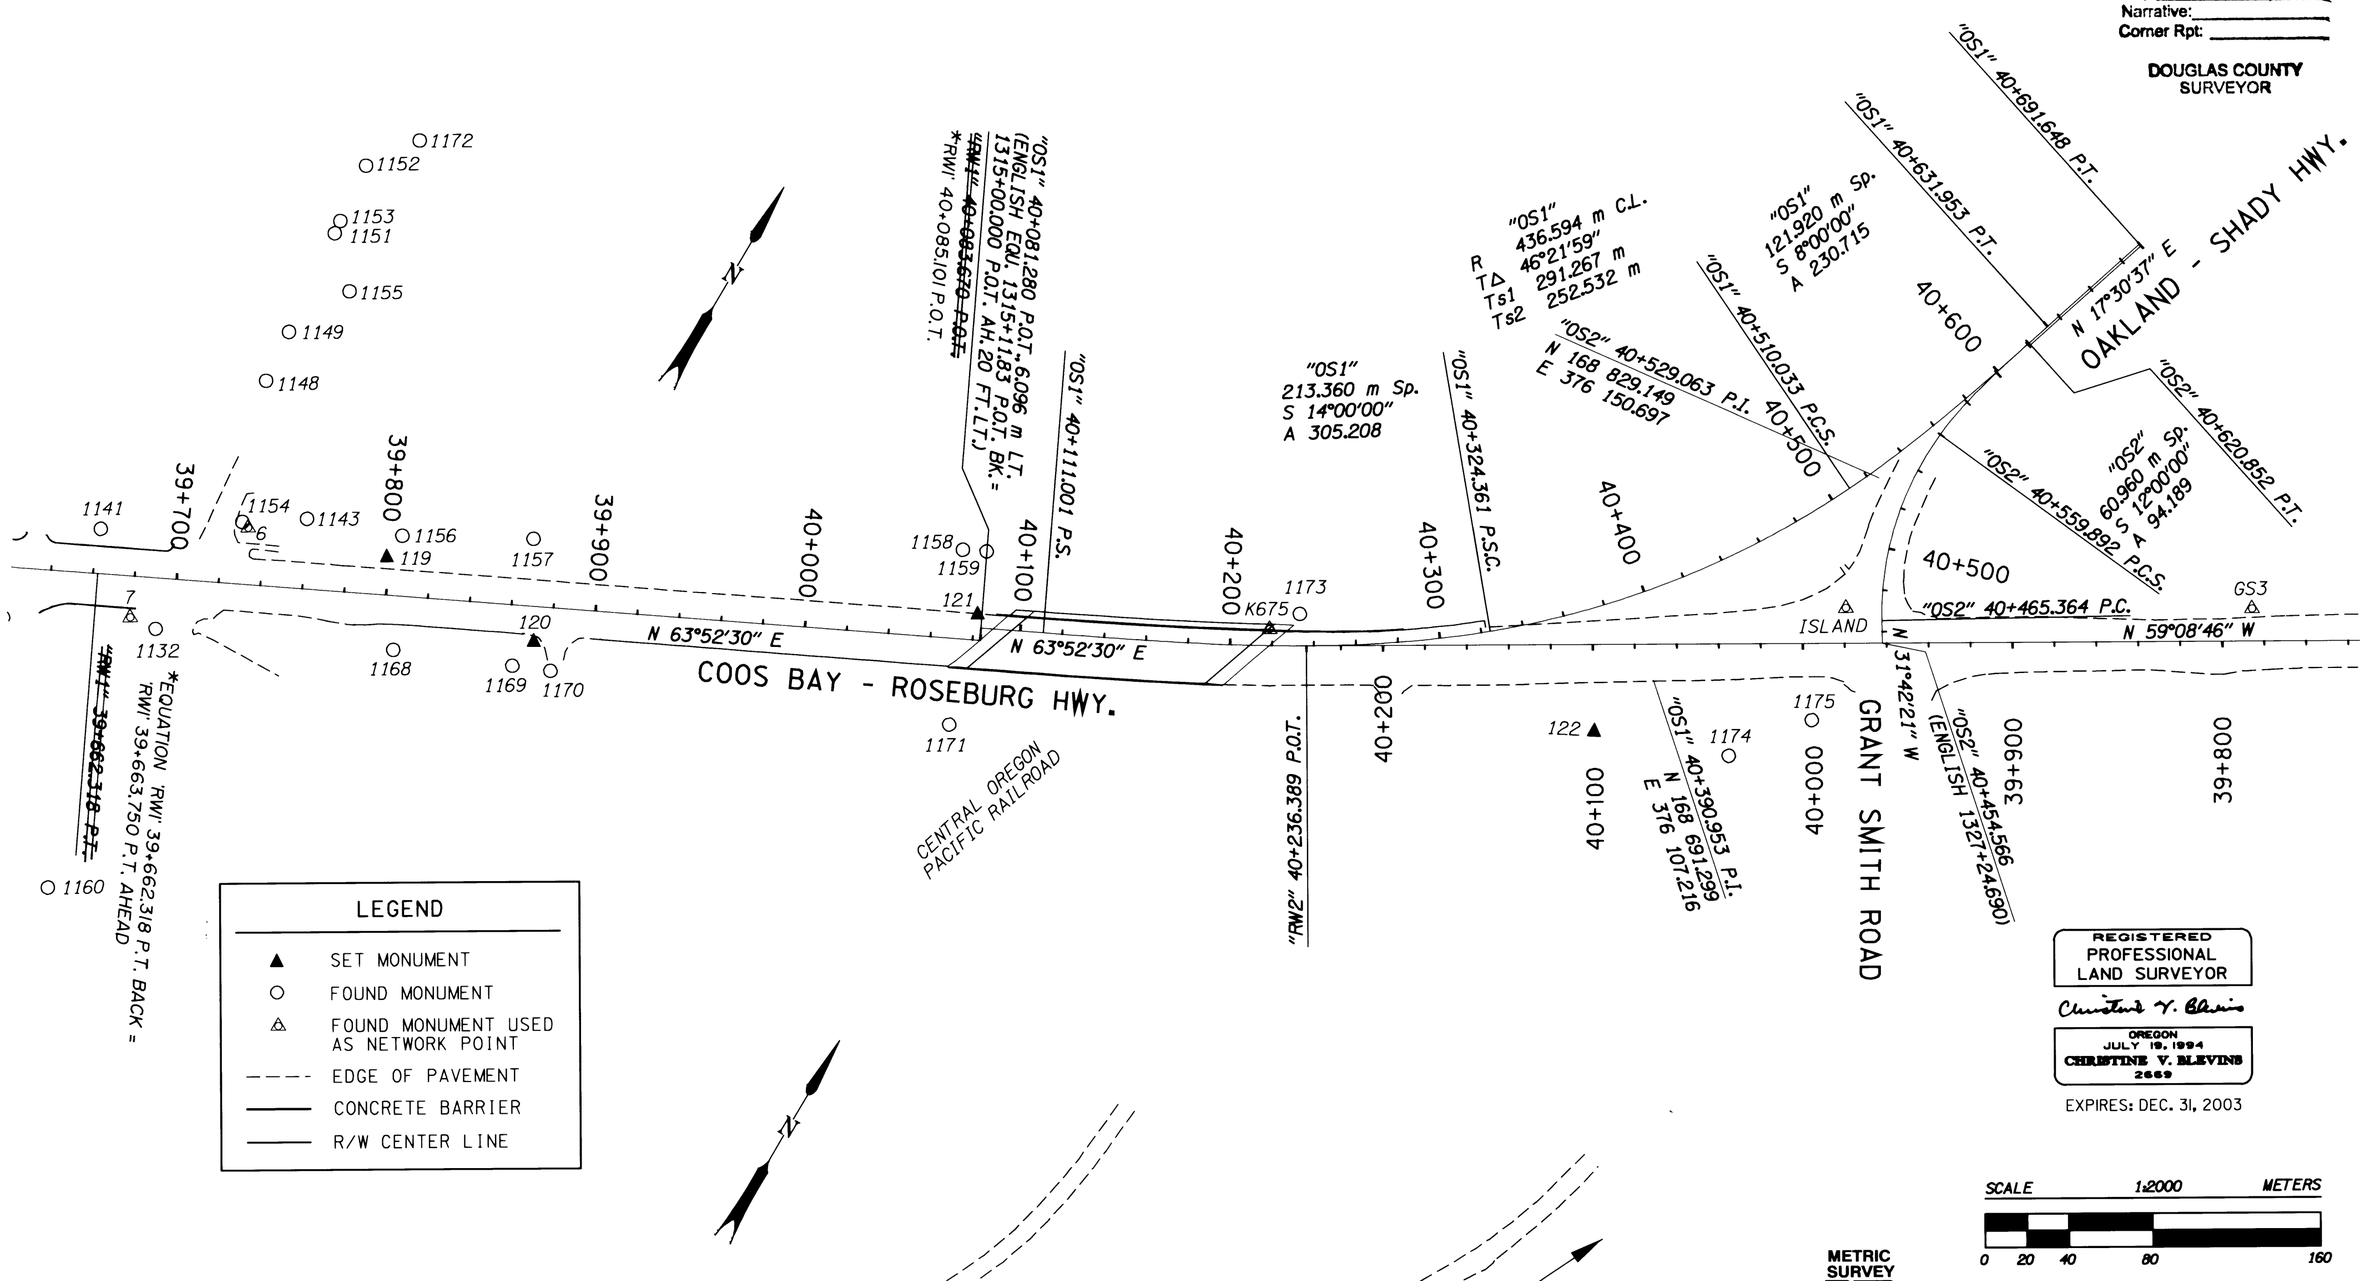

LEGEND

- ▲ SET MONUMENT
- ○ FOUND MONUMENT
- △ FOUND MONUMENT USED AS NETWORK POINT
- EDGE OF PAVEMENT
- CONCRETE BARRIER
- R/W CENTER LINE

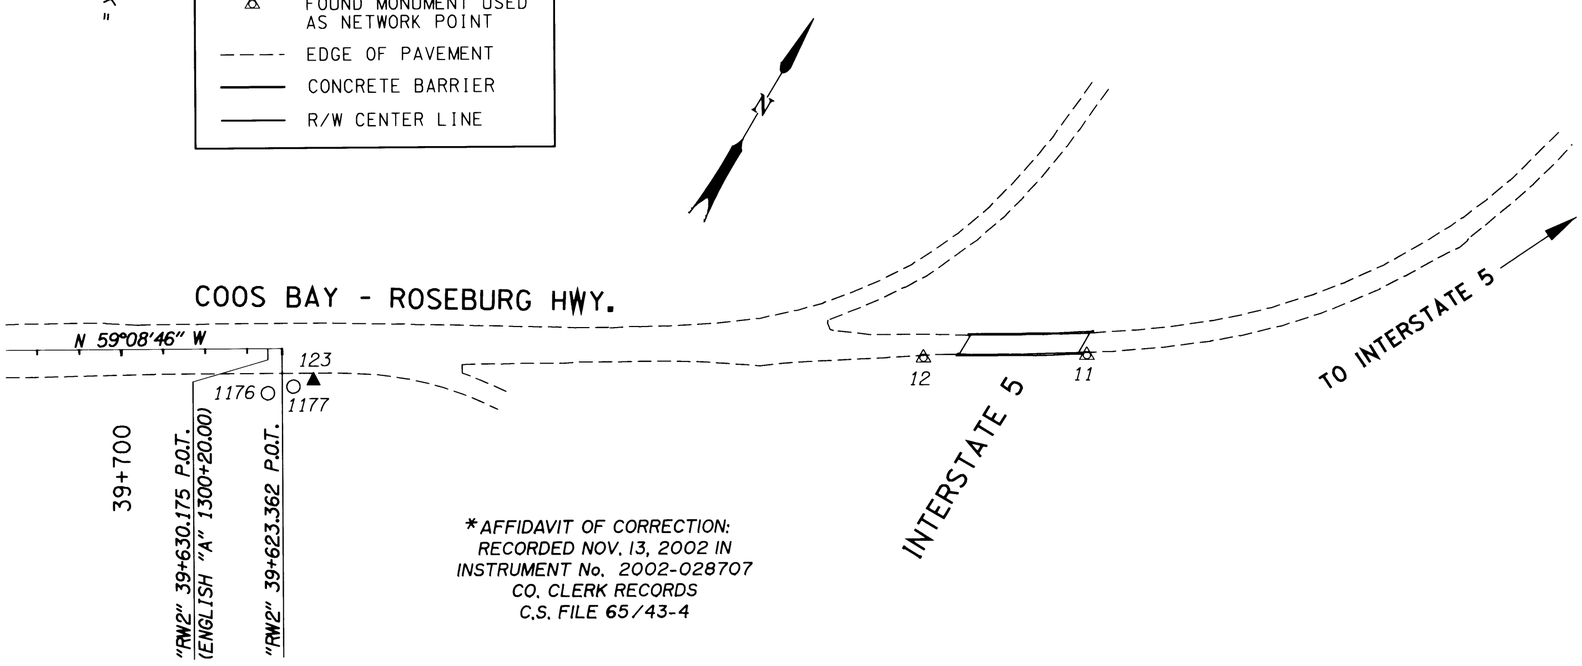

*AFFIDAVIT OF CORRECTION:
RECORDED NOV. 13, 2002 IN
INSTRUMENT No. 2002-028707
CO. CLERK RECORDS
C.S. FILE 65/43-4

REGISTERED
PROFESSIONAL
LAND SURVEYOR
Christine V. Blevins
OREGON
JULY 19, 1994
CHRISTINE V. BLEVINS
2669
EXPIRES: DEC. 31, 2003

SCALE 1:2000 METERS
0 20 40 80 160

METRIC SURVEY
1 METER = 3937 U.S. FEET / 1200
TO CONVERT A METRIC DISTANCE DIVIDE BY 0.30480061

OREGON DEPARTMENT OF TRANSPORTATION

HORIZONTAL CONTROL, RECOVERY, AND RETRACEMENT MAP

WINSTON - INTERSTATE 5
COOS BAY - ROSEBURG HWY.
DOUGLAS COUNTY

3500 STEWART PARKWAY, SUITE 140
ROSEBURG, OREGON 97470

APRIL 23, 2002
PROJECT KEY *09841

SHEET 7 OF 8