

NW1/4 & NE1/4 SECTION 21, T.28S., R.6W., W.M.

FILED

Date: 10-31-2024 By: *EB*


This survey consist of:

Map: ST. HWY 42-022 A-G

Narrative:

Corner Rpt: DOUGLAS COUNTY SURVEYOR

3186.49' WEST

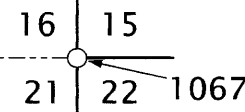

GOV. LOT 3 GOV. LOT 2


JAMES BELIEU  
DLC #52

JUNCTION SUBDIVISION  
VOL. 6, PG. 18

**LEGEND**

- ★ SET GPS STATION - AS NOTED IN TABLE ON SHEET 3
- ▲ SET NETWORK POINT - AS NOTED IN TABLE ON SHEET 3
- △ FOUND NETWORK POINT - AS NOTED IN TABLE ON SHEET 3
- ◆ SET STRATEGIC POINT - AS NOTED IN TABLE ON SHEET 3
- FOUND MONUMENT

SEE SHEET 3 FOR LINE LEGEND  
SEE SHEET 5 FOR MONUMENT TABLE

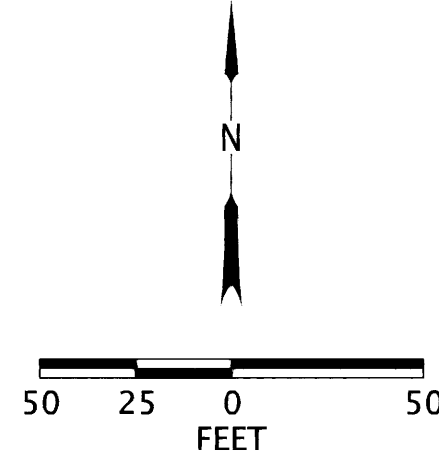

**RECORD DATA**

( [ ] )	ST. HWY. 42-007
[ ]	ODOT R/W DRG. 9B-7-5
{ }	ODOT R/W DRG. RW9614M & ST. HWY. 42-019

2188.29' SOUTH

NW GLENHART AVE.

GLEN D HART

COOS BAY - ROSEBURG HIGHWAY (OR 42)

Instr. No. 2009-3453  
BOOK 1359 PG 539  
TRACTS  
VOL. 3, PG. 25

REGISTERED  
PROFESSIONAL  
LAND SURVEYOR

*Eric B. Hibbs*

OREGON  
NOVEMBER 13, 2018  
ERIC BENJAMIN HIBBS  
90437PLS

RENEWS: 06/30/2025

OREGON DEPARTMENT OF TRANSPORTATION

HORIZONTAL CONTROL, RECOVERY AND RETRACEMENT MAP

OR42: LOOKINGGLASS CREEK  
TO I-5 (WINSTON) SECTION  
COOS BAY - ROSEBURG HIGHWAY  
DOUGLAS COUNTY



ODOT REGION 3 TECH CENTER  
3500 NW STEWART PKWY.  
ROSEBURG, OR 97470 KEY NO. K21677

OCTOBER 30, 2024  
SCALE: 1" = 50'  
SHEET 4 OF 7

ST. HWY. 42-022 D