
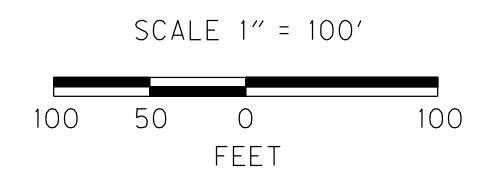



SEC. 24, T26S, R6W, W.M.

POINT LEGEND	
○	FOUND MONUMENT
◆	SET STRATEGIC POINT *
⊕	FOUND BENCH MARK *
* FOR CONTROL MONUMENT TABLE SEE SHEET 2	
FOR BOUNDARY LINE LEGEND SEE SHEET 3	

RECORD DATA	
()	S.P.R.R. V-16/38 & COUNTY SURVEY M146-55
NO	MEASURED/RESOLVED
BRACKET	SUPERCEDES RECORD

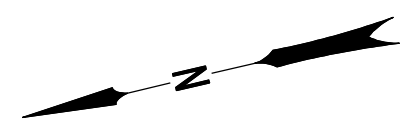

RECOVERED MONUMENTS								REFERENCE
PT. NO.	LDP. NORTHING	LDP. EASTING	LINE	STATION	OFFSET (- IS LT.)	DATE	DESCRIPTION	
1234	605888.143	4159229.678				3/13/2006	FD. 3/4" IRON REBAR 0.2 FT. ABOVE SURFACE GOOD CONDITION	M 38-62
1235	606226.145	4159304.883				3/1/2006	FD. 5/8" IRON REBAR 0.3 FT. ABOVE SURFACE GOOD CONDITION	M 28-17
1236	606529.464	4159180.350				3/1/2006	FD. 5/8" IRON REBAR FLUSH WITH SURFACE GOOD CONDITION	M 28-17
1243	606100.270	4159904.258	"RR"	966+03.69	-29.50	3/1/2006	FD. 5/8" IRON REBAR 0.8 FT. BELOW SURFACE GOOD CONDITION	RM 1-71
1263	606084.046	4159955.957	"RR"	966+08.80	-83.44	4/18/2007	FD. 5/8" IRON ROD WITH 1 1/4" PLASTIC CAP STAMPED "PLS 2287 LANDMARK" FLUSH WITH SURFACE GOOD CONDITION	M 146-55
1264	606436.391	4160032.023				4/18/2007	FD. 5/8" IRON ROD WITH 1 1/4" PLASTIC CAP STAMPED "PLS 2287 LANDMARK" FLUSH WITH SURFACE GOOD CONDITION	M 146-55
1265	606502.193	4159928.409				4/18/2007	FD. 5/8" IRON ROD WITH 1 1/4" PLASTIC CAP STAMPED "BTS ENG - SURV" 0.20 ABOVE SURFACE GOOD CONDITION	PENDING
1266	606064.377	4159835.328	"RR"	966+53.15	30.45	4/18/2007	FD. 5/8" IRON ROD WITH 1 1/4" PLASTIC CAP STAMPED "BTS ENG - SURV" 0.10 ABOVE SURFACE GOOD CONDITION	PENDING
1267	606215.085	4159454.439				4/18/2007	FD. 5/8" IRON ROD WITH 1 1/4" PLASTIC CAP STAMPED "BTS ENG - SURV" 0.30 ABOVE SURFACE GOOD CONDITION	PENDING
1268	606092.686	4159755.621				4/18/2007	FD. 5/8" IRON ROD WITH 1 1/4" PLASTIC CAP STAMPED "BTS ENG - SURV" 0.10 ABOVE SURFACE GOOD CONDITION	PENDING


OREGON DEPARTMENT OF TRANSPORTATION
 CONTROL, RECOVERY, AND RETRACEMENT MAP
 I5: DEL RIO ROAD / WINCHESTER INTERCHANGE
 PACIFIC HIGHWAY NO. 1, I-5, M.P. 128.26 - 130.53
 & OAKLAND - SHADY HIGHWAY, OR99
 DOUGLAS COUNTY
 FILE:15186RW.DGN MODEL: CRR
 FOR ODOT REGION 3 NOV. 15, 2011
 3500 NW. STEWART PKWY. SCALE: 1" = 100'
 ROSEBURG, OR. 97470 SHEET 8 OF 11