SEC. 35, T.21 S., R. 12 W., W.M.

FILED
Date: 5/22/2017 By: JC
This survey consist of:
Map: ST HWY 101-010 A-K
Narrative:
Corner Rpt:
DOUGLAS COUNTY SURVEYOR

CALCULATED POINTS

PT. NO.	OCRS NORTHING	OCRS EASTING	STATION	OFFSET (- IS LEFT)	DESCRIPTION
6024	828945.293	428511.268	"U"16+59.71	40.00	INTERSECTION OF RIGHT OF WAY DRG 4B-21-22 AND E. RAILROAD AVE.
6025	829013.186	428564.145	"U"16+91.44	-40.00	INTERSECTION OF RIGHT OF WAY DRG 4B-21-22 AND E. RAILROAD AVE.
6026	828930.695	428563.317	"U"17+11.60	40.00	INTERSECTION OF RIGHT OF WAY DRG 4B-21-22 AND E. RAILROAD AVE.
6027	828930.354	428564.678	"U"17+12.94	40.00	INTERSECTION OF RIGHT OF WAY DRG 4B-21-22 AND EASTERLY LINE OF LOT 2, BLOCK 74 AMENDED PLAT OF RAILROAD ADDITION
6028	828842.458	428594.020	"U"17+57.20	119.31	RIGHT OF WAY ANGLE POINT ON THE EASTERLY LINE OF LOT 2, BLOCK 74 AMENDED PLAT OF RAILROAD ADDITION AND FIR AVE., SEE DRG 4B-21-22
6029	828886.830	428958.733	"U"20+90.40	65.36	RIGHT OF WAY ANGLE POINT ON THE WEST LINE OF BLOCK 83 AMENDED PLAT OF RAILROAD ADDITION AND FIR AVE., SEE DRG 4B-21-22
6030	829005.014	429017.211	"U"21+68.76	-40.00	INTERSECTION OF RIGHT OF WAY DRG 4B-21-22 AND SOUTHWESTERLY LINE OF BLOCK 75 AMENDED PLAT OF RAILROAD ADDITION
6031	828987.150	429241.817	"U"23+80.18	40.34	RIGHT OF WAY ANGLE POINT ON THE EAST LINE OF BLOCK 83 AMENDED PLAT OF RAILROAD ADDITION AND FIR AVE., SEE DRG 4B-21-22
6032	829006.825	429298.501	"U"24+39.80	40.40	RIGHT OF WAY ANGLE POINT ON THE WEST LINE OF BLOCK 82 AMENDED PLAT OF RAILROAD ADDITION AND FIR AVE., SEE DRG 4B-21-22
6033	829082.591	429271.594	"U"24+39.63	-40.00	RIGHT OF WAY ANGLE POINT ON THE WEST LINE OF BLOCK 76 AMENDED PLAT OF RAILROAD ADDITION AND FIR AVE., SEE DRG 4B-21-22

POINT LEGEND

- ○ FOUND MONUMENT
- ▲ SET NETWORK MONUMENT
- △ FOUND MONUMENT USED AS A NETWORK POINT
- □ CALCULATED POINT

SEE SHEET 2 FOR LINE LEGEND

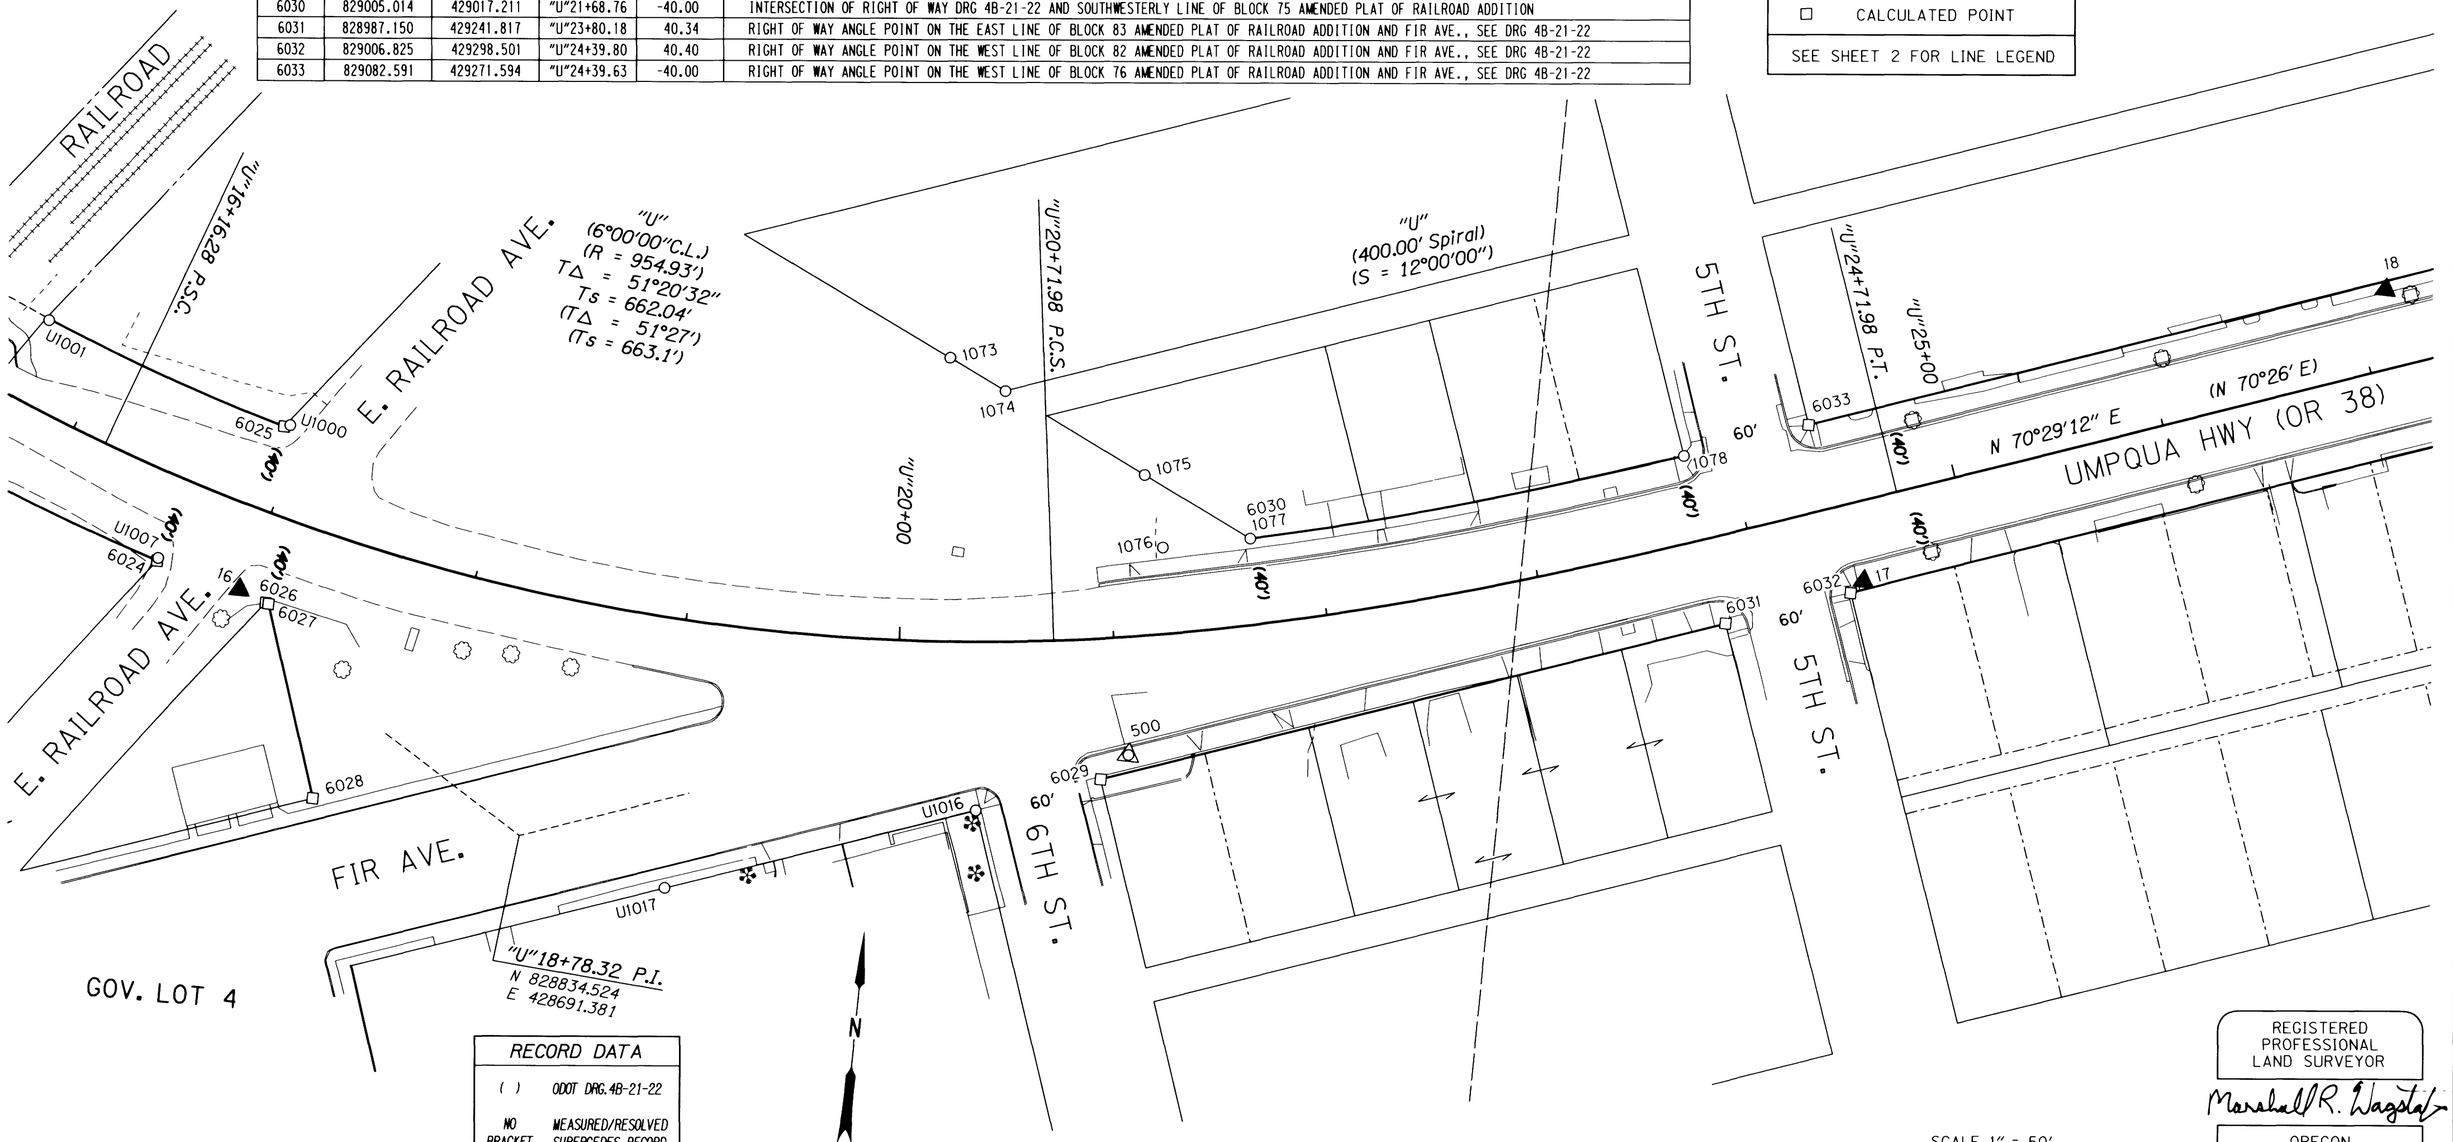

RECORD DATA

( )	ODOT DRG. 4B-21-22
NO BRACKET	MEASURED/RESOLVED SUPERCEDES RECORD

MONUMENT TABLE

Y.P.C. = YELLOW PLASTIC CAP UNK = UNKNOWN

PT. NO.	OCRS NORTHING	OCRS EASTING	ELEVATION	STATION	OFFSET (- IS LEFT)	DATE	DESCRIPTION	REFERENCE
16	828935.719	428550.600	14.35	"U"16+98.56	38.32	8/26/2015	SET 5/8" X 30" IRON REBAR W/ 1 1/2" BRASS CAP STAMPED "ODOT CONTROL 16" FLUSH WITH GND.	-
17	829012.892	429304.053	10.41	"U"24+47.03	36.53	8/26/2015	SET 1" COPPER PLUG STAMPED "ODOT 17" IN CONC. WALK	-
18	829171.226	429533.376	11.22	"U"27+16.04	-36.11	8/26/2015	SET 1" COPPER PLUG STAMPED "ODOT 18" IN CONC. WALK	-
500	828899.259	428970.498	10.26	"U"21+03.20	54.92	8/25/2015	FD. 1" COPPER PLUG STAMPED "ODOT CONTROL 500 " IN CONC. WALK	ST. HWY. 38-016
1073	829075.087	428870.049	-	"U"20+21.31	-131.90	1/20/2016	FD. 3/4" IRON REBAR FLUSH WITH GROUND SURFACE GOOD COND.	M96-21
1074	829062.154	428897.188	-	"U"20+50.98	-116.49	1/20/2016	FD. 5/8" IRON REBAR WITH 1 1/4" Y.P.C. STAMP NOT LEGIBLE 1" BELOW GROUND SURFACE FAIR COND.	M96-21
1075	829029.658	428965.577	-	"U"21+20.68	-74.42	1/20/2016	FD. 5/8" IRON REBAR WITH 1 1/4" Y.P.C. STAMP NOT LEGIBLE 1" BELOW GROUND SURFACE FAIR COND.	M123-10
1076	828996.859	428977.246	-	"U"21+26.53	-40.06	1/20/2016	FD. 5/8" IRON REBAR WITH 1 1/4" Y.P.C. STAMP PARTIALLY LEGIBLE "STUNT* ENG. 1" BELOW GROUND SURFACE FAIR COND.	M123-10
1077	829004.956	429017.377	-	"U"21+68.91	-39.91	1/20/2016	FD. 5/8" IRON REBAR WITH 1 1/4" Y.P.C. STAMPED "STUNTZNER ENG." FLUSH WITH A.C. SURFACE GOOD COND.	M123-10
1078	829062.780	429214.958	-	"U"23+79.24	-39.91	1/20/2016	FD. 1" O.D. IRON PIPE 6" BELOW BRICK ADA RAMP GOOD COND.	UNK
U1000	829014.046	428566.903	-	"U"16+93.99	-41.56	3/3/2007	FD. 5/8" IRON REBAR BENT TO THE NW. 0.60 FT BELOW SURFACE, IN POOR COND. TIED WHERE ROD ENTERS GROUND	M124-55
U1007	828946.634	428511.627	-	"U"16+59.65	38.61	3/3/2007	FD. 5/8" IRON REBAR WITH 1 1/4" PLASTIC CAP STAMPED "LS 2865". 1.0 FT. BELOW SURFACE, IN GOOD COND.	M143-30
U1016	828866.758	428902.188	-	"U"20+35.90	78.42	6/19/2007	FD. 2 1/2" BRASS CAP STAMPED "COUNTY SURVEYORS OFFICE DOUGLAS COUNTY LOT 1 COR NO. 2 BLK 84 1956". 0.90 FT. BELOW EDGE OF	M96-21
U1017	828816.839	428761.229	-	"U"19+07.27	124.76	6/19/2007	FD. 5/8" IRON REBAR 0.9 FT. BELOW SURFACE, IN POOR COND.	CS51/252-1

REGISTERED PROFESSIONAL LAND SURVEYOR
Marshall R. Wagstaff
OREGON
JANUARY 9, 2001
MARSHALL R. WAGSTAFF
49476LS
RENEWS: JUNE 30, 2018

SCALE 1" = 50'
50 25 0 50
FEET

SI FEET

OREGON DEPARTMENT OF TRANSPORTATION

HORIZONTAL CONTROL, RECOVERY AND RETRACEMENT MAP
OR 38: US 101-DEAN CREEK PAVING & PED IMPROVEMENTS
OREGON COAST HWY. NO. 9, US101, M.P. 211.32 TO 212.34
UMPQUA HWY. NO. 45, OR38, M.P. 0.00 TO 0.88
DOUGLAS COUNTY FILE: S_18869_CRR.DGN

FOR ODOT REGION 3
3500 NW. STEWART PKWY.
ROSEBURG, OR. 97470

MAY 17, 2017

ST HWY 101-010 I
ST HWY 101-010I