MAP FILE M129-48 I

METRIC

SECTION 29 & 32, T. 27 S., R. 6 E., W. M.

FILED
Date: 6-9-1999 By: JP
This survey consists of: 16 Pages
Map: M 129-48 I
Narrative:
Corner Rpt:
DOUGLAS COUNTY SURVEYOR

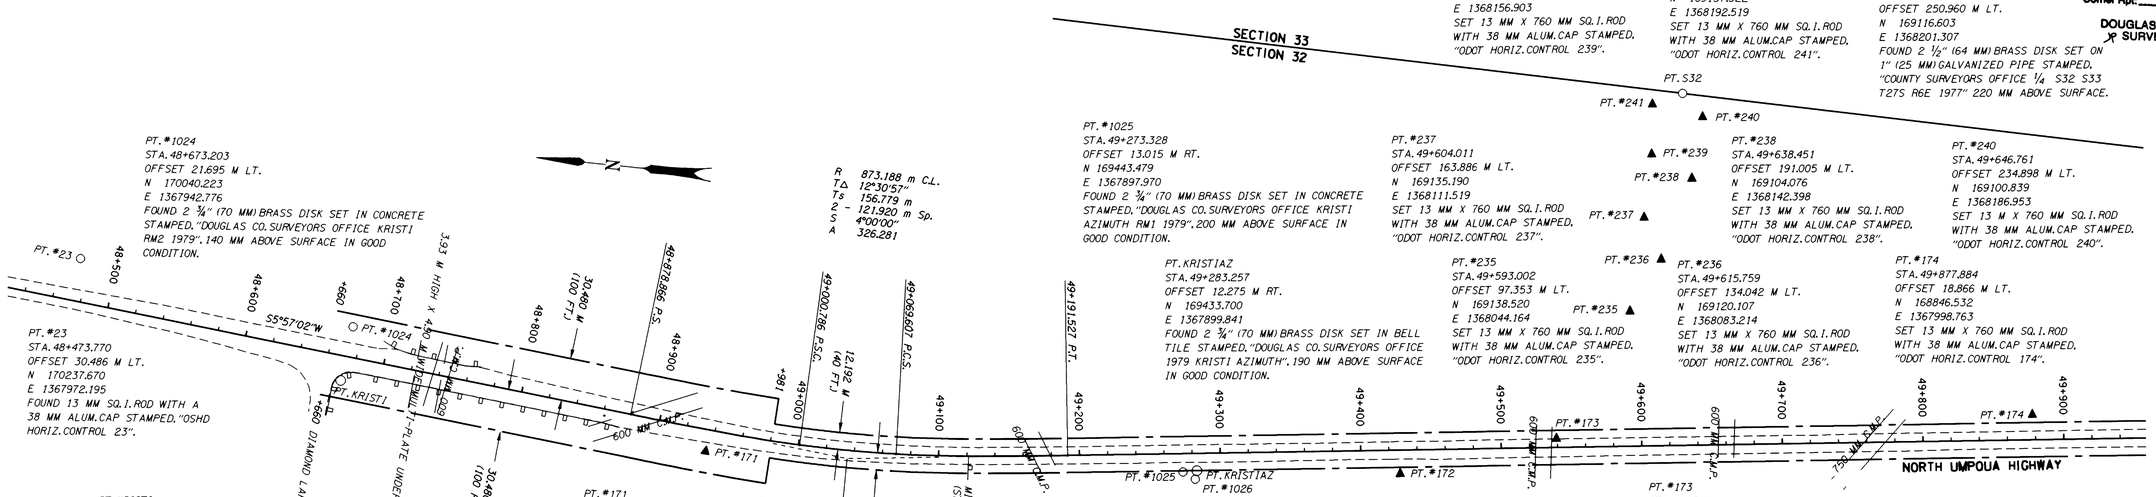

SECTION 32, T. 27 S., R. 6 E., W. M. AND SECTION 4 & 9, T. 28 S., R. 5 1/2 E., W.M.

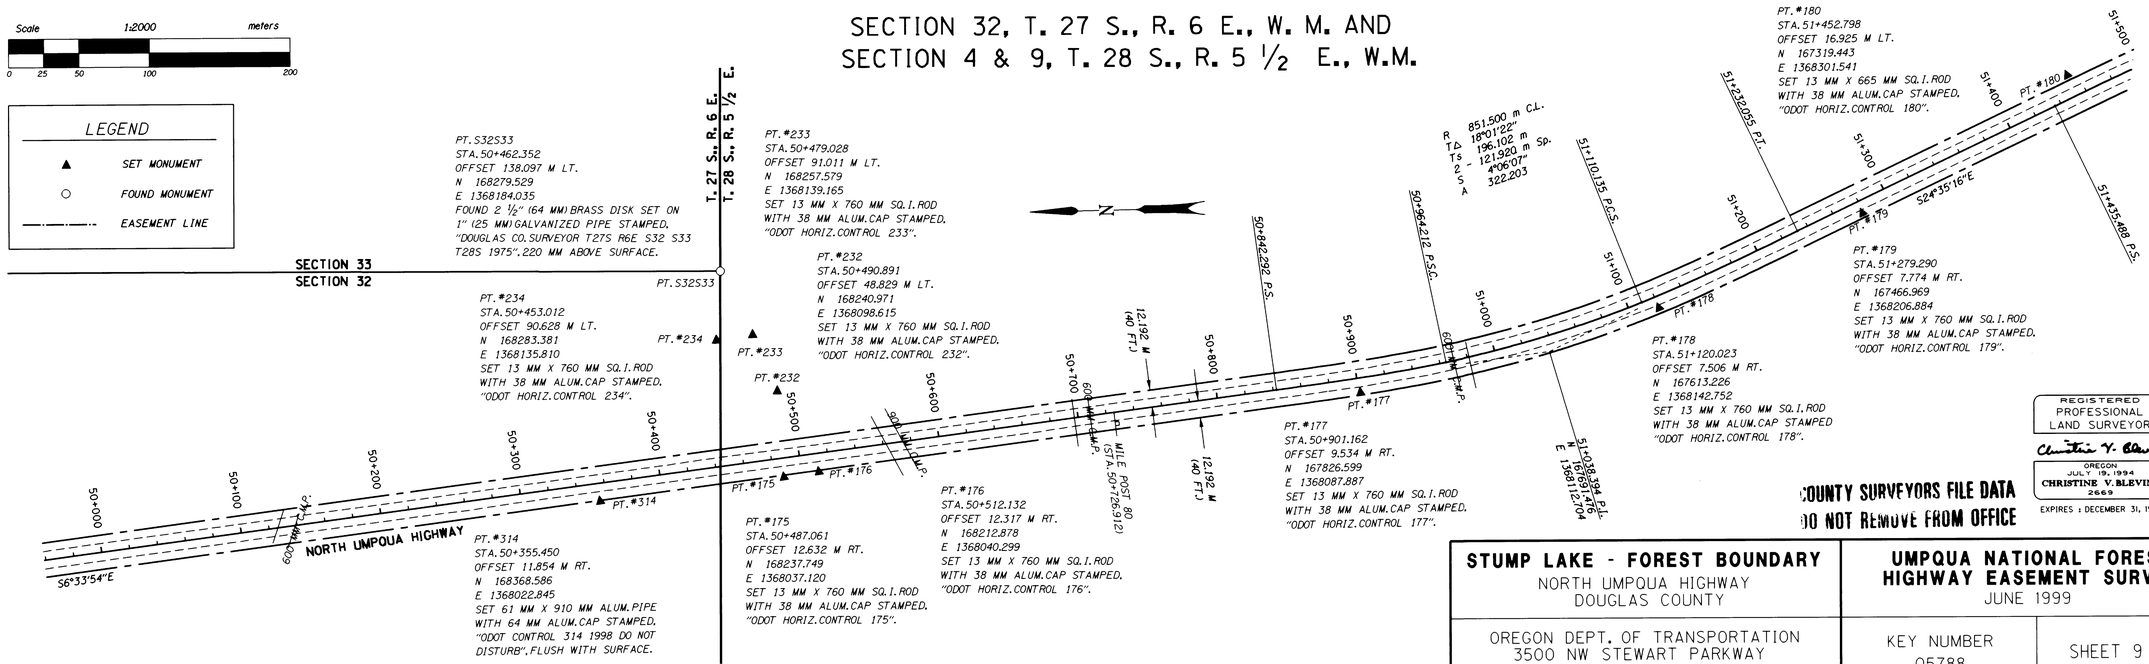

REGISTERED PROFESSIONAL LAND SURVEYOR
Christine V. Blevins
OREGON JUL 7, 1994 CHRISTINE V. BLEVINS 2669
EXPIRES : DECEMBER 31, 1999

COUNTY SURVEYORS FILE DATA
DO NOT REMOVE FROM OFFICE

STUMP LAKE - FOREST BOUNDARY NORTH UMPQUA HIGHWAY DOUGLAS COUNTY	UMPQUA NATIONAL FOREST HIGHWAY EASEMENT SURVEY JUNE 1999	
OREGON DEPT. OF TRANSPORTATION 3500 NW STEWART PARKWAY ROSEBURG, OR 97470	KEY NUMBER 05788	SHEET 9 OF 16

ST. HWY. 138-0041

MAP FILE M129-48 I