MAP FILE M129-48 N

METRIC

FILED
Date: 6-9-1999 By: JP
This survey consists of: 16 PAGES
Map: M 129-48 N
Narrative:
Corner Rpt: CS 65/28-14
DOUGLAS COUNTY SURVEYOR
JP

SECTION 3 & 2, T. 29 S., R. 5 1/2 E., W. M.

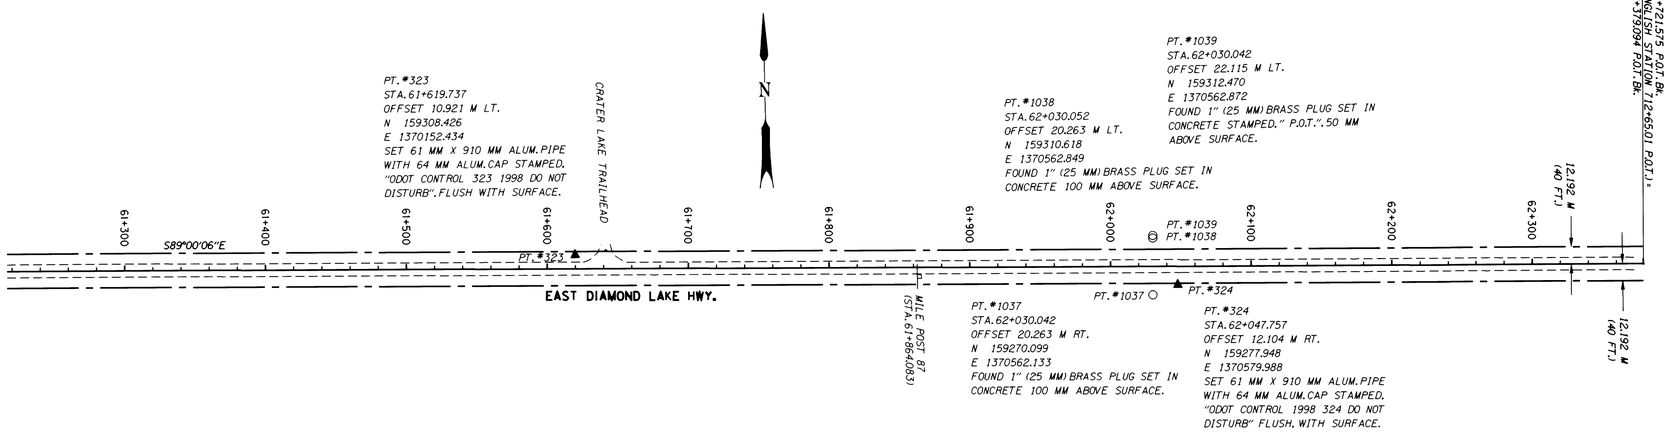

SECTION 20, 21, & 29, T. 28 S., R. 5 1/2 E., W. M.

FOR MORE INFORMATION ON FOUND MONUMENTS
SEE ADDENDUM FILED IN C.S. FILE 65/28-14

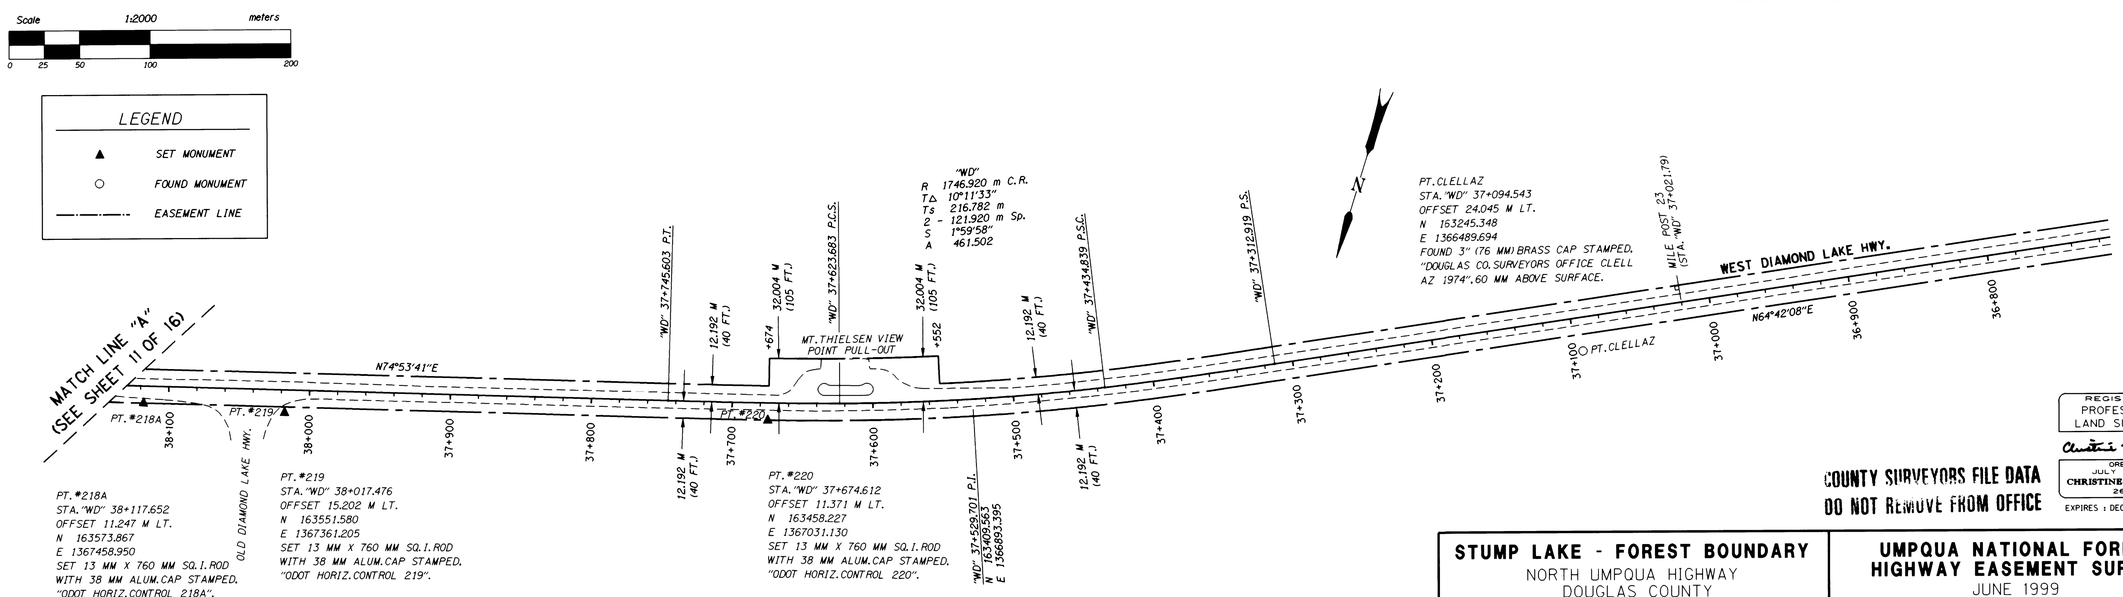

REGISTERED
PROFESSIONAL
LAND SURVEYOR
Christine V. Blevins
OREGON
JULY 19, 1994
CHRISTINE V. BLEVINS
2669
EXPIRES : DECEMBER 31, 1999

COUNTY SURVEYORS FILE DATA
DO NOT REMOVE FROM OFFICE

STUMP LAKE - FOREST BOUNDARY NORTH UMPQUA HIGHWAY DOUGLAS COUNTY	UMPQUA NATIONAL FOREST HIGHWAY EASEMENT SURVEY JUNE 1999	
OREGON DEPT. OF TRANSPORTATION 3500 NW STEWART PARKWAY ROSEBURG, OR 97470	KEY NUMBER 05788	SHEET 14 OF 16

ST. HWY. 138-004N MAP FILE M129-48 N