SEC. 2, T. 26 S., R. 1 W., W.M.

FILED
Date: 7/8/2009 By: J.C.
This survey consists of:
Map: ST HWY 138-011 A-Y
Narrative:
Corner Rpt:
DOUGLAS COUNTY SURVEYOR

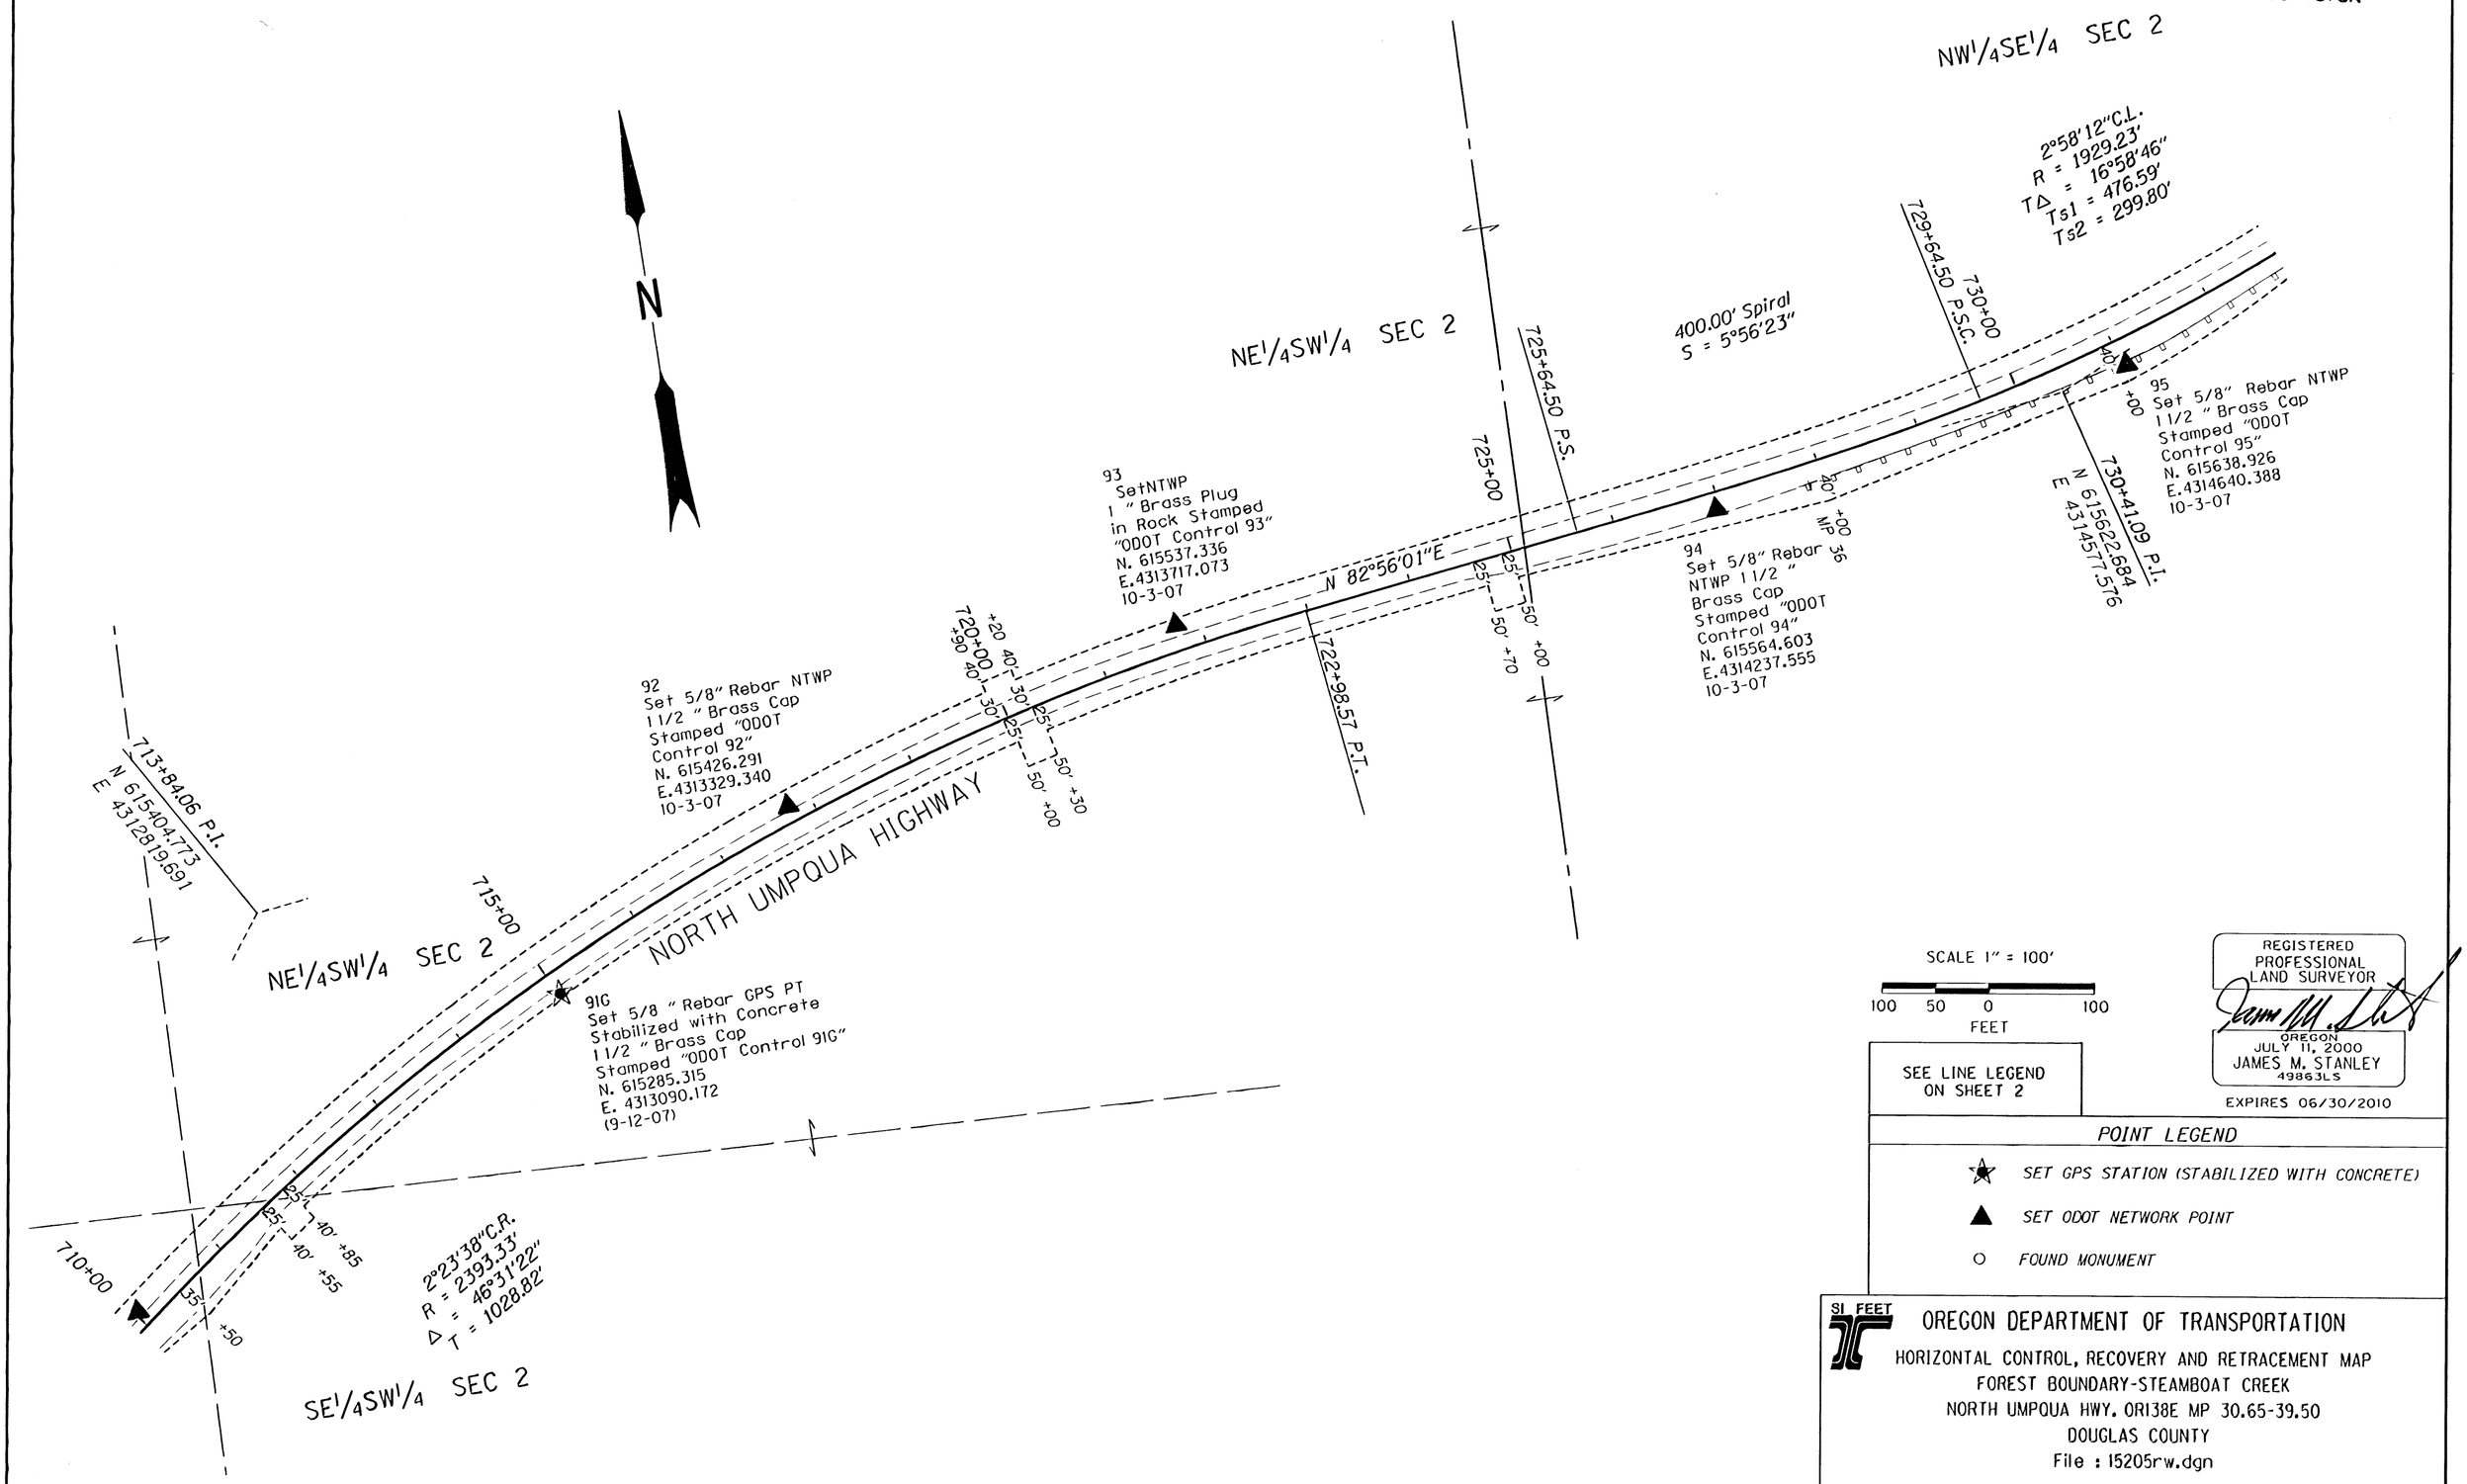

SCALE 1" = 100'

100 50 0 100
FEET

SEE LINE LEGEND ON SHEET 2

REGISTERED PROFESSIONAL LAND SURVEYOR
OREGON
JULY 11, 2000
JAMES M. STANLEY
49863LS
EXPIRES 06/30/2010

POINT LEGEND

- SET GPS STATION (STABILIZED WITH CONCRETE)
- SET ODOT NETWORK POINT
- FOUND MONUMENT

SI FEET

OREGON DEPARTMENT OF TRANSPORTATION

HORIZONTAL CONTROL, RECOVERY AND RETRACEMENT MAP
FOREST BOUNDARY-STEAMBOAT CREEK
NORTH UMPQUA HWY. OR138E MP 30.65-39.50
DOUGLAS COUNTY
File : 15205rw.dgn

FOR ODOT REGION 3
3500 NW. STEWART PKWY.
ROSEBURG, OR. 97470

JUNE 30, 2009
SCALE: 1" = 100'
SHEET 17 OF 25

ST. HWY. 138-011 Q