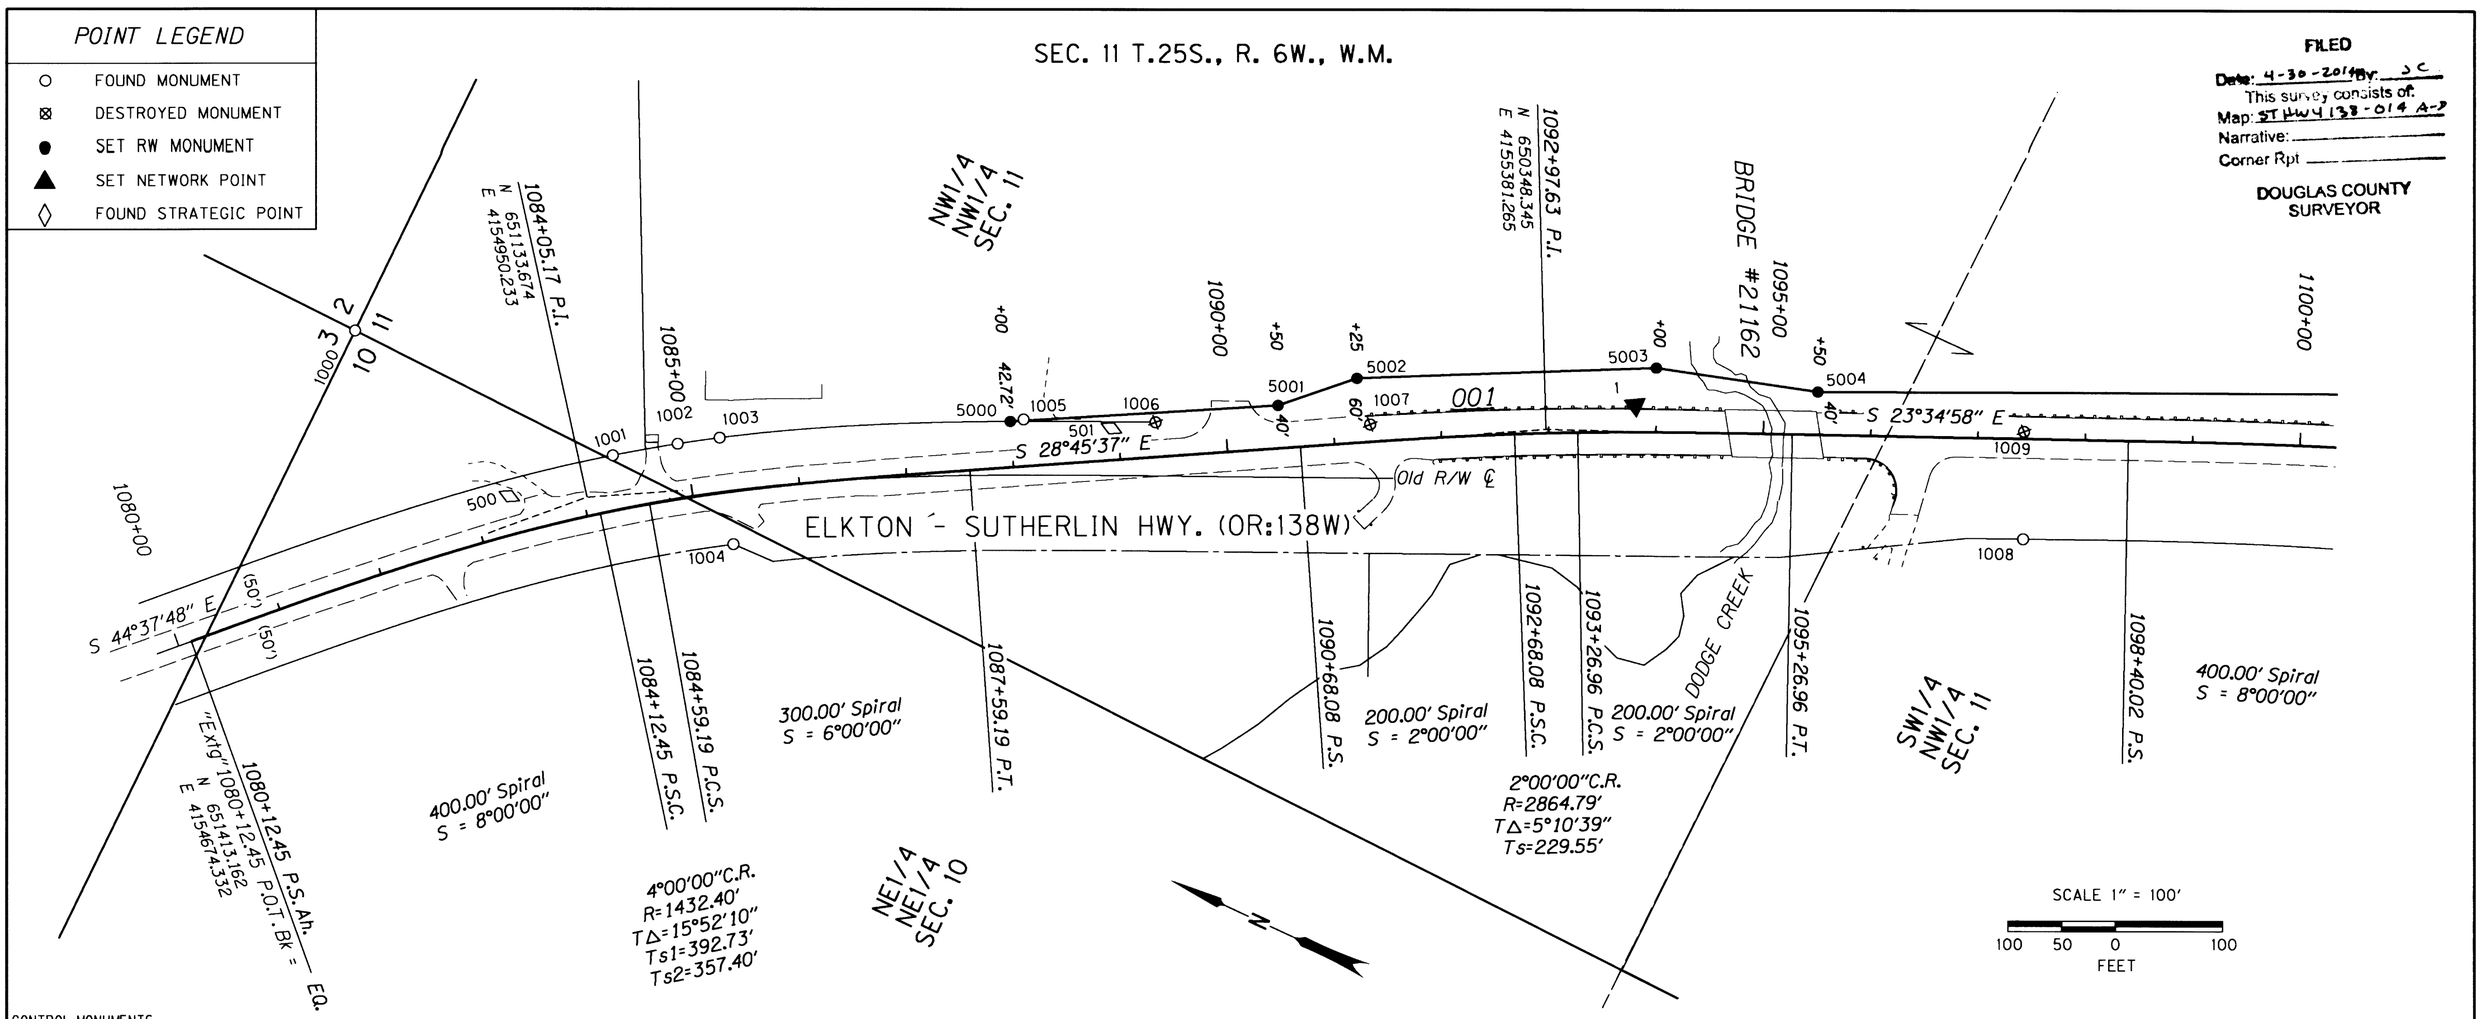

CONTROL MONUMENTS

PT. NO.	LDP NORTHING	LDP EASTING	ELEV.	DATE	DESCRIPTION	REFERENCE
500	651199.736	4154920.827	455.95	6/26/13	FD. 1 1/2" BRASS CAP STAMPED "ODOT CONTROL 500" GOOD COND.	ST. HWY.138-010 A-L
501	650716.677	4155212.986	445.76	6/26/13	FD. 1 1/2" BRASS CAP STAMPED "ODOT CONTROL 501" GOOD COND. CARSONITE WITNESS POST NEARBY	ST. HWY.138-010 A-L
1	650282.279	4155436.727		6/26/13	SET 5/8" X 30" I. REBAR WITH 1 1/2" BRASS CAP STAMPED "ODOT CONTROL 1"	

SET R/W MONUMENTS

PT. NO.	LDP NORTHING	LDP EASTING	STATION	OFFSET (-IS LT.)	DATE	DESCRIPTION
5000	650805.142	4155179.282	1088+00	-42.72	6/26/13	SET 5/8" X 30" IRON REBAR WITH 2" ALUM CAP STAMPED " OREGON DEPT OF TRANSP RIGHT OF WAY 5000"
5001	650584.673	4155297.184	1090+50	-40.00	6/26/13	SET 5/8" X 30" IRON REBAR WITH 2" ALUM CAP STAMPED " OREGON DEPT OF TRANSP RIGHT OF WAY 5001"
5002	650528.373	4155350.837	1091+25	-60.00	6/26/13	SET 5/8" X 30" IRON REBAR WITH 2" ALUM CAP STAMPED " OREGON DEPT OF TRANSP RIGHT OF WAY 5002"
5003	650278.857	4155476.41	1094+00	-60.00	6/26/13	SET 5/8" X 30" IRON REBAR WITH 2" ALUM CAP STAMPED " OREGON DEPT OF TRANSP RIGHT OF WAY 5003"
5004	650132.853	4155518.979	1095+50	-40.00	6/26/13	SET 5/8" X 30" IRON REBAR WITH 2" ALUM CAP STAMPED " OREGON DEPT OF TRANSP RIGHT OF WAY 5004"

RECOVERED MONUMENTS

PT. NO.	LDP NORTHING	LDP EASTING	DATE	DESCRIPTION	REFERENCE
1000	651395.085	4155000.795	10/28/08	FD. 2 1/2" BRASS DISC ON 1 1/4" DIA. PIPE STAMPED"CO. SURVEYOR'S OFFICE T. 25S. S. 3 S. 2 S. 10 S. 11 R. 6W 1962" 0.9' ABOVE SURFACE GOOD CONDITION.	CS 63/12-2
1001	651128.126	4154995.686	10/28/08	FD. 5/8" I. REBAR 0.7' BELOW SURFACE GOOD CONDITION	RM2-25
1002	651077.749	4155030.758	10/28/08	FD. 5/8" I. REBAR 1.5' BELOW SURFACE GOOD CONDITION	RM2-25
1003	651044.674	4155052.194	10/28/08	FD. 5/8" I. REBAR 0.1' BELOW SURFACE GOOD CONDITION WITH PADDLE "STA. SHRW PCS 1085+31.44 50' LT.	DRG.6B-24-16
1004	650991.599	4154967.520	10/28/08	FD. 5/8" I. REBAR FLUSH WI/SURFACE GOOD CONDITION WITH PADDLE "STA. SHRW PCS 1085+31.44 50' RT.	DRG.6B-24-16
1008	649901.996	4155474.322	10/28/08	FD. 3' BRASS DISK SET IN 12'x12" CONC. PEDESTAL STAMPED" STATE HIGHWAY DEPARTMENT ELEVATION FEET BM NO." 0.5' ABOVE SURFACE GOOD CONDITION WITH PADDLE "STA 1097+40.95 50' RT."	DRG.6B-24-16

DESTROYED R/W MONUMENTS

PT. NO.	LDP NORTHING	LDP EASTING	DATE	DESCRIPTION	REFERENCE
1006	650681.693	4155235.260	10/16/08	5/8" I. REBAR 0.2' ABOVE SURFACE GOOD CONDITION WITH 4x4 WOOD POST AND PADDLE "STA. SHRW PCS 1089+31.44 P.T. 50' LT	DRWG.6B-24-16
1007	650499.202	4155316.914	10/16/08	5/8" I. REBAR 0.15' ABOVE SURFACE GOOD CONDITION	RM2-25
1009	649942.849	4155565.563	10/16/08	2 1/2" BRASS DISK SET IN 12'x12" CONC. PEDESTAL STAMPED" STATE HIGHWAY DEPARTMENT ELEVATION FEET BM NO." 0.5' ABOVE SURFACE GOOD CONDITION WITH PADDLE "STA 1097+40.95 50' LT.	DRWG.6B-24-16

SEE LINE LEGEND ON SHEET 1

REGISTERED PROFESSIONAL LAND SURVEYOR

OREGON
NOV. 10, 2011
MICKEY D. CALVERT
75099

EXPIRES: 12/31/2015

SI FEET

OREGON DEPARTMENT OF TRANSPORTATION

RIGHT-OF-WAY BOUNDARY MONUMENTATION MAP
OR138: DODGE CR/CALAPOOYA CR BRIDGE REPLACEMENTS
ELKTON-SUTHERLIN HWY NO. 138 MP 20.74-22.22
DOUGLAS COUNTY
1597ORW.DGN

FOR ODOT REGION 3
3500 NW. STEWART PKWY.
ROSEBURG, OR. 97470

APRIL 24, 2014
SCALE: 1" = 100
SHEET 3 OF 4

ST. HWY. 138-014 C