NW 1/4 SECTION 19 T27S R5W WM

FILED
Date: 12-11-2024 By: BJ
This survey consist of:
Map: ST. HWY 138-019 A-J
Narrative:
Corner Rpt:
DOUGLAS COUNTY SURVEYOR

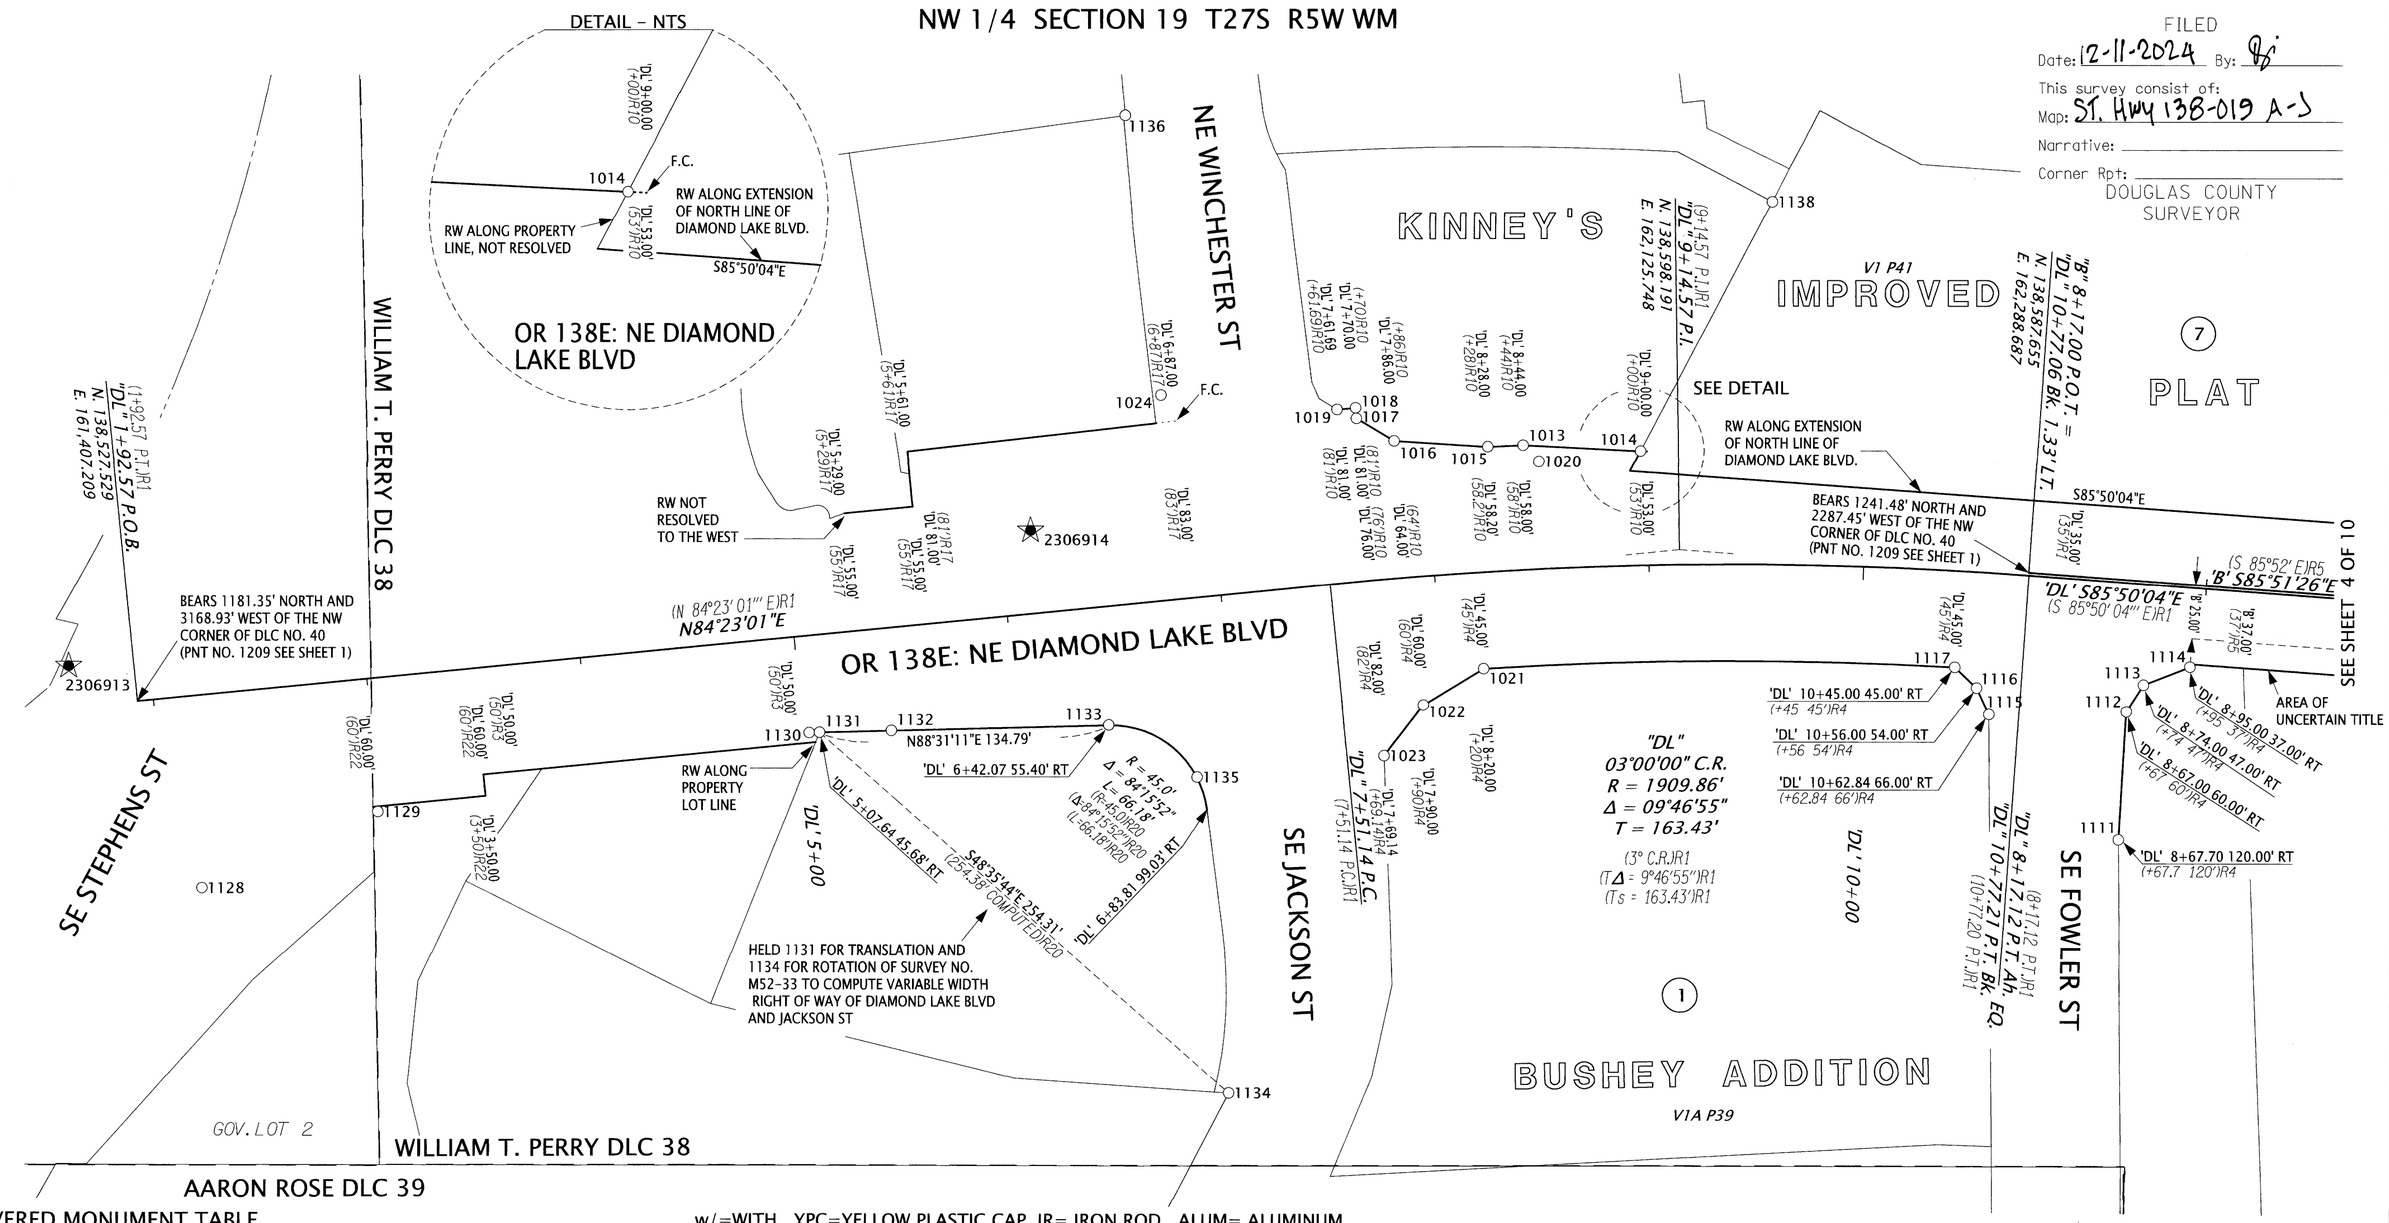

RECOVERED MONUMENT TABLE

w/=WITH YPC=YELLOW PLASTIC CAP IR= IRON ROD ALUM= ALUMINUM

PT. NO.	STATION	OFFSET	OCRS NORTHING	OCRS EASTING	DATE	DESCRIPTION	REFERENCE DOCUMENT
1013	'DL' 8+43.98	-58.02	138646.98	162052.81	2/7/2024	FOUND 2" ALUM CAP "ODOT RIGHT OF WAY"	ST. HWY 138-016
1014	'DL' 8+97.07	-53.25	138644.16	162107.58	2/7/2024	FOUND 2" ALUM CAP "ODOT RIGHT OF WAY"	ST. HWY 138-016
1015	'DL' 8+27.98	-58.24	138646.31	162036.33	2/7/2024	FOUND 2" ALUM CAP "ODOT RIGHT OF WAY"	ST. HWY 138-016
1016	'DL' 7+85.98	-64.00	138649.08	161992.70	2/7/2024	FOUND 2" ALUM CAP "ODOT RIGHT OF WAY"	ST. HWY 138-016
1017	'DL' 7+69.97	-75.99	138659.65	161975.16	2/7/2024	FOUND 2" ALUM CAP "ODOT RIGHT OF WAY"	ST. HWY 138-016
1018	'DL' 7+70.02	-81.01	138664.64	161974.77	2/7/2024	FOUND 2" ALUM CAP "ODOT RIGHT OF WAY"	ST. HWY 138-016
1019	'DL' 7+61.70	-81.00	138663.85	161966.13	2/7/2024	FOUND 2" ALUM CAP "ODOT RIGHT OF WAY"	ST. HWY 138-016
1020	'DL' 8+50.83	-50.07	138639.37	162060.22	2/7/2024	FOUND 1" COPPER DISK "ODOT CONTROL 3"	ST. HWY 138-006
1021	'DL' 8+19.98	44.98	138542.81	162034.50	2/7/2024	FOUND 2" ALUM CAP "ODOT RIGHT OF WAY"	ST. HWY I5-032
1022	'DL' 7+90.01	59.95	138525.83	162006.47	2/7/2024	FOUND 2" ALUM CAP "ODOT RIGHT OF WAY"	ST. HWY I5-032
1023	'DL' 7+69.11	81.98	138502.21	161988.24	2/7/2024	FOUND 2" ALUM CAP "ODOT RIGHT OF WAY"	ST. HWY I5-032
1024	'DL' 6+81.16	-95.73	138670.62	161884.08	2/7/2024	FOUND 1" COPPER PLUG "ODOT CONTROL 6"	ST. HWY 138-006
1111	'DL' 8+67.69	120.00	138462.96	162330.47	4/4/2024	FOUND 2" ALUM CAP "ODOT RIGHT OF WAY" 5119	ST. HWY I5-032
1112	'DL' 8+67.00	60.00	138522.85	162334.14	4/4/2024	FOUND 2" ALUM CAP "ODOT RIGHT OF WAY" 5120	ST. HWY I5-032
1113	'DL' 8+73.98	47.00	138535.32	162342.04	4/4/2024	FOUND 2" ALUM CAP "ODOT RIGHT OF WAY" 5121	ST. HWY I5-032
1114	'DL' 8+94.99	37.01	138543.76	162363.72	4/4/2024	FOUND 2" ALUM CAP "ODOT RIGHT OF WAY" 5122	ST. HWY I5-032
1115	'DL' 10+62.84	65.94	138521.51	162270.11	4/4/2024	FOUND 2" ALUM CAP "ODOT RIGHT OF WAY" 5118	ST. HWY I5-032
1116	'DL' 10+56.04	54.00	138533.84	162264.30	4/4/2024	FOUND 2" ALUM CAP "ODOT RIGHT OF WAY" 5117	ST. HWY I5-032
1117	'DL' 10+44.99	44.96	138543.50	162254.09	4/4/2024	FOUND 2" ALUM CAP "ODOT RIGHT OF WAY" 5116	ST. HWY I5-032
1128	'DL' 2+14.05	90.08	138439.99	161437.41	5/6/2024	FOUND 5/8" IR SEVERLY BENT EASTERLY SHOT SPIN HOLE	M40-60
1129	'DL' 2+99.22	62.43	138475.84	161519.46	5/6/2024	FOUND 5/8" IR BENT w/ IRON PIPE PLACED OVER TOP EXPOSED 1FT	M40-60
1130	'DL' 5+02.83	45.37	138512.74	161720.42	5/6/2024	FOUND 5/8" IR	M52-33
1131	'DL' 5+07.64	45.68	138512.90	161725.23	5/6/2024	FOUND 5/8" IR	M37-47
1132	'DL' 5+41.05	48.04	138513.82	161758.72	5/6/2024	FOUND 5/8" IR	M37-47
1133	'DL' 6+42.11	55.27	138516.52	161860.00	5/6/2024	FOUND 5/8" IR DN 0.4' IN CONC	M37-47
1134	'DL' 6+81.01	231.73	138344.71	161915.98	5/6/2024	FOUND LEAD AND TACK IN CONC	M37-47
1135	'DL' 6+80.70	83.50	138492.21	161901.17	5/6/2024	FOUND 5/8" IR DN 0.3' LOOSE IN CONC	M37-47
1136	-	-	138800.74	161867.52	5/6/2024	FOUND YPC "IE ENGINEERING"	M142-49
1138	'DL' 9+55.80	-169.20	138760.48	162169.00	5/6/2024	FOUND 5/8" IR w/BROKEN YPC ILLEGIBLE	M131-48

LEGEND

( )R#	SEE SHEET 2 FOR REFERENCE INFORMATION
○	FOUND MONUMENT NOTED IN TABLE
★	SET CONTROL POINT NOTED IN TABLE ON SHEET 2
F.C.	FALSE CALL FROM DEED

REGISTERED PROFESSIONAL LAND SURVEYOR

OREGON
MARCH 14, 2017
ZACHARY P. EARLE
91474

EXPIRES: 12/31/2025

OREGON DEPARTMENT OF TRANSPORTATION

HORIZONTAL CONTROL, RECOVERY AND RETRACEMENT.
SOUTHWEST OREGON 2024-2027 ADA CURB RAMP DESIGN, PHASE 2
DOUGLAS COUNTY

ODOT REGION 3 TECH CENTER
100 ANTELOPE RD.
WHITE CITY, OR 97503 KEY NO. 23069

NOVEMBER 7, 2024
SCALE 1" = 50'
SHEET 3 OF 10

ST. HWY. 138-019 C