SW 1/4 SECTION 15 T27S R5W WM
SE 1/4 SECTION 15 T27S R5W WM

FILED
Date: 5-13-2025 By: DD
This survey consist of:
Map: ST. HWY 138-020A-D
Narrative:
Corner Rpt:
DOUGLAS COUNTY
SURVEYOR

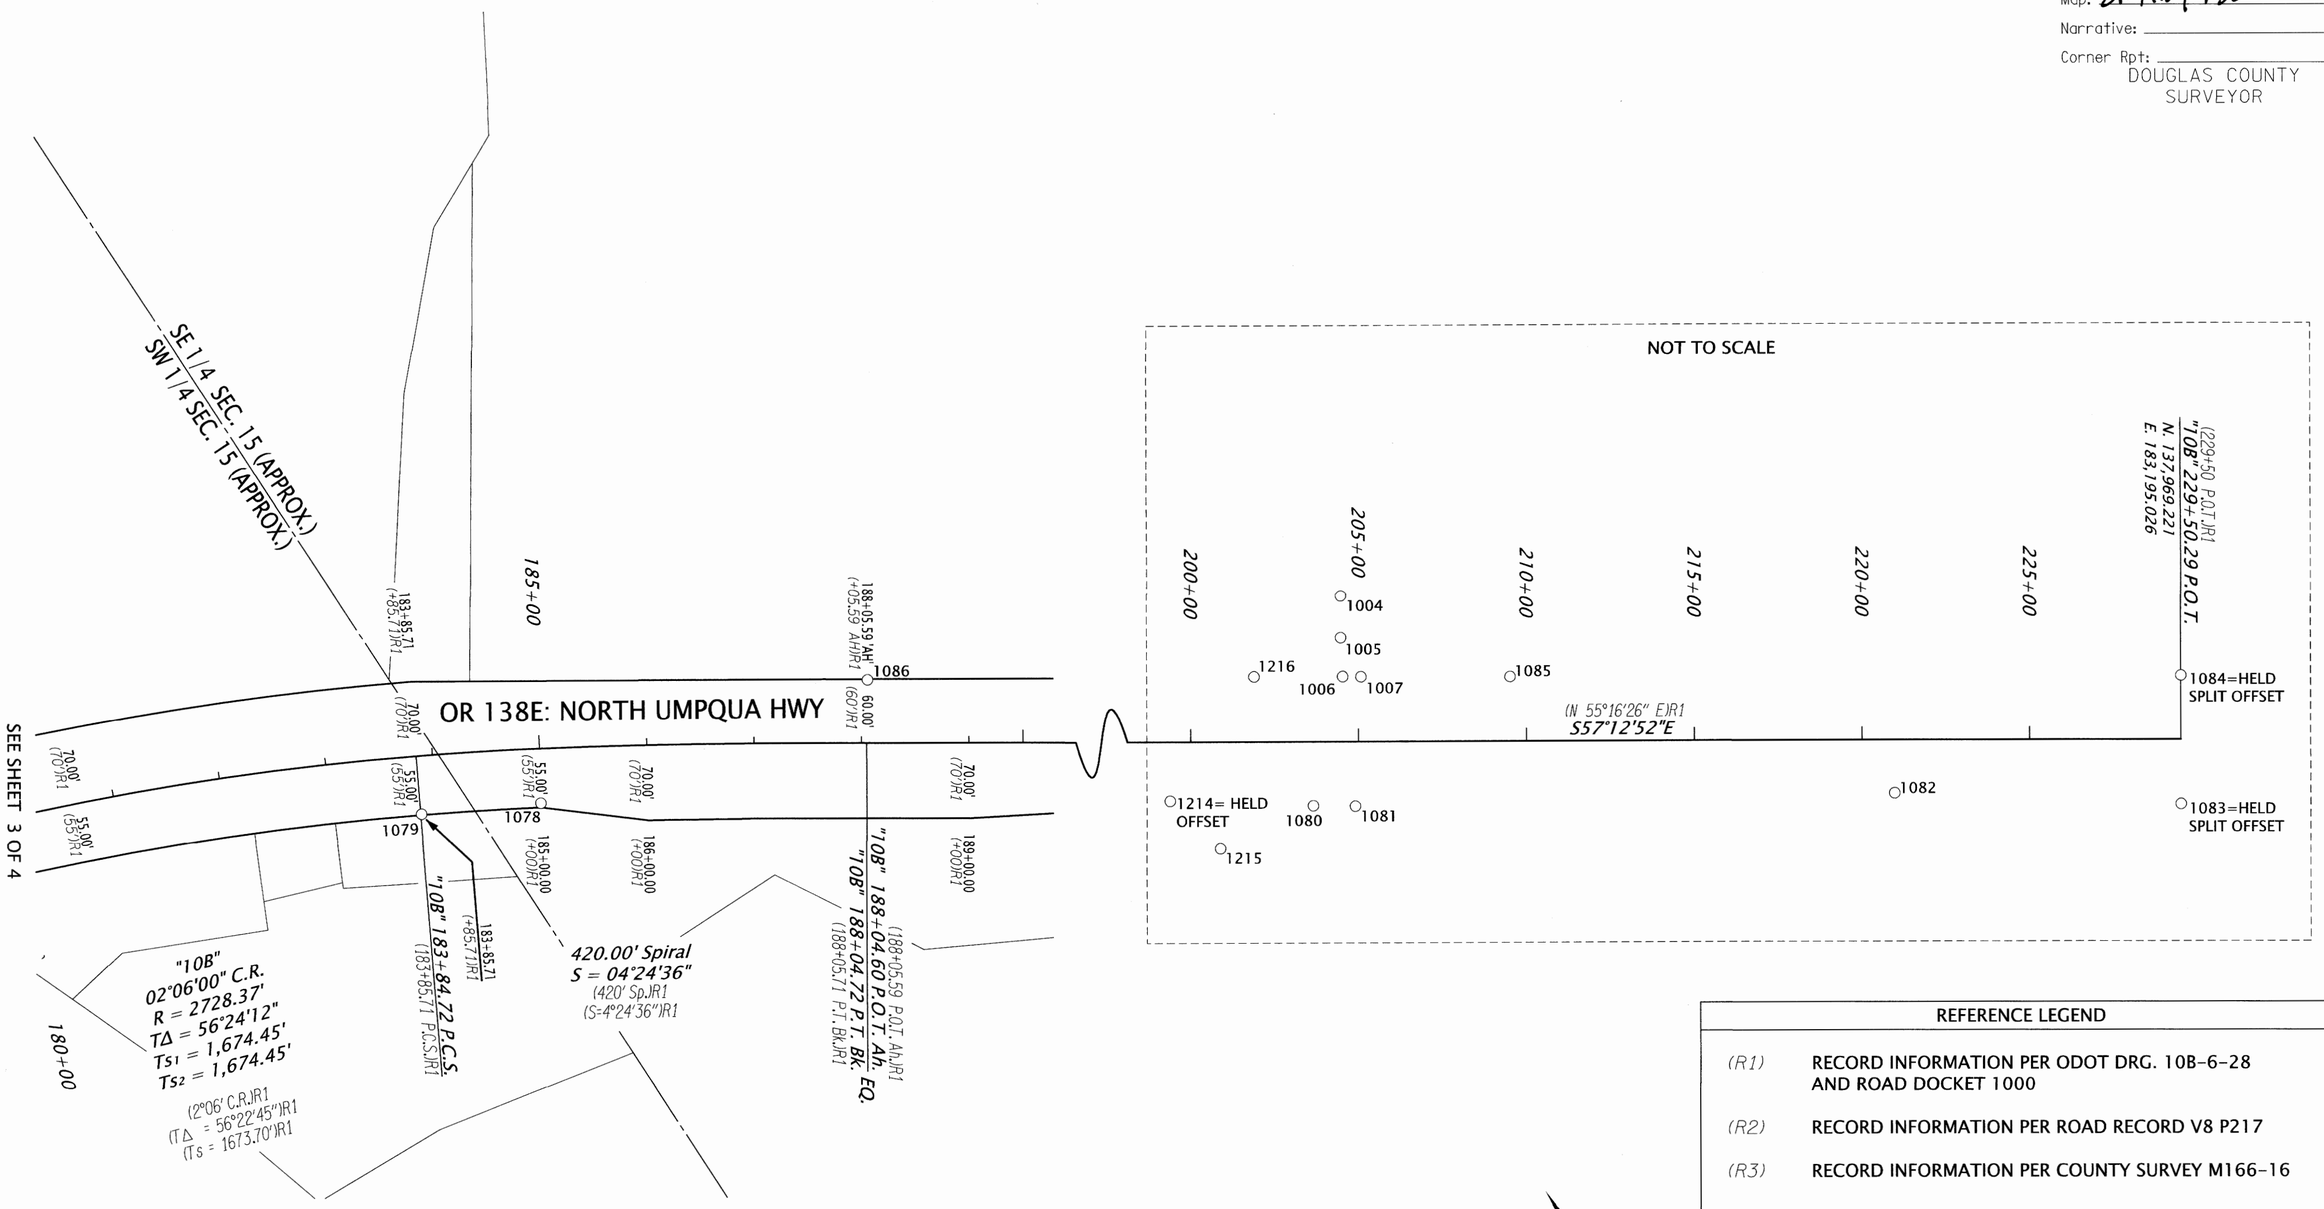

REFERENCE LEGEND	
(R1)	RECORD INFORMATION PER ODOT DRG. 10B-6-28 AND ROAD DOCKET 1000
(R2)	RECORD INFORMATION PER ROAD RECORD V8 P217
(R3)	RECORD INFORMATION PER COUNTY SURVEY M166-16
○	FOUND MONUMENT NOTED IN TABLE
★	SET GPS CONTROL POINT

MONUMENT TABLE

IR=IRON REBAR YPC= YELLOW PLASTIC CAP w/=WITH

PT. NO.	STATION	OFFSET	OCRS NORTHING	OCRS EASTING	DATE	DESCRIPTION	REFERENCE DOCUMENT
1004	'10B' 204+57.60	-136.51	139433.77	181173.34	2/1/2024	FOUND YPC "HIBBS LS 52989"	M185-18
1005	'10B' 204+57.62	-97.27	139400.77	181152.10	2/1/2024	FOUND YPC "HIBBS LS 52989"	M185-18
1006	'10B' 204+53.10	-61.00	139372.73	181128.66	2/1/2024	FOUND YPC "HIBBS LS 52989"	M185-18
1007	'10B' 205+17.58	-60.77	139337.61	181182.75	2/1/2024	FOUND IR w/ BROKEN YPC ILLEGIBLE BENT NW TIED SPINHOLE	M185-18
1078	'10B' 184+99.04	51.02	140332.12	179424.68	4/3/2024	FOUND 5/8" IR DOWN 1.0'	1969 COUNTY ROAD MAP
1079	'10B' 183+85.55	54.33	140384.14	179325.91	4/3/2024	FOUND 5/8" IR DOWN 0.2' LEANING NORTHERLY TIED TOP	1969 COUNTY ROAD MAP
1080	'10B' 203+75.18	59.50	139313.60	180997.93	4/3/2024	FOUND 5/8" IR DOWN 0.4'	1969 COUNTY ROAD MAP
1081	'10B' 205+00.10	60.03	139245.53	181102.64	4/3/2024	FOUND 5/8" IR DOWN 0.2' LEANING SLIGHTLY SOUTH	1969 COUNTY ROAD MAP
1082	'10B' 221+00.26	49.53	138387.87	182453.58	4/3/2024	FOUND 5/8" IR DOWN 0.2' LEANING NORTHEAST SHOT SPINHOLE	1969 COUNTY ROAD MAP
1083	'10B' 229+50.23	59.93	137918.87	183162.52	4/3/2024	FOUND 5/8" IR DOWN 0.5'	1969 COUNTY ROAD MAP
1084	'10B' 229+50.35	-59.93	138019.57	183227.53	4/3/2024	FOUND 5/8" IR DOWN 0.6' w/METAL T-POST CRRW 229+50 60'	1969 COUNTY ROAD MAP
1085	'10B' 209+59.96	-60.49	139097.83	181554.51	4/3/2024	FOUND 5/8" IR DOWN 0.4'	1969 COUNTY ROAD MAP
1086	'10B' 188+05.56	-59.21	140263.36	179742.60	4/3/2024	FOUND 5/8" IR LEANING SOUTHERLY SHOT AT SPINHOLE	1969 COUNTY ROAD MAP
1214	'10B' 199+50.50	55.00	139547.36	180643.31	1/28/2025	FOUND 5/8" IR	1969 COUNTY ROAD MAP
1215	'10B' 201+00.12	99.22	139429.16	180745.16	1/28/2025	FOUND 5/8" IR, BENT NORTHERLY, TIED SPINHOLE	1969 COUNTY ROAD MAP
1216	'10B' 202+00.21	-61.06	139509.71	180916.09	1/28/2025	FOUND 5/8" IR, BENT NORTHERLY, TIED SPINHOLE	1969 COUNTY ROAD MAP

N

100' 50' 0' 100'
FEET

REGISTERED PROFESSIONAL LAND SURVEYOR

OREGON
MARCH 14, 2017
ZACHARY P. EARLE
91474

EXPIRES: 12/31/2025

OREGON DEPARTMENT OF TRANSPORTATION

HORIZONTAL CONTROL, RECOVERY AND RETRACEMENT MAP
SOUTHWEST OREGON 2024-2027 ADA CURB RAMP DESIGN, PHASE 2 (ROSEBURG)
(OR138E) NORTH UMPQUA HIGHWAY
DOUGLAS COUNTY

ODOT REGION 3 TECH CENTER
100 ANTELOPE RD.
WHITE CITY, OR 97503 KEY NO. 23069

MARCH 31, 2025
1"=100'
SHEET 4 OF 4

ST. HWY. 138-020 D