MAP FILE M129-32C

METRIC

HORIZONTAL CONTROL AND RECOVERY MAP

LOCATED IN THE SW 1/4 & NW 1/4 OF SECTION 17,
THE NE 1/4 OF SECTION 18, THE SE 1/4 OF SECTION 7,
AND THE NW 1/4 & SW 1/4 OF SECTION 8, T. 24 S., R. 5 W., W.M.
DOUGLAS COUNTY

FILED
Date: 1-27-1999 By: JP
This survey consists of: 5 SHEETS
Map: M129-32C
Narrative:
Corner Rpt:
DOUGLAS COUNTY SURVEYOR CB

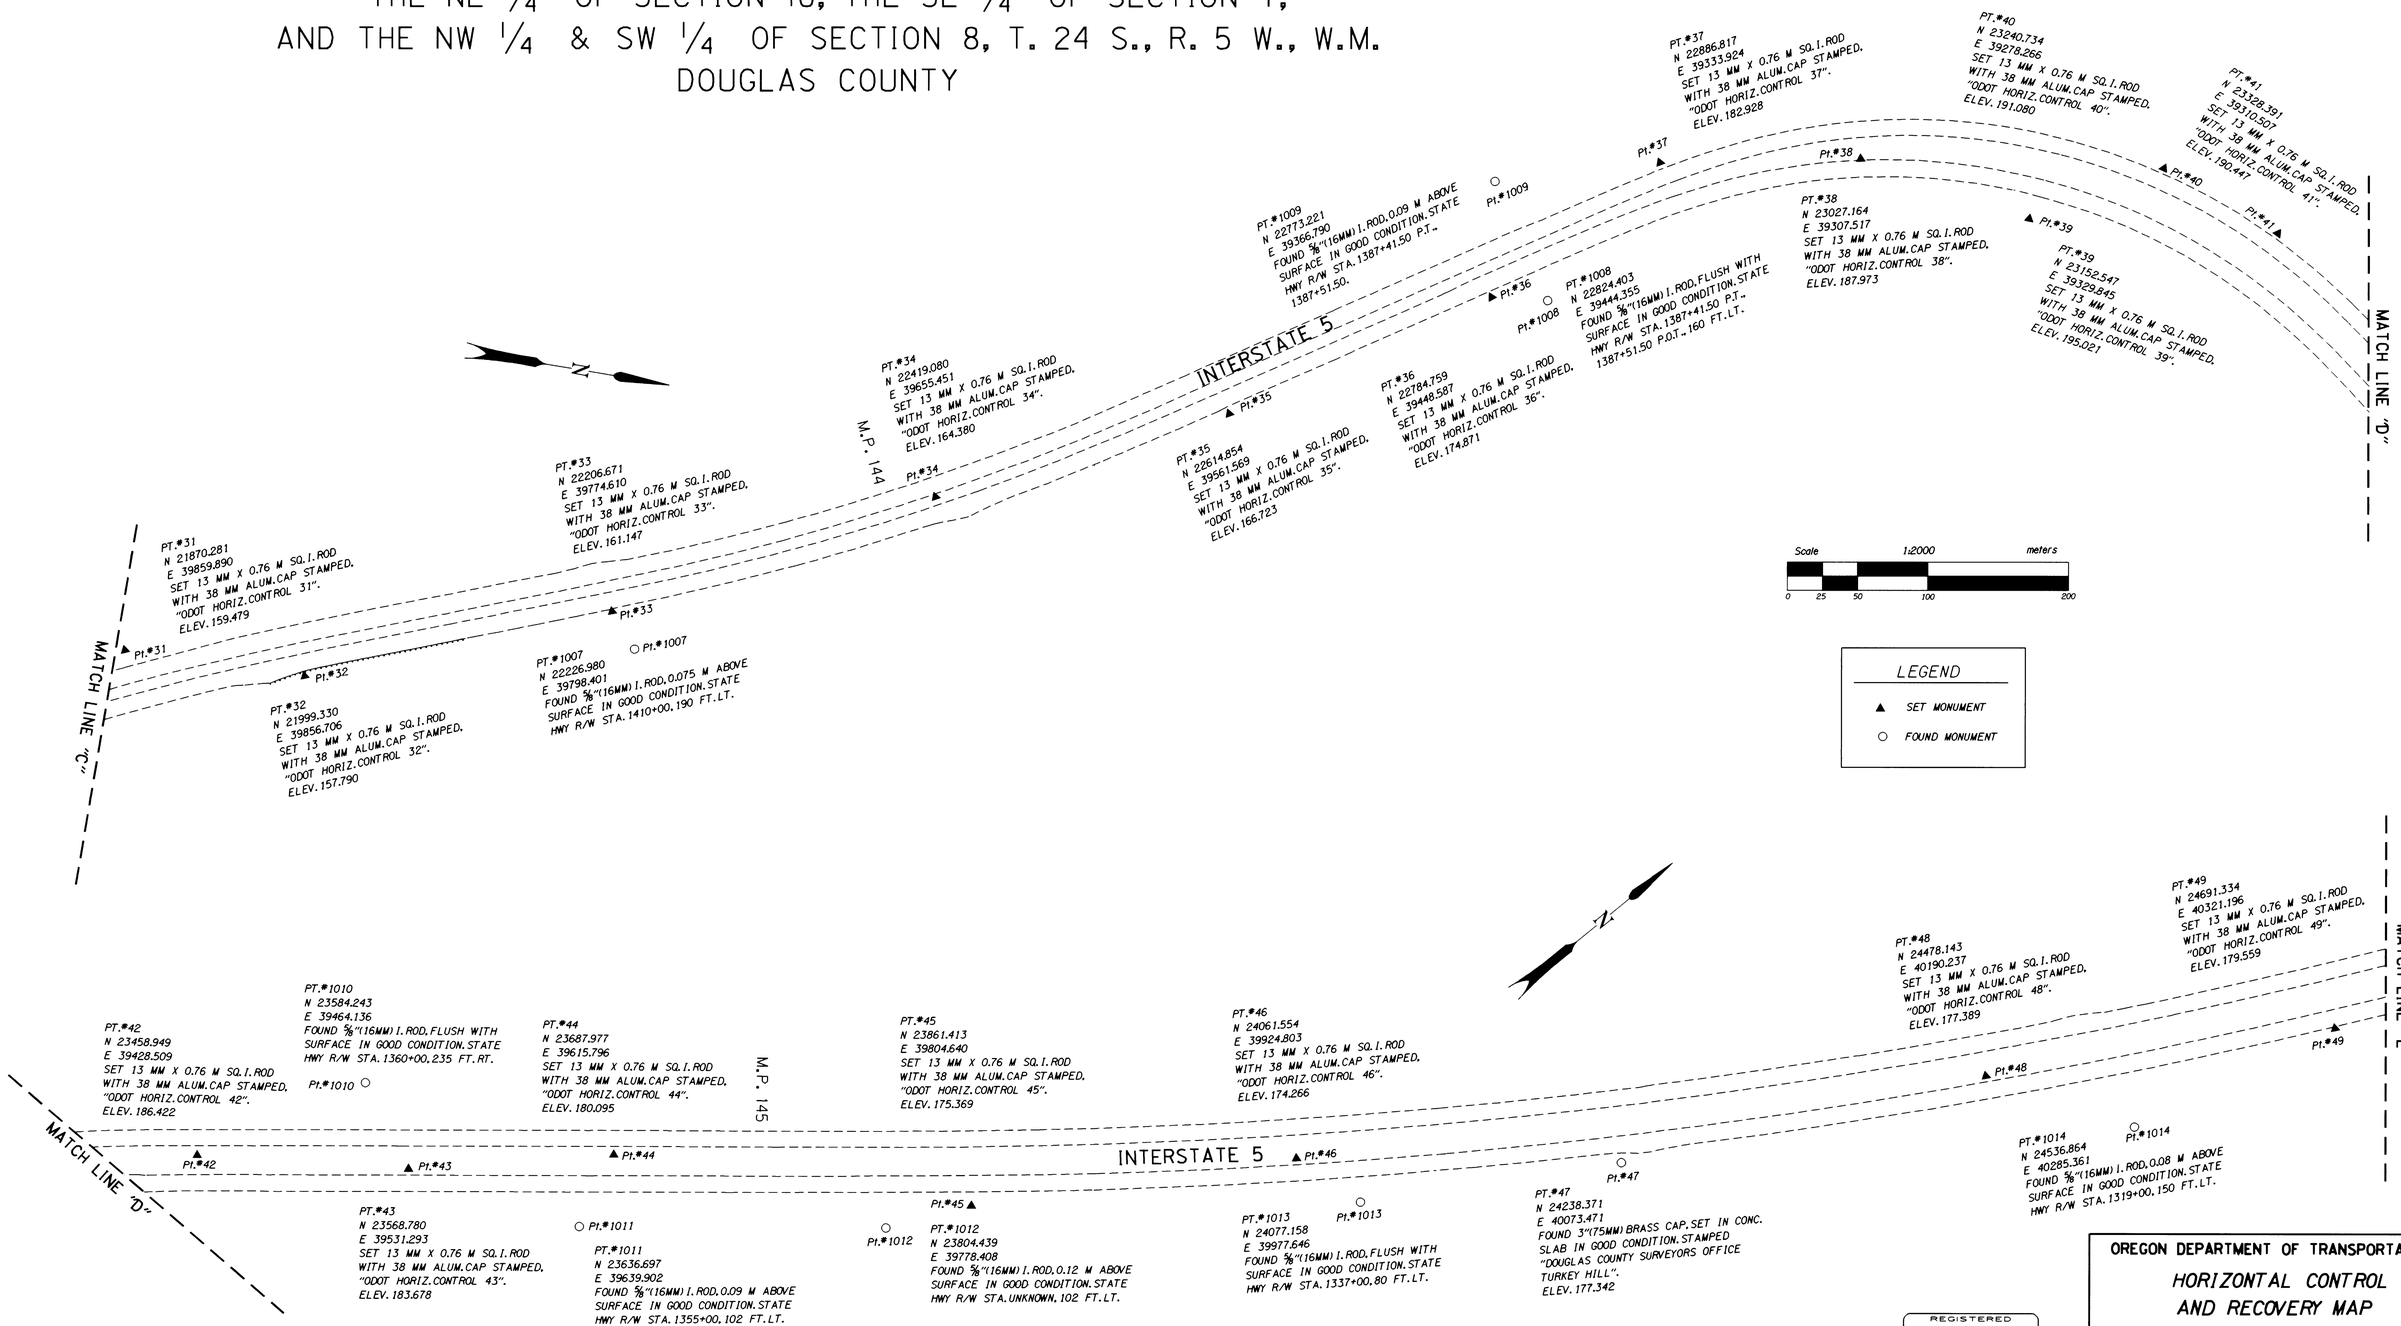

REGISTERED PROFESSIONAL LAND SURVEYOR
Christine V. Blevins
OREGON JULY 19, 1994 CHRISTINE V. BLEVINS 2669
EXPIRES : DEC. 31, 1999

OREGON DEPARTMENT OF TRANSPORTATION
HORIZONTAL CONTROL AND RECOVERY MAP
N. OAKLAND INTCH. - RICE HILL SECTION
INTERSTATE 5
DOUGLAS COUNTY
ODOT
3500 Stewart Parkway, Suite 140
Roseburg, Oregon 97470
PROJECT KEY #08711 SHEET 3 OF 5

COUNTY SURVEYORS FILE DATA
DO NOT REMOVE FROM OFFICE

ST. HWY. 15-00IC

MAP FILE M129-32C