COUNTY SURVEYORS FILE DATA
DO NOT REMOVE FROM OFFICE

SW 1/4 SEC. 25 & SE 1/4 SEC. 26, T. 27 S., R. 6 W., W .M.

FILED
Date: 12/21/1999 By: JP
This survey consists of: 12 SHEETS
Map: M133-75G
Narrative:
Corner Rpt:
DOUGLAS COUNTY
JP SURVEYOR

MAP FILE M133-75G.

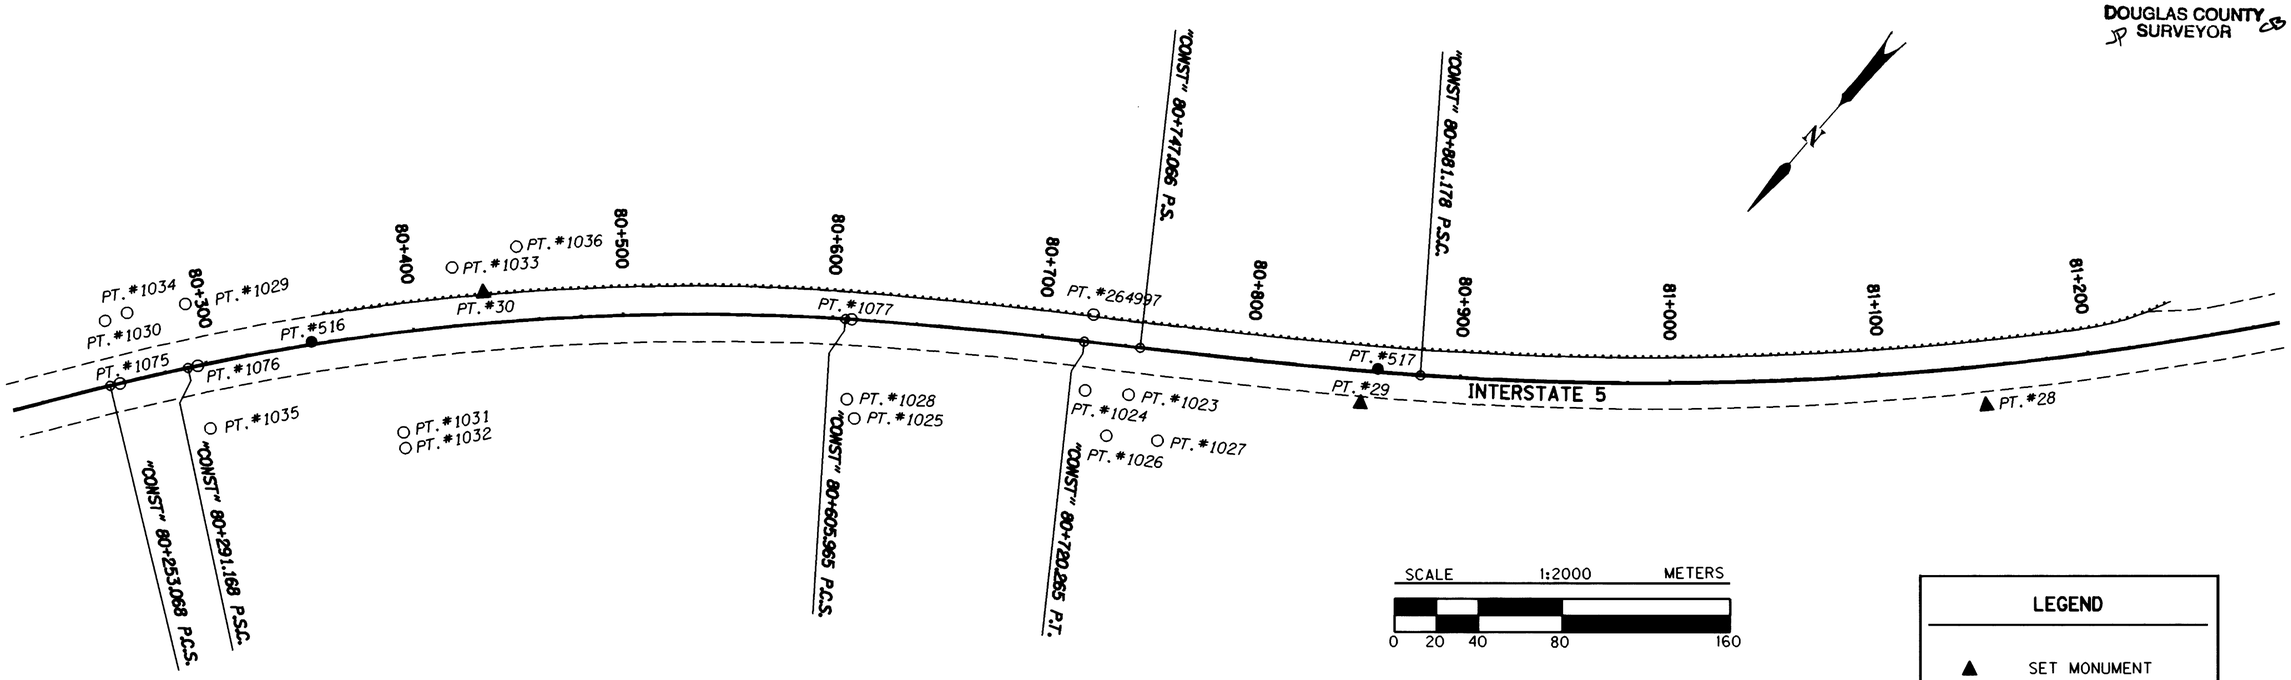

SCALE 1:2000 METERS
0 20 40 80 160

R/W = RIGHT OF WAY
RP = REFERENCE POINT
C.L. = CENTER LINE
PT. = POINT

LEGEND

- ▲ SET MONUMENT
- ○ FOUND MONUMENT
- ● SET AUX. MONUMENT
- CONCRETE BARRIER
- CURB
- EDGE OF PAVEMENT
- FENCE
- GUARDRAIL

CONTROL NETWORK AND FOUND MONUMENTS

POINT	NORTHING	EASTING	DESCRIPTION
28	173032.761	376445.347	SET 16 MM X 762 MM IRON REBAR WITH 38 MM BRASS CAP STAMPED "ODOT CONTROL 28".
29	173227.309	376671.508	SET 16 MM X 762 MM IRON REBAR WITH 38 MM BRASS CAP STAMPED "ODOT CONTROL 29".
30	173460.690	377021.918	SET 16 MM X 540 MM IRON REBAR WITH 38 MM BRASS CAP STAMPED "ODOT CONTROL 30".
264997	173279.300	376794.624	FOUND 5/8" (16 MM) IRON REBAR WITH 1 1/2" (38 MM) ALUM. CAP STAMPED "OREG. STATE HWY. DIV." 200 MM ABOVE SURFACE IN GOOD CONDITION. RP STA. "CONST" 2649+97.16 P.T., 43.91 FT. LT.
1023	173297.283	376757.060	FOUND 5/8" (16 MM) IRON REBAR WITH 1 1/2" (38 MM) ALUM. CAP STAMPED "OREG. STATE HWY. DIV." RP STA. "CONST" 2650+65.38 P.S., 74.55 FT. RT.
1024	173309.316	376773.995	FOUND 5/8" (16 MM) IRON REBAR WITH 1 1/2" (38 MM) ALUM. CAP STAMPED "OREG. STATE HWY. DIV." RP STA. "CONST" 2649+97.16 P.T., 75.57 FT. RT.
1025	173391.315	376848.363	FOUND 5/8" (16 MM) IRON ROD 110 MM ABOVE SURFACE IN GOOD CONDITION. R/W STA. 2646+23.55 P.C.S., 125 FT. RT.
1026	173319.056	376752.218	FOUND 5/8" (16 MM) IRON ROD 350 MM ABOVE SURFACE. R/W STA. 2650+23.55 P.T., 125 FT. RT.
1027	173304.946	376732.295	FOUND 5/8" (16 MM) IRON ROD 70 MM ABOVE SURFACE IN GOOD CONDITION. R/W STA. 2651+03.79 P.S., 125 FT. RT.
1028	173386.736	376856.994	FOUND 5/8" (16 MM) IRON ROD WITH 1 1/2" (38 MM) ALUM. CAP STAMPED "OREG. STATE HWY. DIV. L PCS" 140 MM ABOVE SURFACE IN GOOD CONDITION. RP STA. "CONST" 2646+22.16 P.C.S., 170.53 FT. RT.
1029	173558.311	377125.164	FOUND 1 1/2" (38 MM) ALUM. CAP STAMPED "OREG. STATE HWY. DIV. L PSC" FLUSH WITH SURFACE. RP STA. "CONST" 2635+94.94 P.S.C., 99.13 FT. LT.
1030	173589.447	377148.831	FOUND 1 1/2" (38 MM) ALUM. CAP STAMPED "OREG. STATE HWY. DIV. L PCS" FLUSH WITH SURFACE. RP STA. "CONST" 2634+69.94 P.C.S., 100.77 FT. LT.
1031	173536.762	377006.234	FOUND 5/8" (16 MM) IRON ROD 150 MM ABOVE SURFACE IN GOOD CONDITION. R/W STA. 2639+00, 125 FT. RT.
1032	173541.852	377000.673	FOUND 5/8" (16 MM) IRON ROD BENT, POOR CONDITION. TIED WHERE PIN ENTERS GROUND. R/W STA. 2639+00, 150 FT. RT.
1033	173462.065	377040.363	FOUND 5/8" (16 MM) IRON ROD WITH 1 1/2" (38 MM) ALUM. CAP STAMPED "OREG. STATE HWY. DIV." FLUSH WITH SURFACE. R/W STA. 2640+00, 125 FT. LT.
1034	173579.696	377143.399	FOUND 1 1/2" (38 MM) ALUM. CAP STAMPED "OREG. STATE HWY. DIV." FLUSH WITH SURFACE. STA. 2635+00, 125 FT. LT.
1035	173595.409	377077.228	FOUND 5/8" (16 MM) IRON REBAR WITH 1 1/2" (38 MM) ALUM. CAP STAMPED "OREG. STATE HWY. DIV. L PSC". RP STA. "CONST" 2635+94.94 P.S.C., 99.70 FT. RT.
1036	173434.511	377023.680	FOUND 5/8" (16 MM) IRON ROD WITH 1 1/2" (38 MM) ALUM. CAP STAMPED "OREG. STATE HWY. DIV." 30 MM ABOVE SURFACE IN GOOD CONDITION. R/W STA. 2641+00, 150 FT. LT.
1075	173607.415	377123.906	FOUND 3/4" (19 MM) BRASS PLUG SET IN TOP OF CONC. MEDIAN BARRIER. STA. "CONST" 2623+69.94 P.C.S., AT C.L.
1076	173576.829	377101.268	FOUND 3/4" (19 MM) BRASS PLUG SET IN TOP OF CONC. MEDIAN BARRIER. STA. "CONST" 2635+94.94 P.S.C., AT C.L.
1077	173356.427	376880.269	FOUND 3/4" (19 MM) BRASS PLUG SET IN TOP OF CONC. MEDIAN BARRIER. STA. "CONST" 2646+22.16 P.C.S., AT C.L.
516	173532.902	377067.663	SET PK NAIL AND SHINER.
517	173210.399	376675.326	SET PK NAIL AND SHINER.

REGISTERED
PROFESSIONAL
LAND SURVEYOR
Christine V. Elevins
OREGON
JULY 15, 1994
CHRISTINE V. ELEVINS
2649
EXPIRES: DEC. 31, 1999

METRIC SURVEY
1 METER = 3937 U.S. FEET / 1200
TO CONVERT A METRIC DISTANCE DIVIDE BY 0.30480061

OREGON DEPARTMENT OF TRANSPORTATION

HORIZONTAL CONTROL AND RECOVERY MAP

GARDEN VALLEY - ROBERTS CREEK SEC.
INTERSTATE 5

3500 STEWART PARKWAY, SUITE 140
ROSEBURG, OREGON 97470

PROJECT KEY #09108 SHEET 7 OF 12

MAP FILE M133-75G

ST. HWY. I5-006G