


SECTION 22, T32S, R5W, W.M.

FILED
 Date: 12/3/2001 By: JP
 This survey consists of: 5 SHEETS
 Map: ST. HWY. 15-011 D
 Narrative:
 Corner Rpt:

DOUGLAS COUNTY
 SURVEYOR

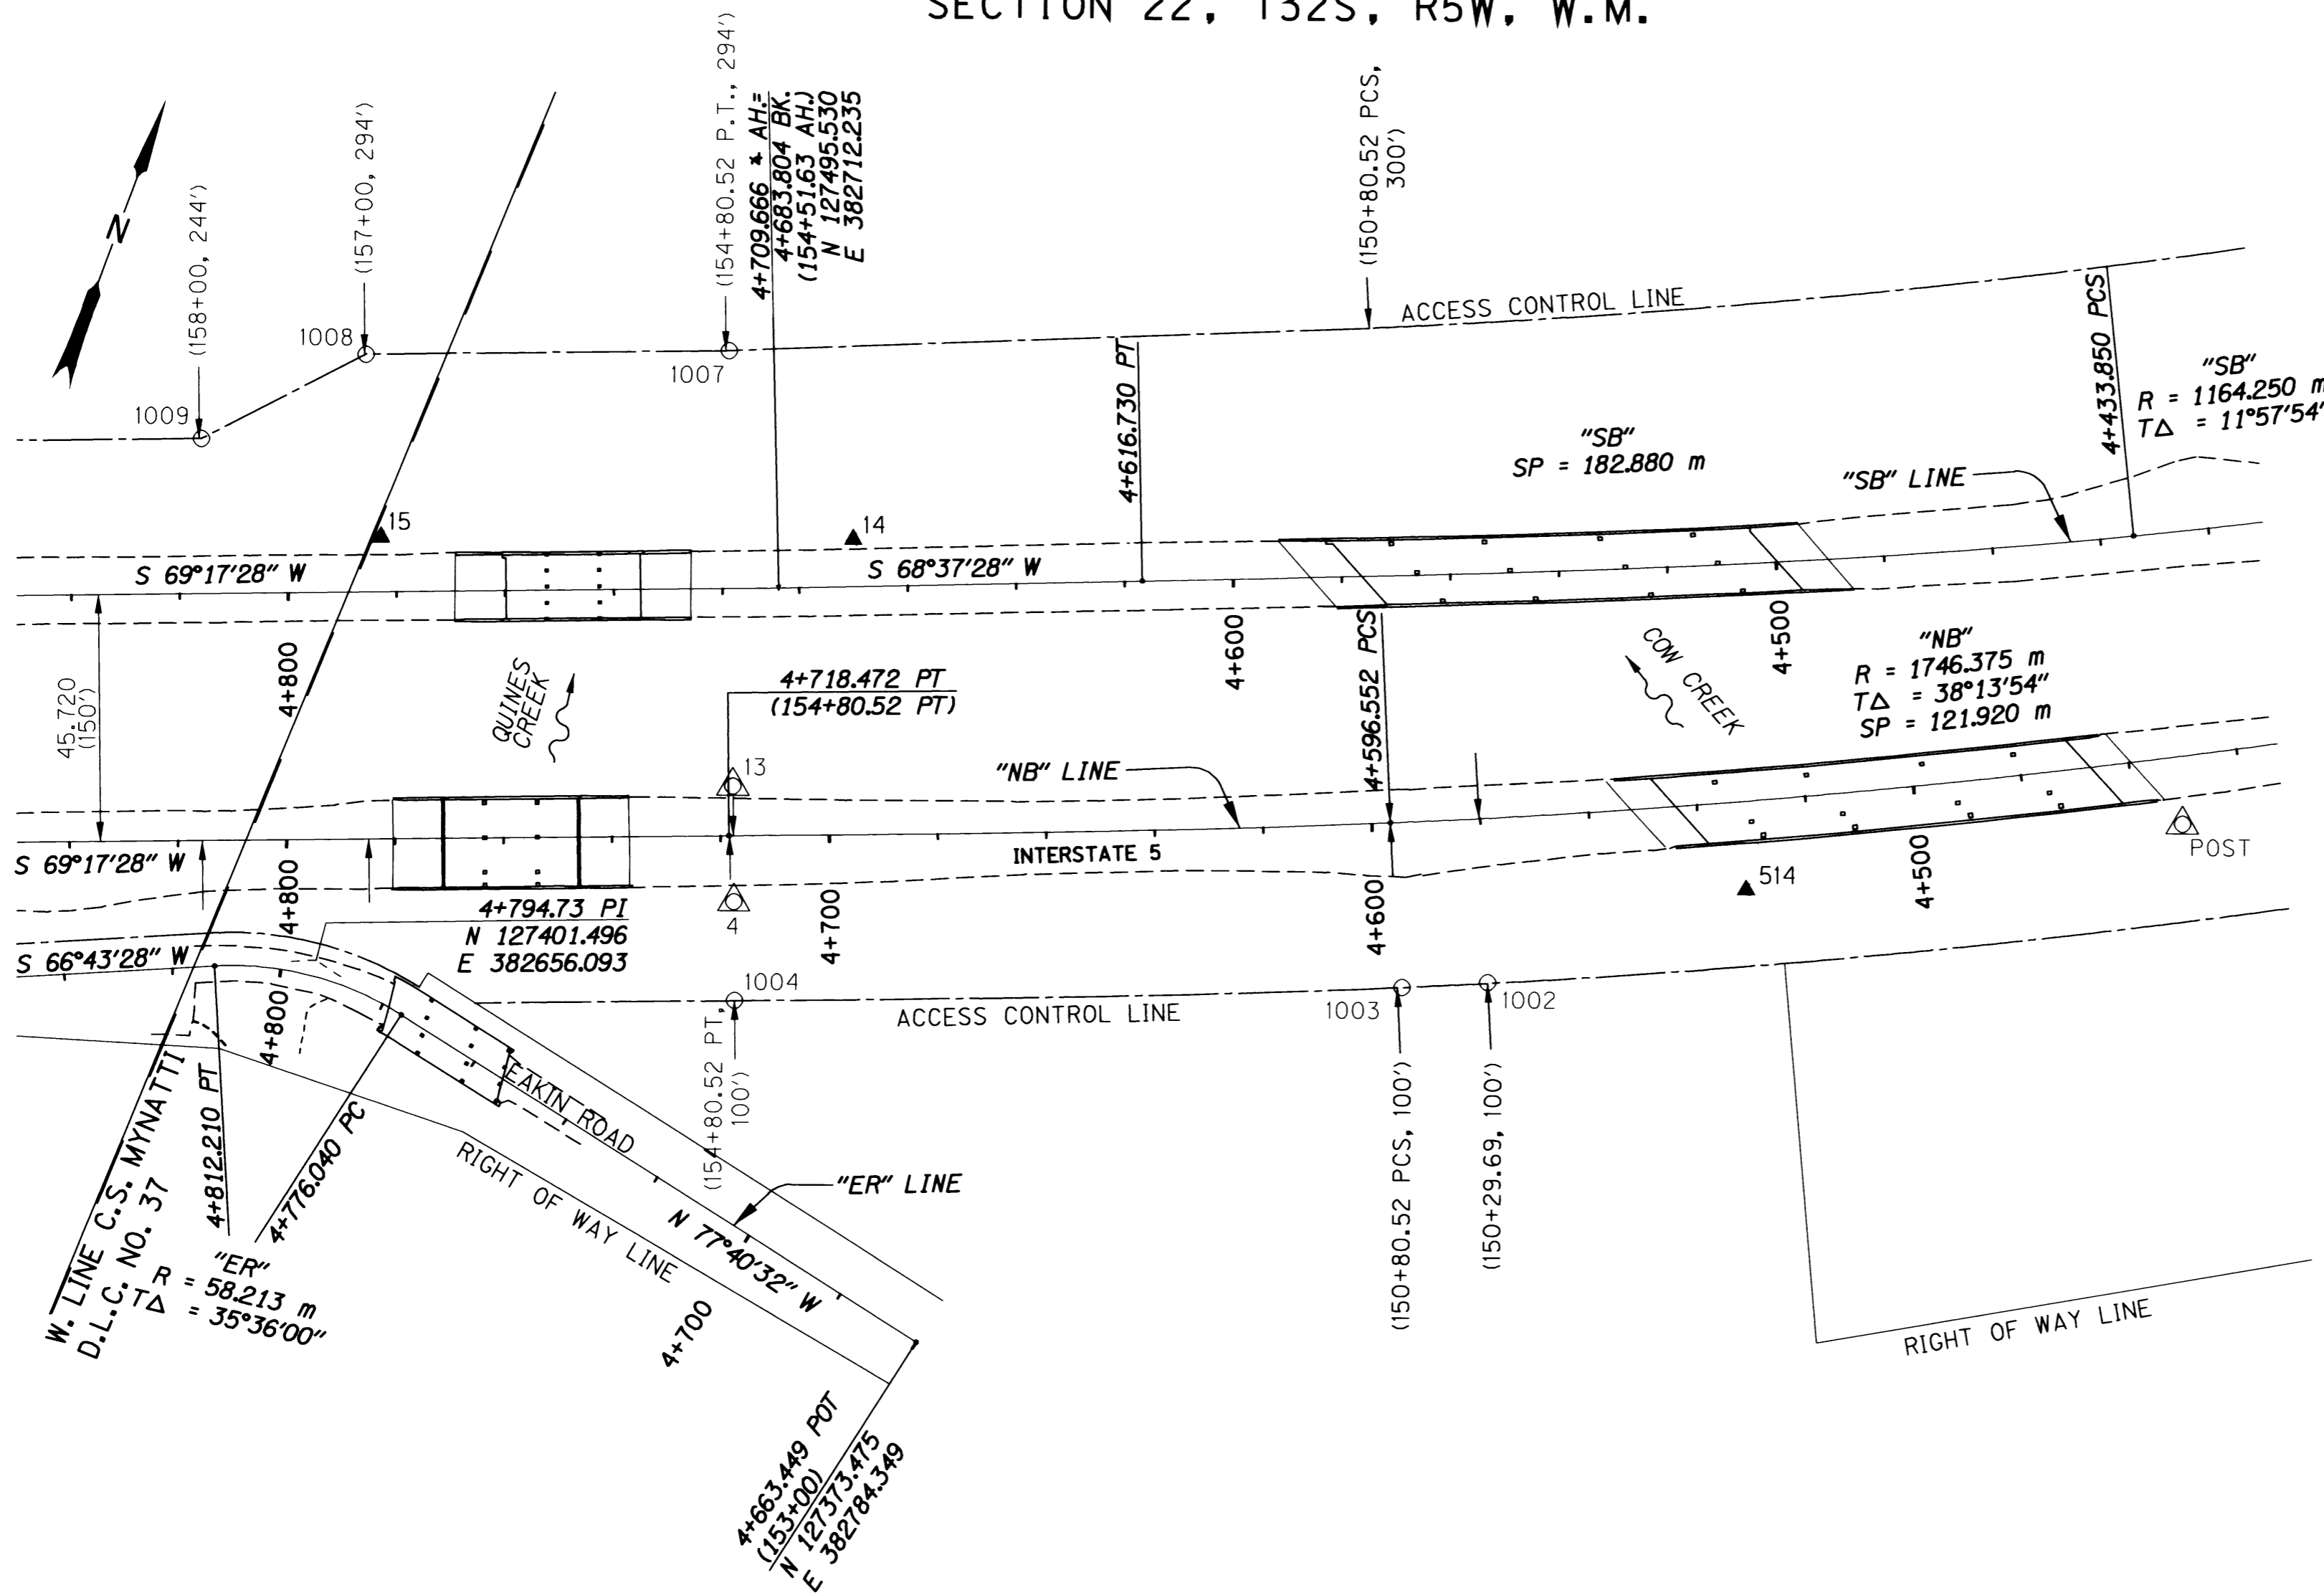


LEGEND	
()	RECORD DATA PER ODOT DRG. NO. 8B-30-20
○	FOUND MONUMENT NOTED IN TABLE
▲	NETWORK POINT
△	FOUND MONUMENT USED AS NETWORK POINT
---	EDGE OF PAVEMENT
- - -	ACCESS CONTROL LINE
—	PROPERTY LINE

REGISTERED
 PROFESSIONAL
 LAND SURVEYOR
 Christine V. Blevins
 OREGON
 JULY 19, 1994
 CHRISTINE V. BLEVINS
 02669LS
 EXPIRES 12/31/01

RECOVERED MONUMENT LIST

PT. NO.	LDP NORTHING	LDP EASTING	STATION	OFFSET	DATE	DESCRIPTION & REFERENCE DOCUMENTS
1002	127472.304	382860.056	4+580.222	-30.372	9-20-01	FND. 5/8" IRON ROD W/1/2" ALUM. CAP STAMPED "OREG. STATE HWY. DEPT." 110 mm ABOVE SURFACE, GOOD CONDITION, PADDLE BOARD NEARBY MARKED "SHRW POC 150+29.69 100". (REF. ODOT DRG. NO. 8B-30-20)
1003	127466.050	382845.601	4+595.702	-30.483	9-20-01	FND. 5/8" IRON ROD W/1/2" ALUM. CAP STAMPED "OREG. STATE HWY. DEPT." 150 mm ABOVE SURFACE, GOOD CONDITION, PADDLE BOARD NEARBY MARKED "SHRW PCS 150+80.52 100". (REF. ODOT DRG. NO. 8B-30-20)
1004	127421.186	382731.072	4+717.633	-30.481	9-20-01	FND. 5/8" IRON ROD W/1/2" ALUM. CAP STAMPED "OREG. STATE HWY. DEPT." 40 mm BELOW SURFACE, GOOD CONDITION, PADDLE BOARD NEARBY MARKED "SHRW PT 154+80.52 100". (REF. ODOT DRG. NO. 8B-30-20)
1007	127533.495	382688.536	4+717.706	89.613	9-20-01	FND. 5/8" IRON ROD W/1/2" ALUM. CAP STAMPED "OREG. STATE HWY. DEPT." 30 mm BELOW SURFACE, GOOD CONDITION. (REF. ODOT DRG. NO. 8B-30-20)
1008	127509.758	382626.000	4+784.595	89.523	9-24-01	FND. 5/8" IRON ROD W/1/2" ALUM. CAP STAMPED "OREG. STATE HWY. DEPT." 50 mm BELOW SURFACE, GOOD CONDITION, PADDLE BOARD NEARBY MARKED "SHRW POT 157+00 294". (REF. ODOT DRG. NO. 8B-30-20)

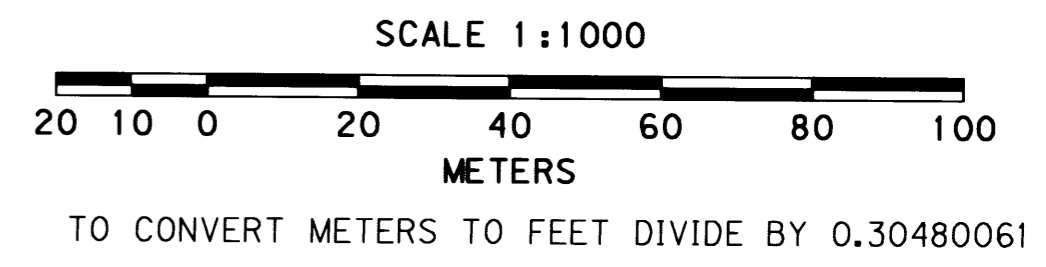

OREGON DEPARTMENT OF TRANSPORTATION
 HORIZONTAL CONTROL, RECOVERY AND RETRACEMENT MAP
 COW CREEK & QUINES CREEK BRIDGES
 PACIFIC HIGHWAY (INTERSTATE 5)
 DOUGLAS COUNTY
 NOVEMBER 27, 2001 FOR ODOT REGION 3
 3500 NW STEWART PKWY., ROSEBURG, OR 97470
 SCALE: 1 mm = 1 m SHEET 4 OF 5