ENGLISH

NW 1/4 SECTION 27, NE 1/4 SECTION 28, T30S, R5W, W.M.

FILED
Date: 2/13/2004 By: JP
This survey consists of:
Map: ST. HWY. I5-015 I
Narrative:
Corner Rpt:
DOUGLAS COUNTY SURVEYOR

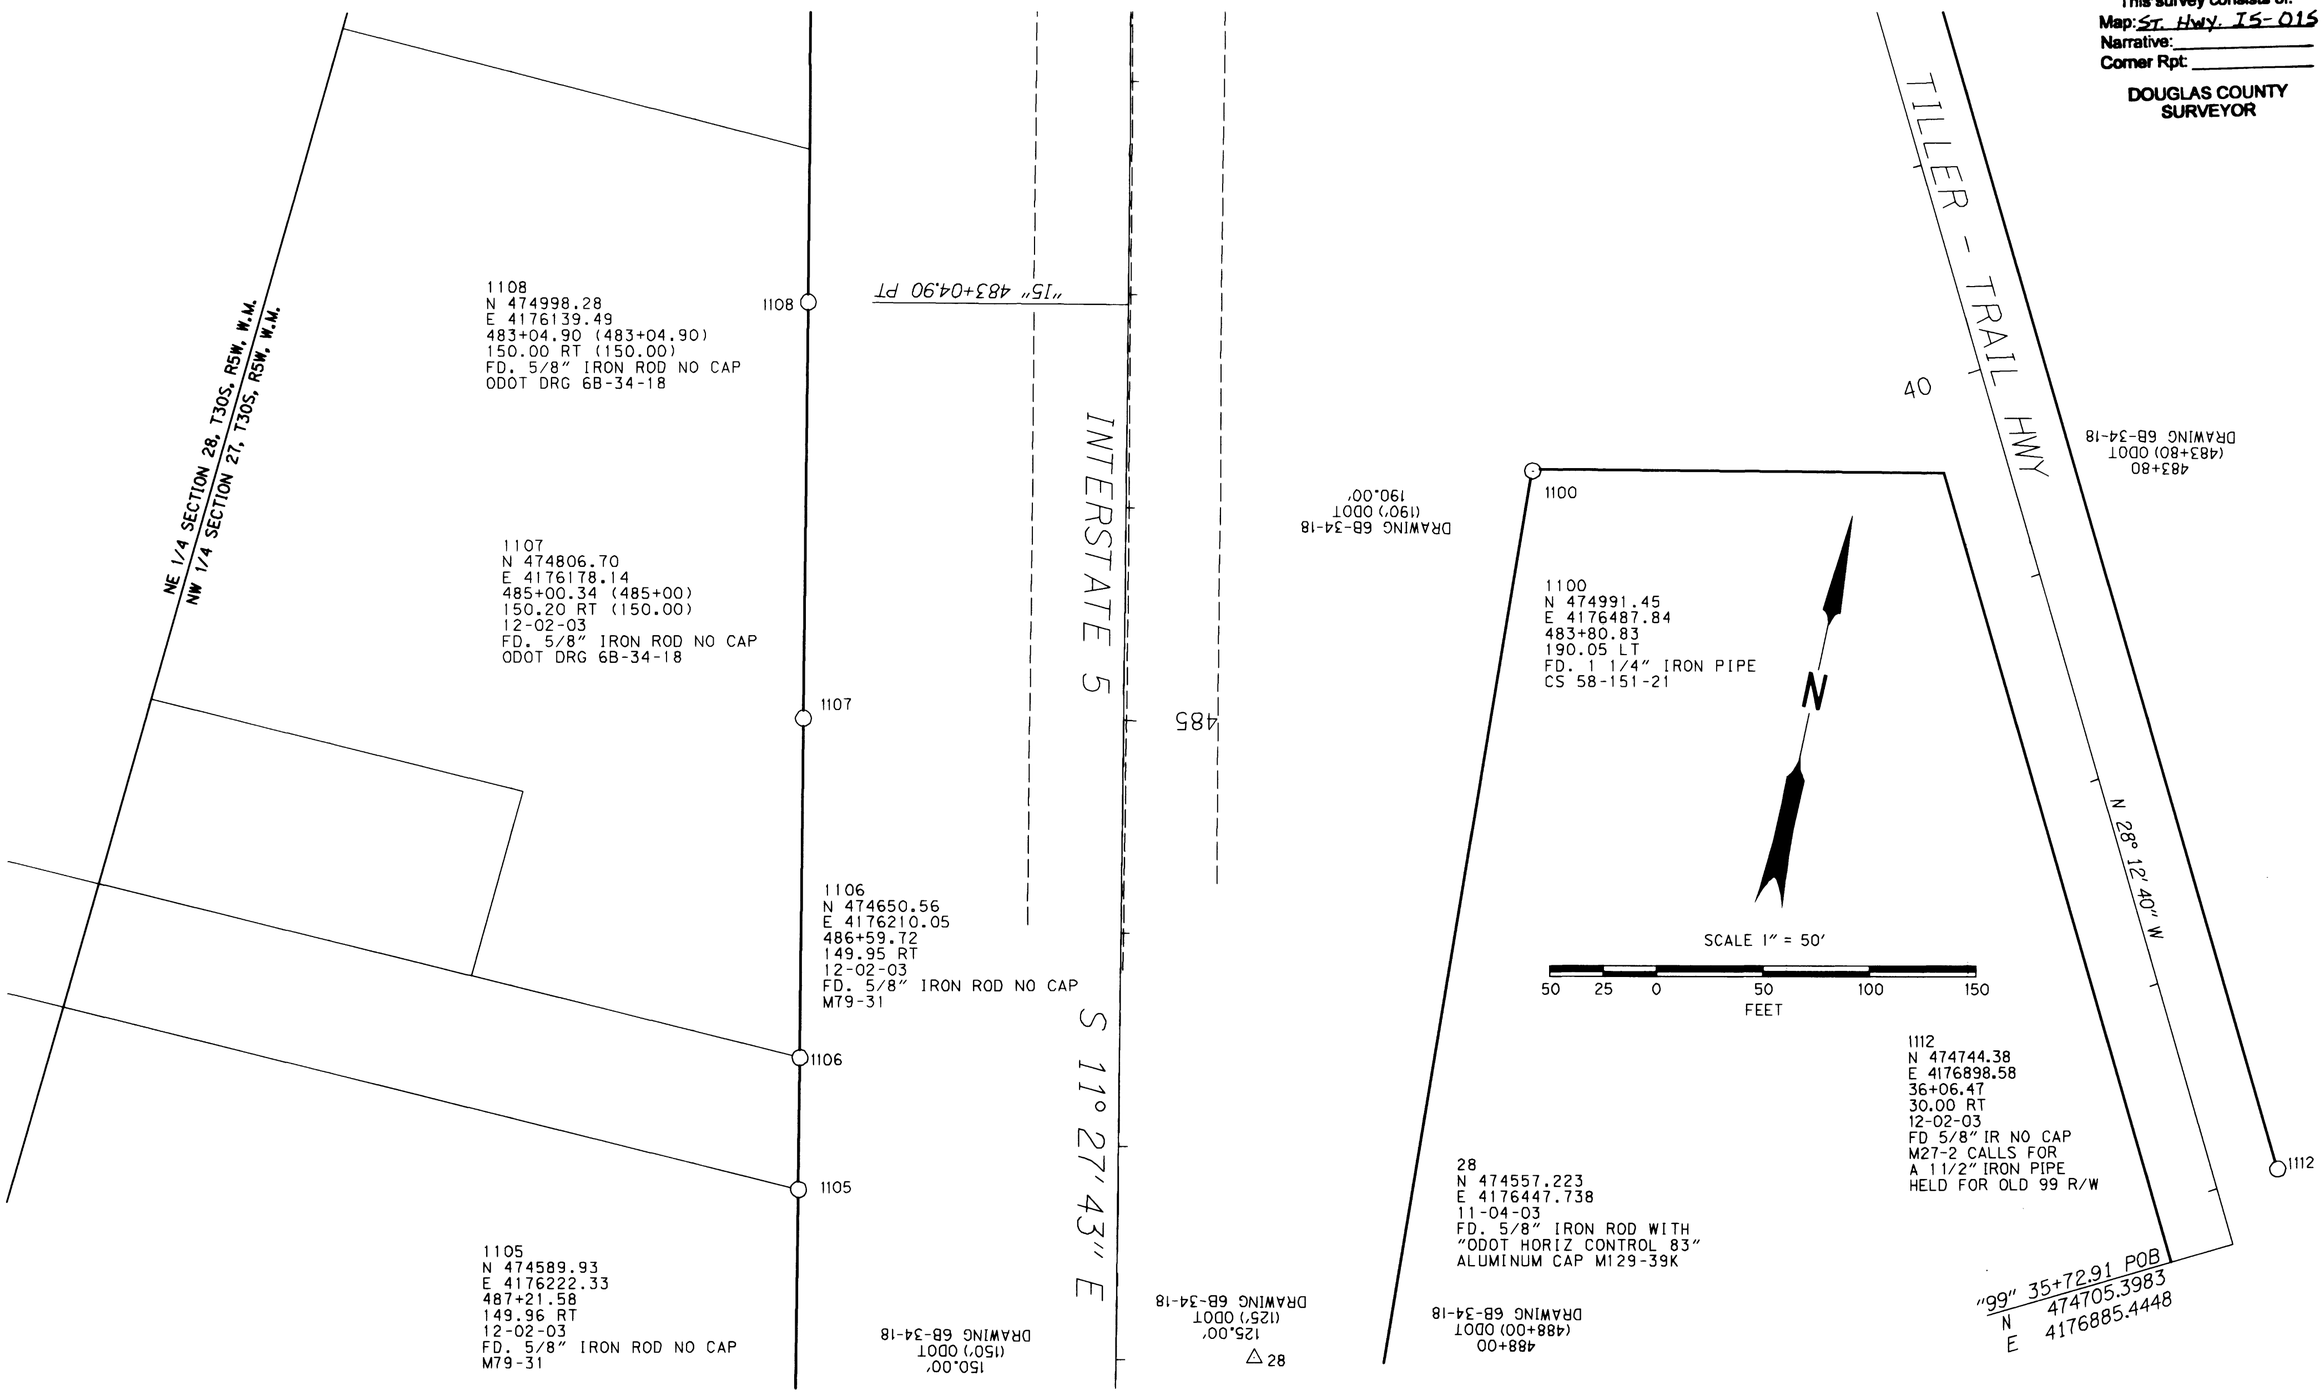

LEGEND

- ▲ SET NETWORK POINT AS NOTED
- △ FOUND NETWORK POINT AS PER M129-39
- ○ FOUND MONUMENT AS NOTED
- RESOLVED RIGHT OF WAY LINE
- EDGE OF PAVEMENT
- TOP OF CURB

REGISTERED PROFESSIONAL LAND SURVEYOR
OREGON JULY 25, 1991 JODY S. FRASIER 2498
EXPIRES 12-31-2005

OREGON DEPARTMENT OF TRANSPORTATION

HORIZONTAL CONTROL, RECOVERY AND RETRACTMENT MAP
INTERSTATE 5 AT EXIT 99
DOUGLAS COUNTY, OREGON

FEBRUARY 2004 — FOR ODOT REGION 3

3500 NW STEWART PARKWAY, ROSEBURG, OR 97470

SCALE 1" = 50' — SHEET 9 OF 10

ST. HWY. I5-015I