FILED
Date: 4-15-2004 By: JC
This survey consists of:
Map: ST HWY 15-016 A-K
Name(s):
Corner Rpt:
DOUGLAS COUNTY SURVEYOR

SW 1/4 & SE 1/4 SEC. 24
AND NW 1/4 & NE 1/4 SEC. 25, T. 26 S., R. 6 W., W.M.

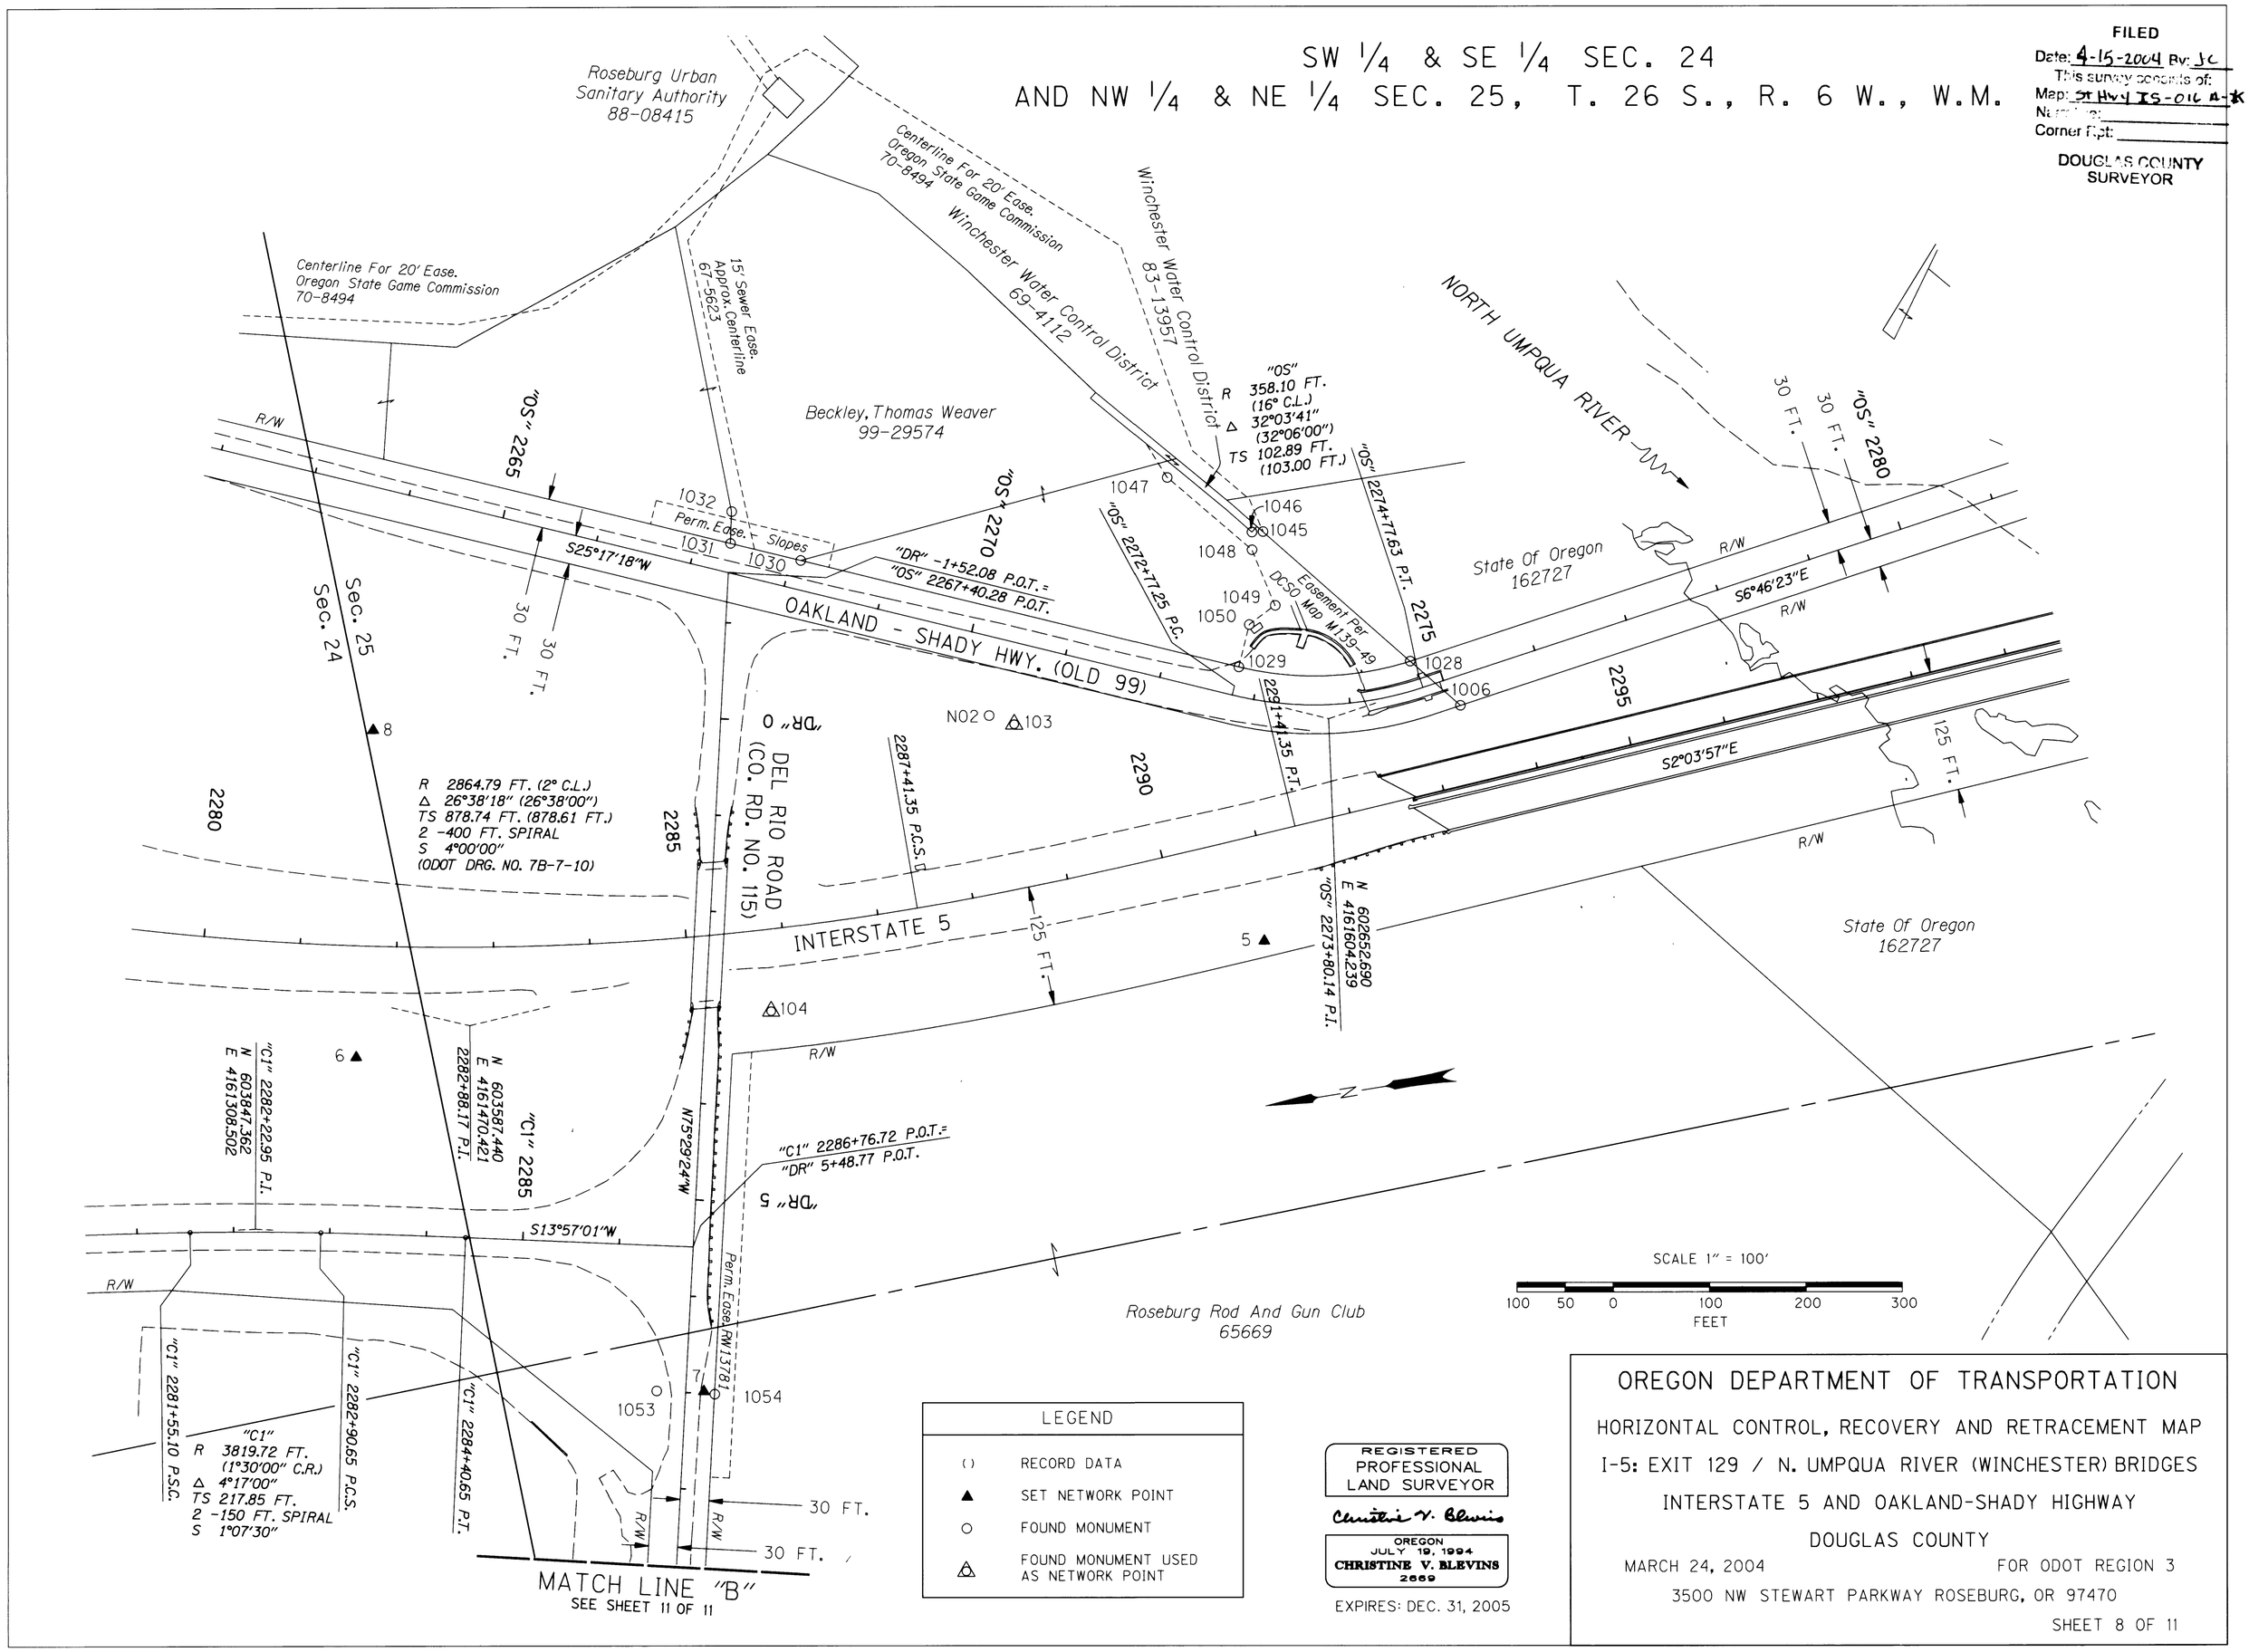

LEGEND	
( )	RECORD DATA
▲	SET NETWORK POINT
○	FOUND MONUMENT
△	FOUND MONUMENT USED AS NETWORK POINT

REGISTERED PROFESSIONAL LAND SURVEYOR
Christine V. Blevins
OREGON JULY 19, 1994 CHRISTINE V. BLEVINS 2669
EXPIRES: DEC. 31, 2005

OREGON DEPARTMENT OF TRANSPORTATION

HORIZONTAL CONTROL, RECOVERY AND RETRACEMENT MAP

I-5: EXIT 129 / N. UMPQUA RIVER (WINCHESTER) BRIDGES

INTERSTATE 5 AND OAKLAND-SHADY HIGHWAY

DOUGLAS COUNTY

MARCH 24, 2004 — FOR ODOT REGION 3

3500 NW STEWART PARKWAY ROSEBURG, OR 97470

SHEET 8 OF 11

ST. HWY. 15-016H