SW 1/4 SEC. 35, T. 33 S., R. 6 W., W.M.
SE 1/4 SEC. 35, T. 33 S., R. 6 W., W.M.

COUNTY SURVEYORS FILE DATA
DO NOT REMOVE FROM OFFICE

FILED
Date: 10/19/2010 By: JC
This survey contains of:
Maps: ST HWY
Narrative: I5-024
Corner Rpt: A- & GG
DOUGLAS COUNTY
SURVEYOR

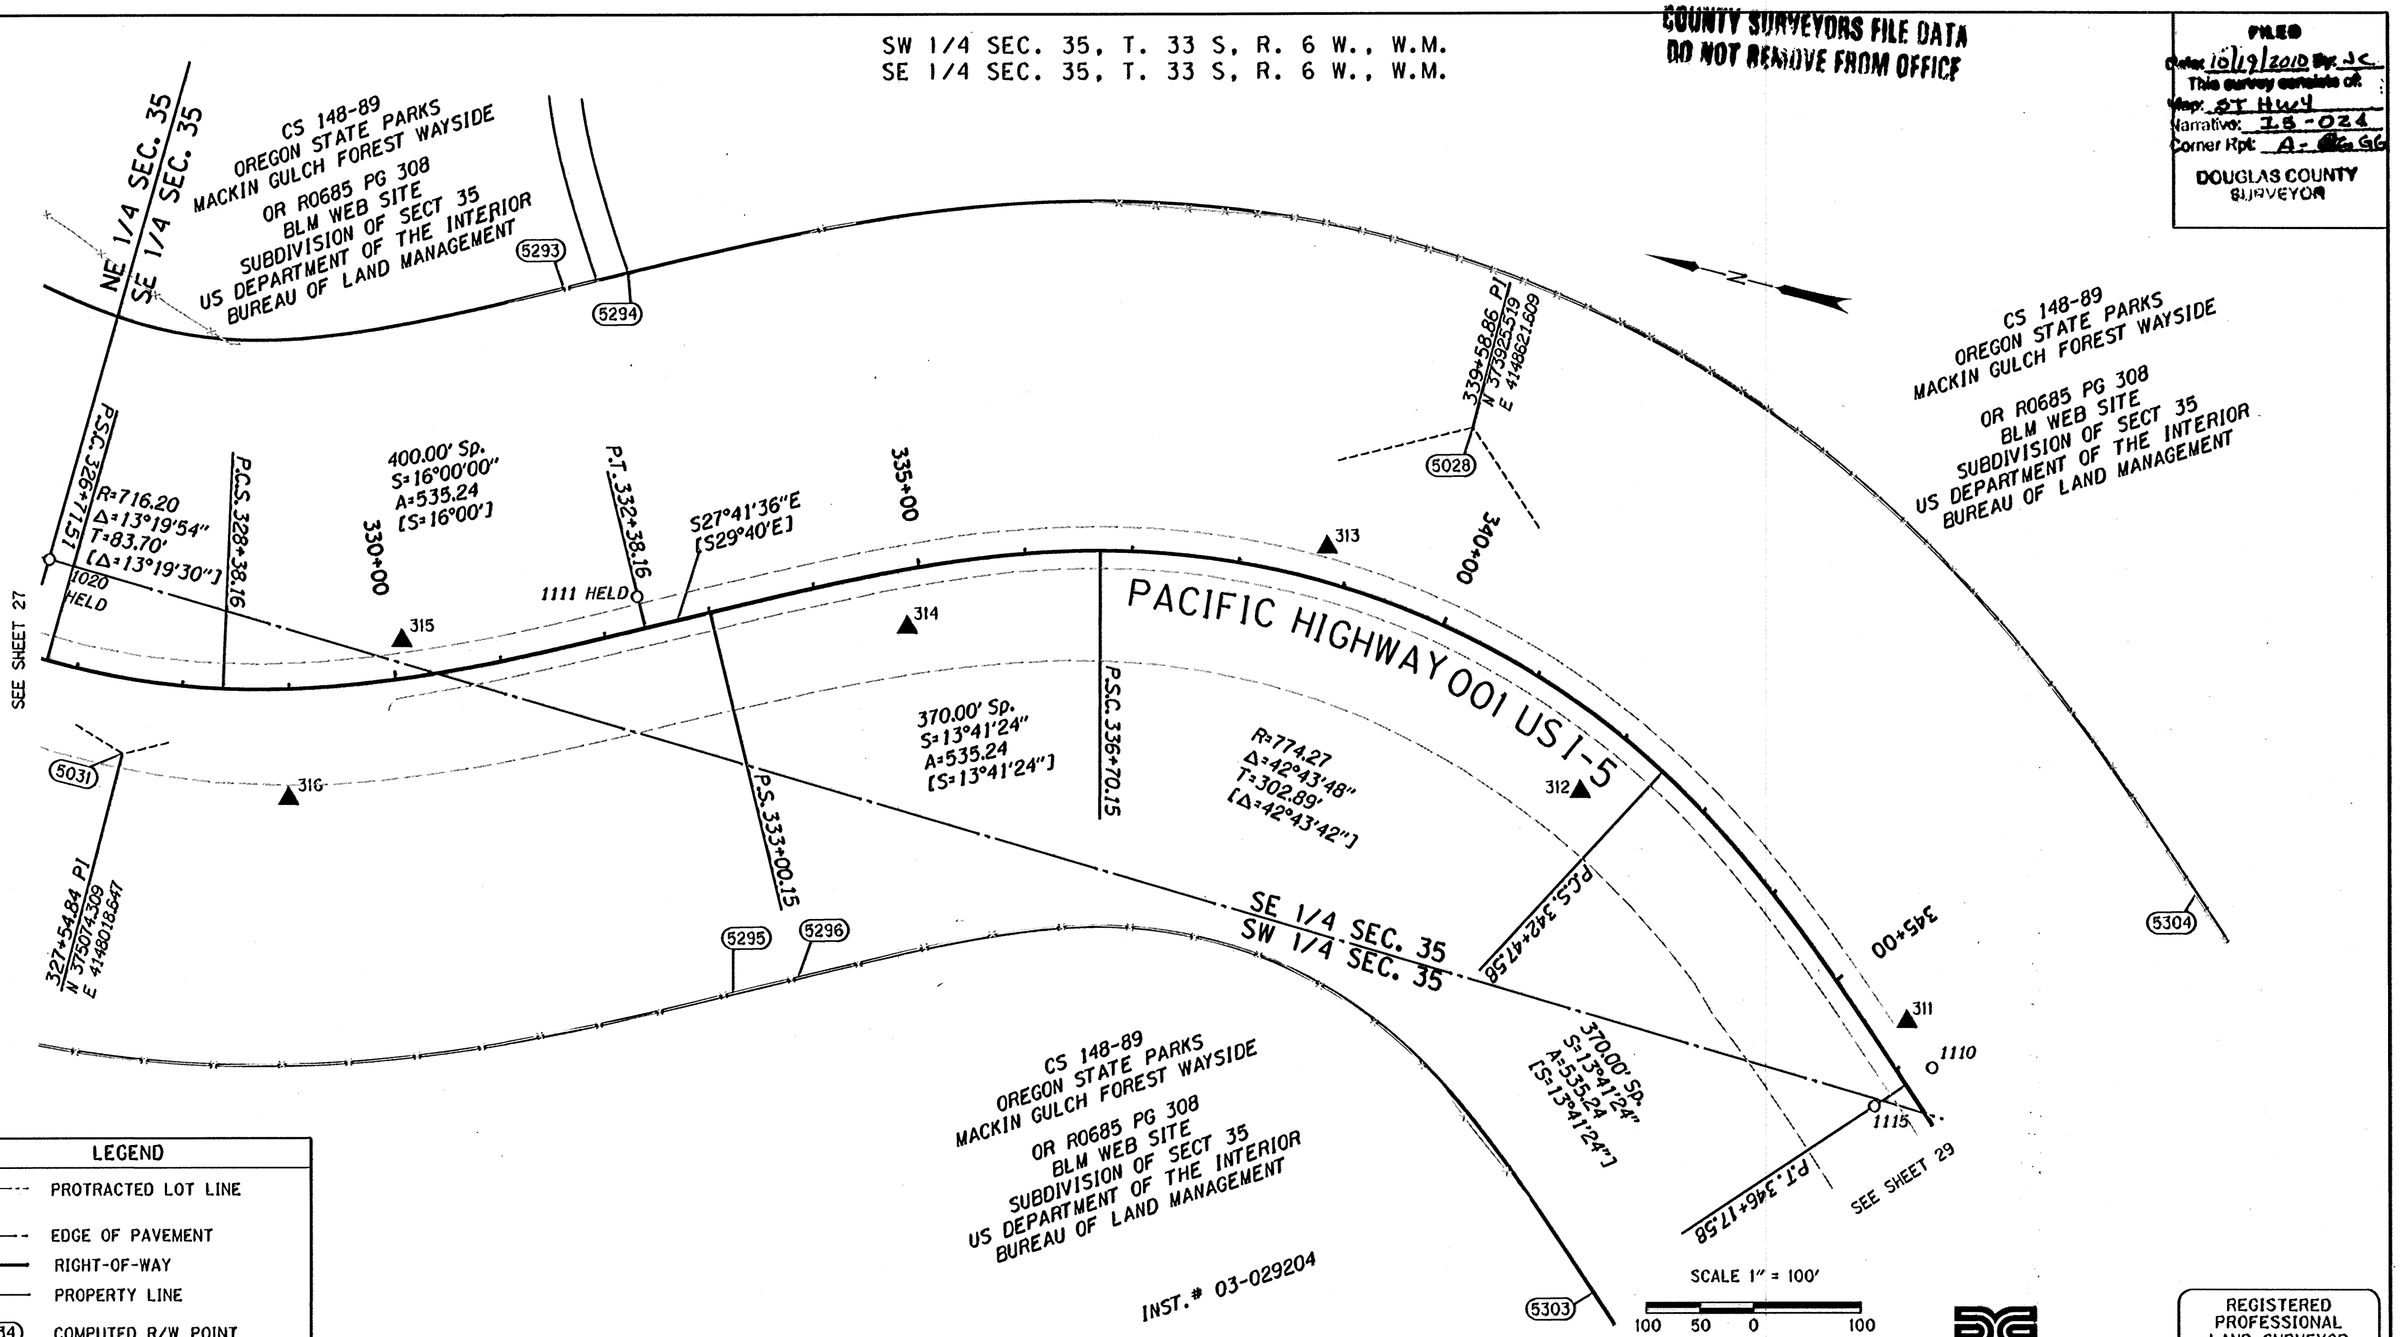

LEGEND	
------	PROTRACTED LOT LINE
— — —	EDGE OF PAVEMENT
———	RIGHT-OF-WAY
———	PROPERTY LINE
(1234)	COMPUTED R/W POINT
★	SET GPS POINT
▲	SET NETWORK POINT
○	FOUND MONUMENT
[ ]	RECORD DATA (BB-29-21)

W/=WITH, IP=IRON PIPE, IR=IRON ROD, YPC=YELLOW PLASTIC CAP, DRG=ODOT DRAWING B=BOOK P=PAGE
CSNI= COUNTY SURVEY NOT IDENTIFIED

RECOVERED MONUMENTS AND COMPUTED POINTS LIST

PT. NO.	LDP NORTHING	LDP EASTING	STATION	OFFSET	DATE	DESCRIPTION & REFERENCE DOCUMENTS
1020	375184.53	4148177.77	326+44.76	90.83 LT	12/09/2009	FOUND 2"BD, UP 0.2', "T33S R6W C1/4 S 35 2004", ON BLM WEB SITE OR-0685 P 0308.0 HELD
1110	373364.45	4148148.95	346+17.56	29.49 LT	02/04/2010	FOUND 2 3/4" BRASS CAP IN CONCRETE,"STATE HIGHWAY DEPARTMENT, REFERENCE", ODOT 88-29-21
1111	374643.99	4148278.46	332+37.55	30.06 LT	02/04/2010	FOUND 2 3/4" BRASS CAP IN CONCRETE,"STATE HIGHWAY DEPARTMENT, REFERENCE", ODOT 88-29-21 HELD
1115	373408.25	4148100.95	346+17.61	35.49 RT	02/05/2010	FOUND 2 3/4" BRASS CAP IN CONCRETE,"STATE HIGHWAY DEPARTMENT REFERENCE", DOWN 0.4', ODOT 88-29-21
5028	373925.52	4148621.61	339+58.86	180.55 LT		CALCULATED MONUMENT
5031	375074.31	4148018.65	327+54.84	69.97 RT		CALCULATED MONUMENT
5293	374780.53	4148539.89	332+38.16	325.00 LT		CALCULATED MONUMENT
5294	374725.64	4148568.70	333+00.15	325.00 LT		CALCULATED MONUMENT
5295	374466.83	4147942.21	332+38.16	350.00 RT		CALCULATED MONUMENT
5296	374411.94	4147971.02	333+00.15	350.00 RT		CALCULATED MONUMENT
5303	373620.40	4147868.77	346+17.58	350.00 RT		CALCULATED MONUMENT
5304	373165.11	4148367.11	346+17.58	325.00 LT		CALCULATED MONUMENT

THIS IS TO CERTIFY THAT THIS MAP WAS PREPARED USING HP DESIGNJET 1055CM, BLACK C4820a INK ON HP MATTE FILM #51642B.

ODOT

DAVID EVANS AND ASSOCIATES INC.
530 CENTER STREET NE, SUITE 605
SALEM OREGON 97301
PHONE: 503.361.8635

FILE NAME: 16763RET.DGN

REGISTERED PROFESSIONAL LAND SURVEYOR
Jon K. Broadwater
OREGON
JULY 11, 2006
JON KENNETH BROADWATER
61360LS
EXPIRES: 12/31/2011

OREGON DEPARTMENT OF TRANSPORTATION

HORIZONTAL CONTROL, RECOVERY, AND RETRACEMENT SURVEY
I-5: JUMPOFF JOE-GLENDALE PAVING AND CLIMBING LANES
GLENDALE TO SUNNY VALLEY
JOSEPHINE AND DOUGLAS COUNTIES

ODOT REGION 3 WHITE CITY
100 ANTELOPE ROAD
WHITE CITY, OREGON 97503

SEPTEMBER 28, 2010
SCALE: 1" = 100'
SHEET 28 OF 33

Josephine Co.

ST. HWY. I5 -024 BB