FILED
Date: 4-1-2015 By: X
This survey consist of:
Map: I5-028 A-11
Narrative:
Corner Rpt:
DOUGLAS COUNTY SURVEYOR

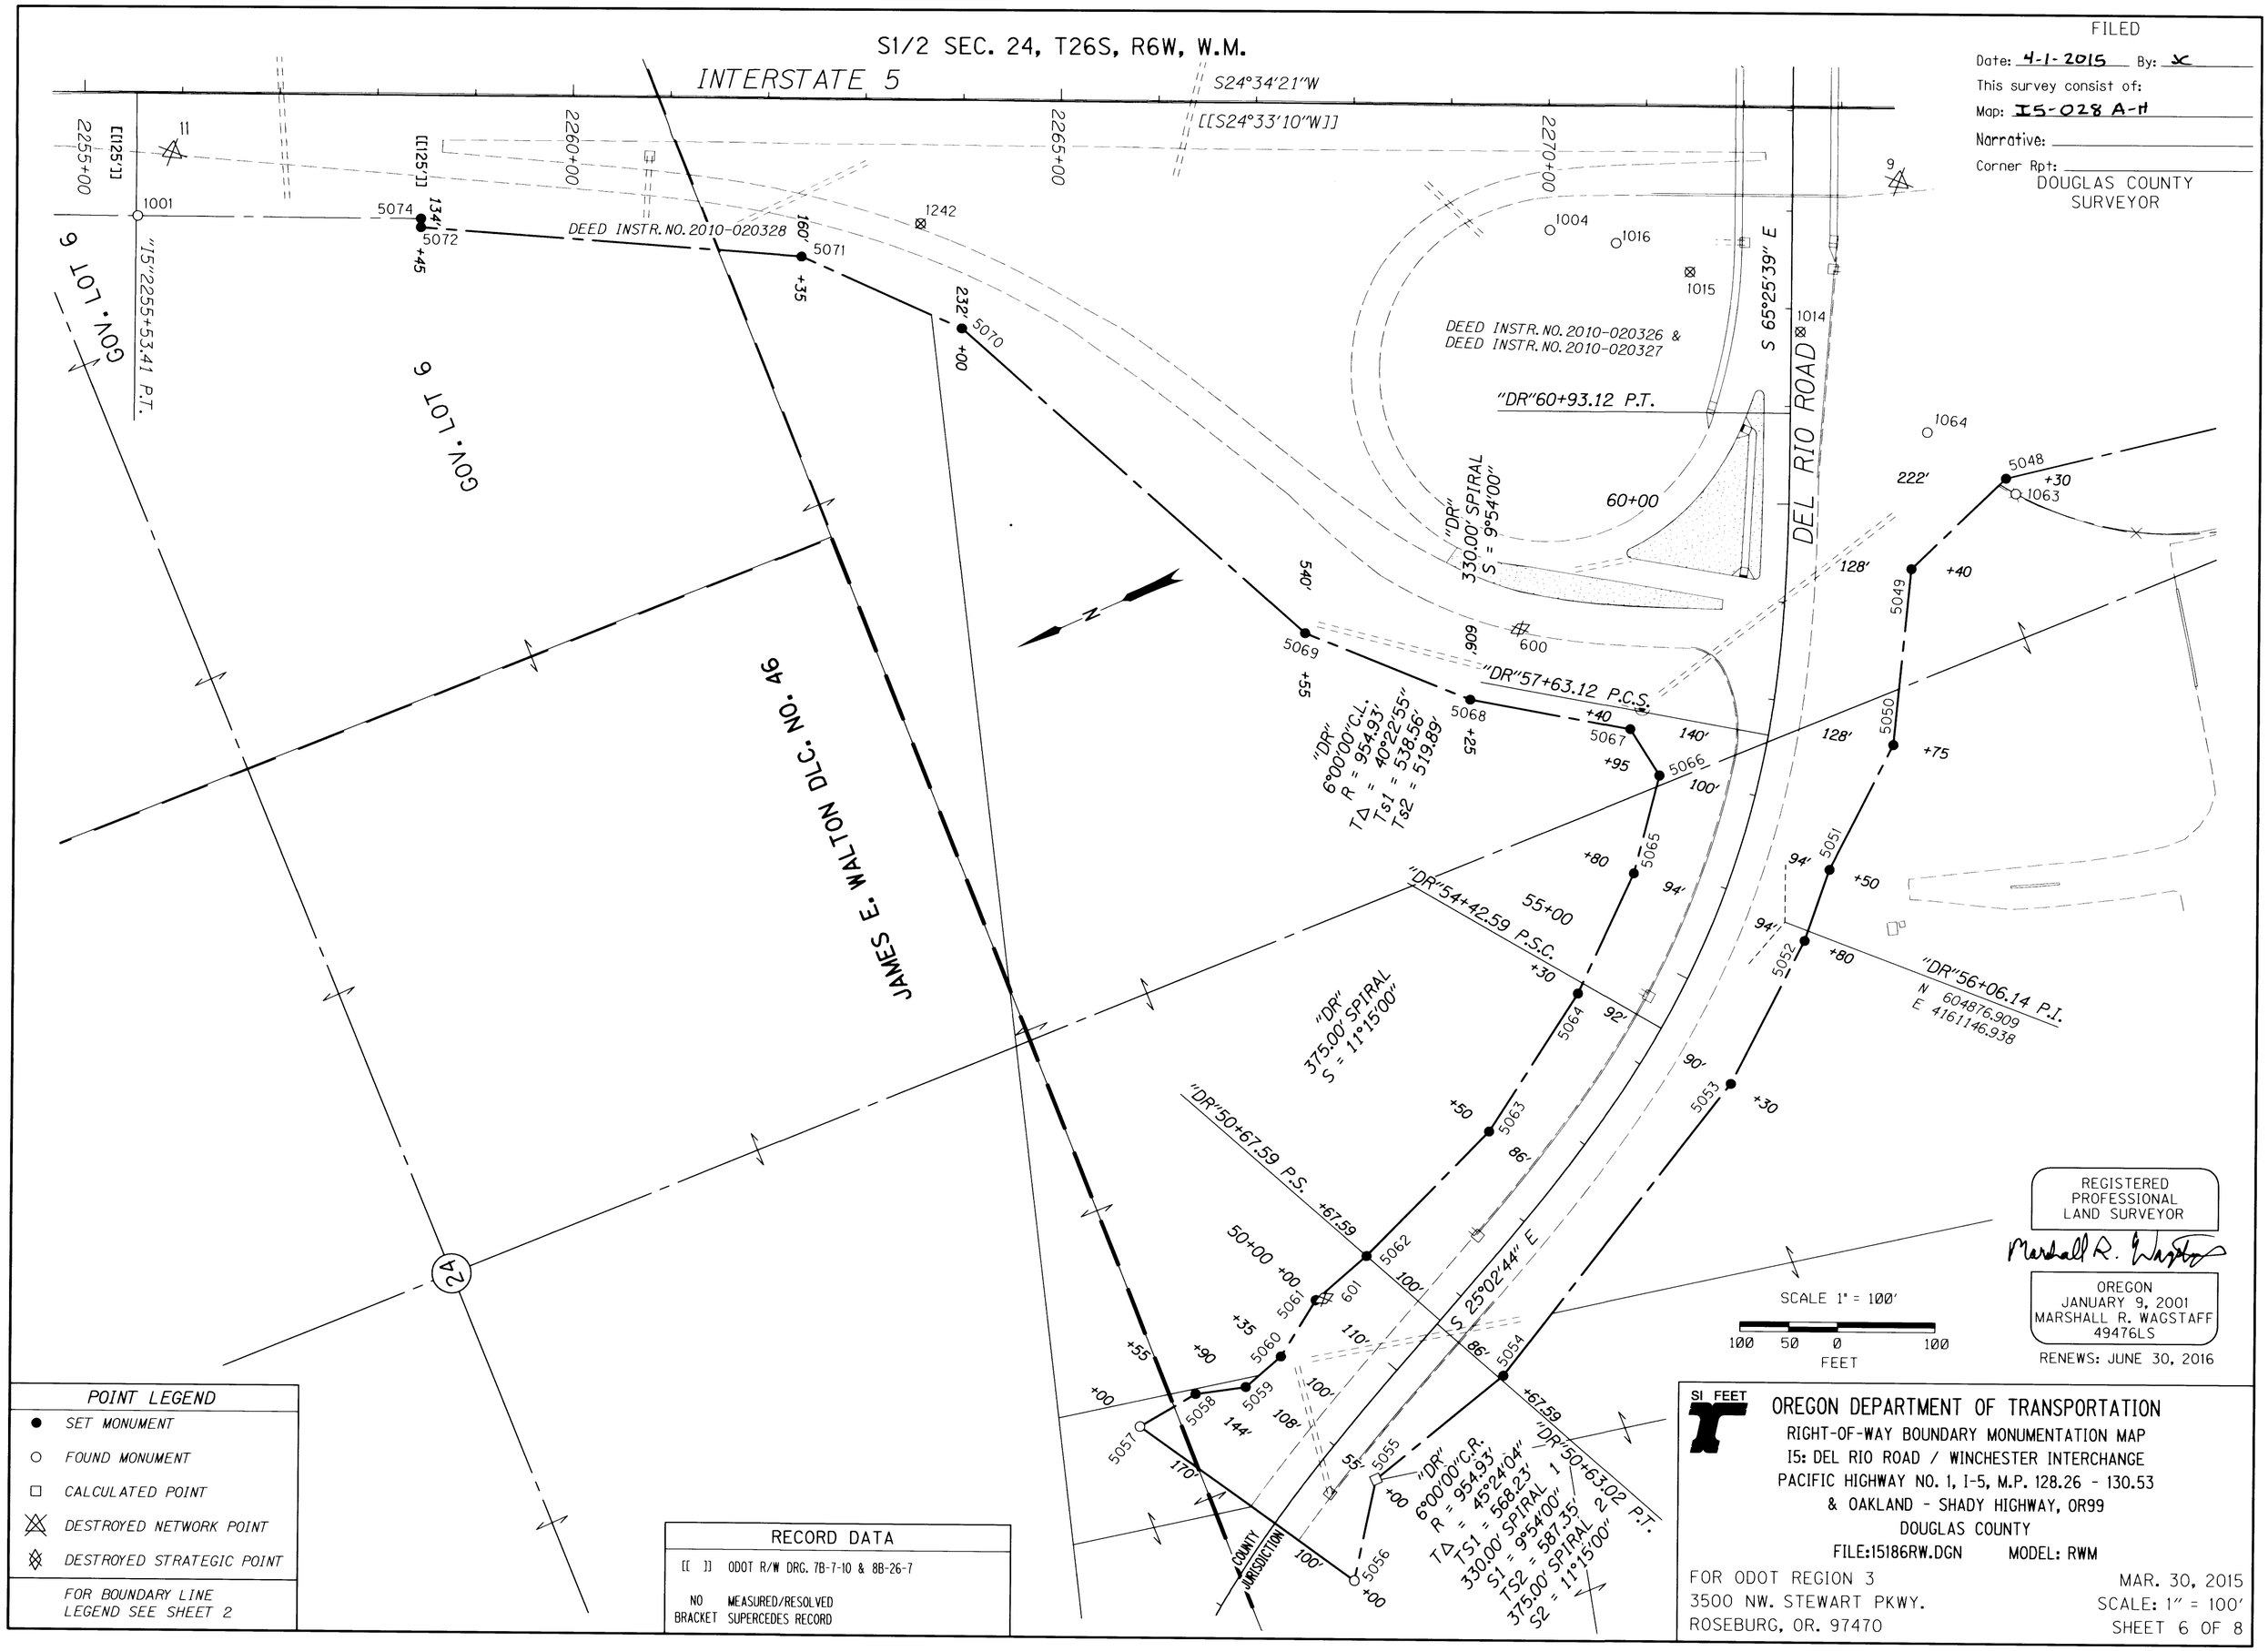


ST. HWY I5-028 F