W1/2 SEC. 25, T. 28 S., R. 6 W., W.M.
E1/2 SEC. 26, T. 28 S., R. 6 W., W.M.

FILED
Date: 7-3-2018 By: JC
This survey consist of:
Map: 5 sheet IS-030 A-M
Narrative:
Corner Rpt:
DOUGLAS COUNTY SURVEYOR

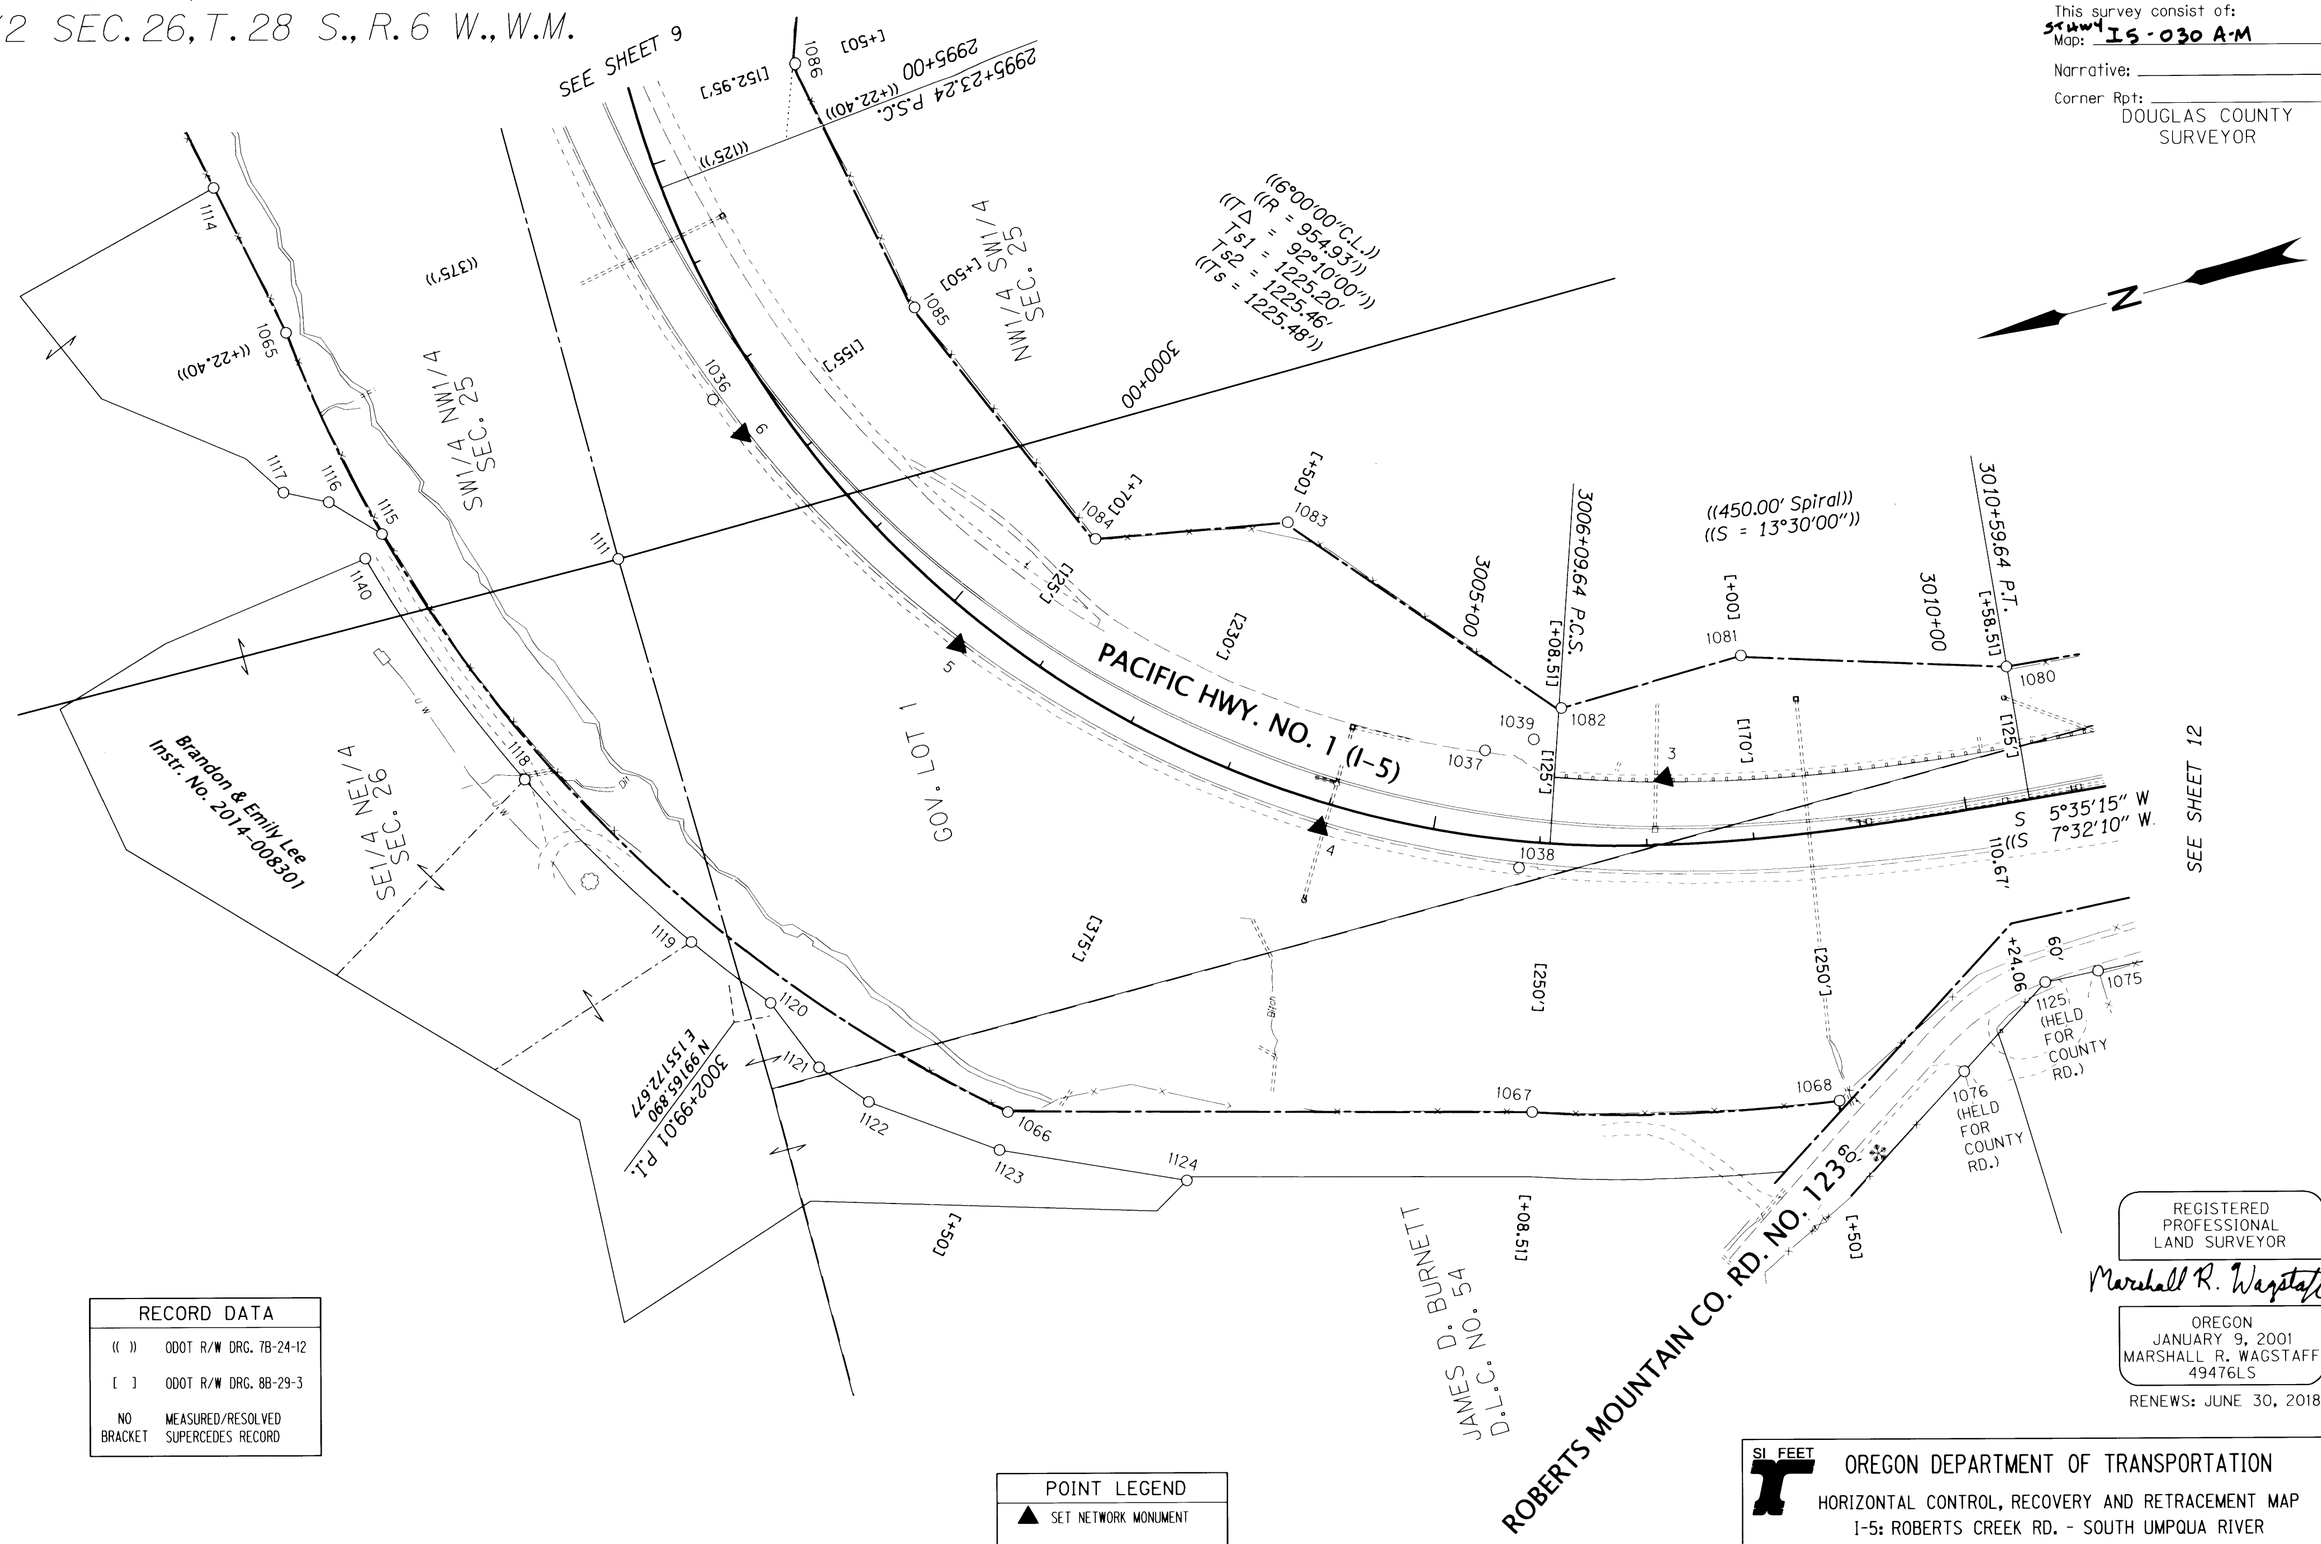

RECORD DATA	
(( ))	ODOT R/W DRG. 7B-24-12
[ ]	ODOT R/W DRG. 8B-29-3
NO BRACKET	MEASURED/RESOLVED SUPERCEDES RECORD

POINT LEGEND
▲ SET NETWORK MONUMENT
○ FOUND MONUMENT
SEE SHEET 10 FOR MONUMENT TABLE SEE SHEET 2 FOR LINE LEGEND

100 50 0 100
FEET

REGISTERED PROFESSIONAL LAND SURVEYOR
Marshall R. Wagstaff
OREGON
JANUARY 9, 2001
MARSHALL R. WAGSTAFF
49476LS
RENEWS: JUNE 30, 2018

SI FEET

OREGON DEPARTMENT OF TRANSPORTATION

HORIZONTAL CONTROL, RECOVERY AND RETRACEMENT MAP
I-5: ROBERTS CREEK RD. - SOUTH UMPQUA RIVER
PACIFIC HWY. NO. 1 (I-5) M.P. 114.8 TO 120.3
DOUGLAS COUNTY
CAD FILE: S_K18967_CRR_01.DGN

FOR ODOT REGION 3
3500 NW. STEWART PKWY.
ROSEBURG, OR. 97470

JUNE 26, 2018
SCALE: 1" = 100'
SHEET 11 OF 13

ST HWY I5-030 K