E1/2 SEC. 11 & W1/2 SEC. 12, T. 28 S., R. 6 W., W.M.

FILED
Date: 1-28-19 By: DJ
This survey consist of:
Map: ST. HWY I5-031 A-K
Narrative:
Corner Rpt:
DOUGLAS COUNTY SURVEYOR

POINT LEGEND

- ☆ FOUND GPS STATION
- ○ FOUND MONUMENT
- ▲ SET NETWORK POINT

SEE SHEET 2 FOR LINE LEGEND

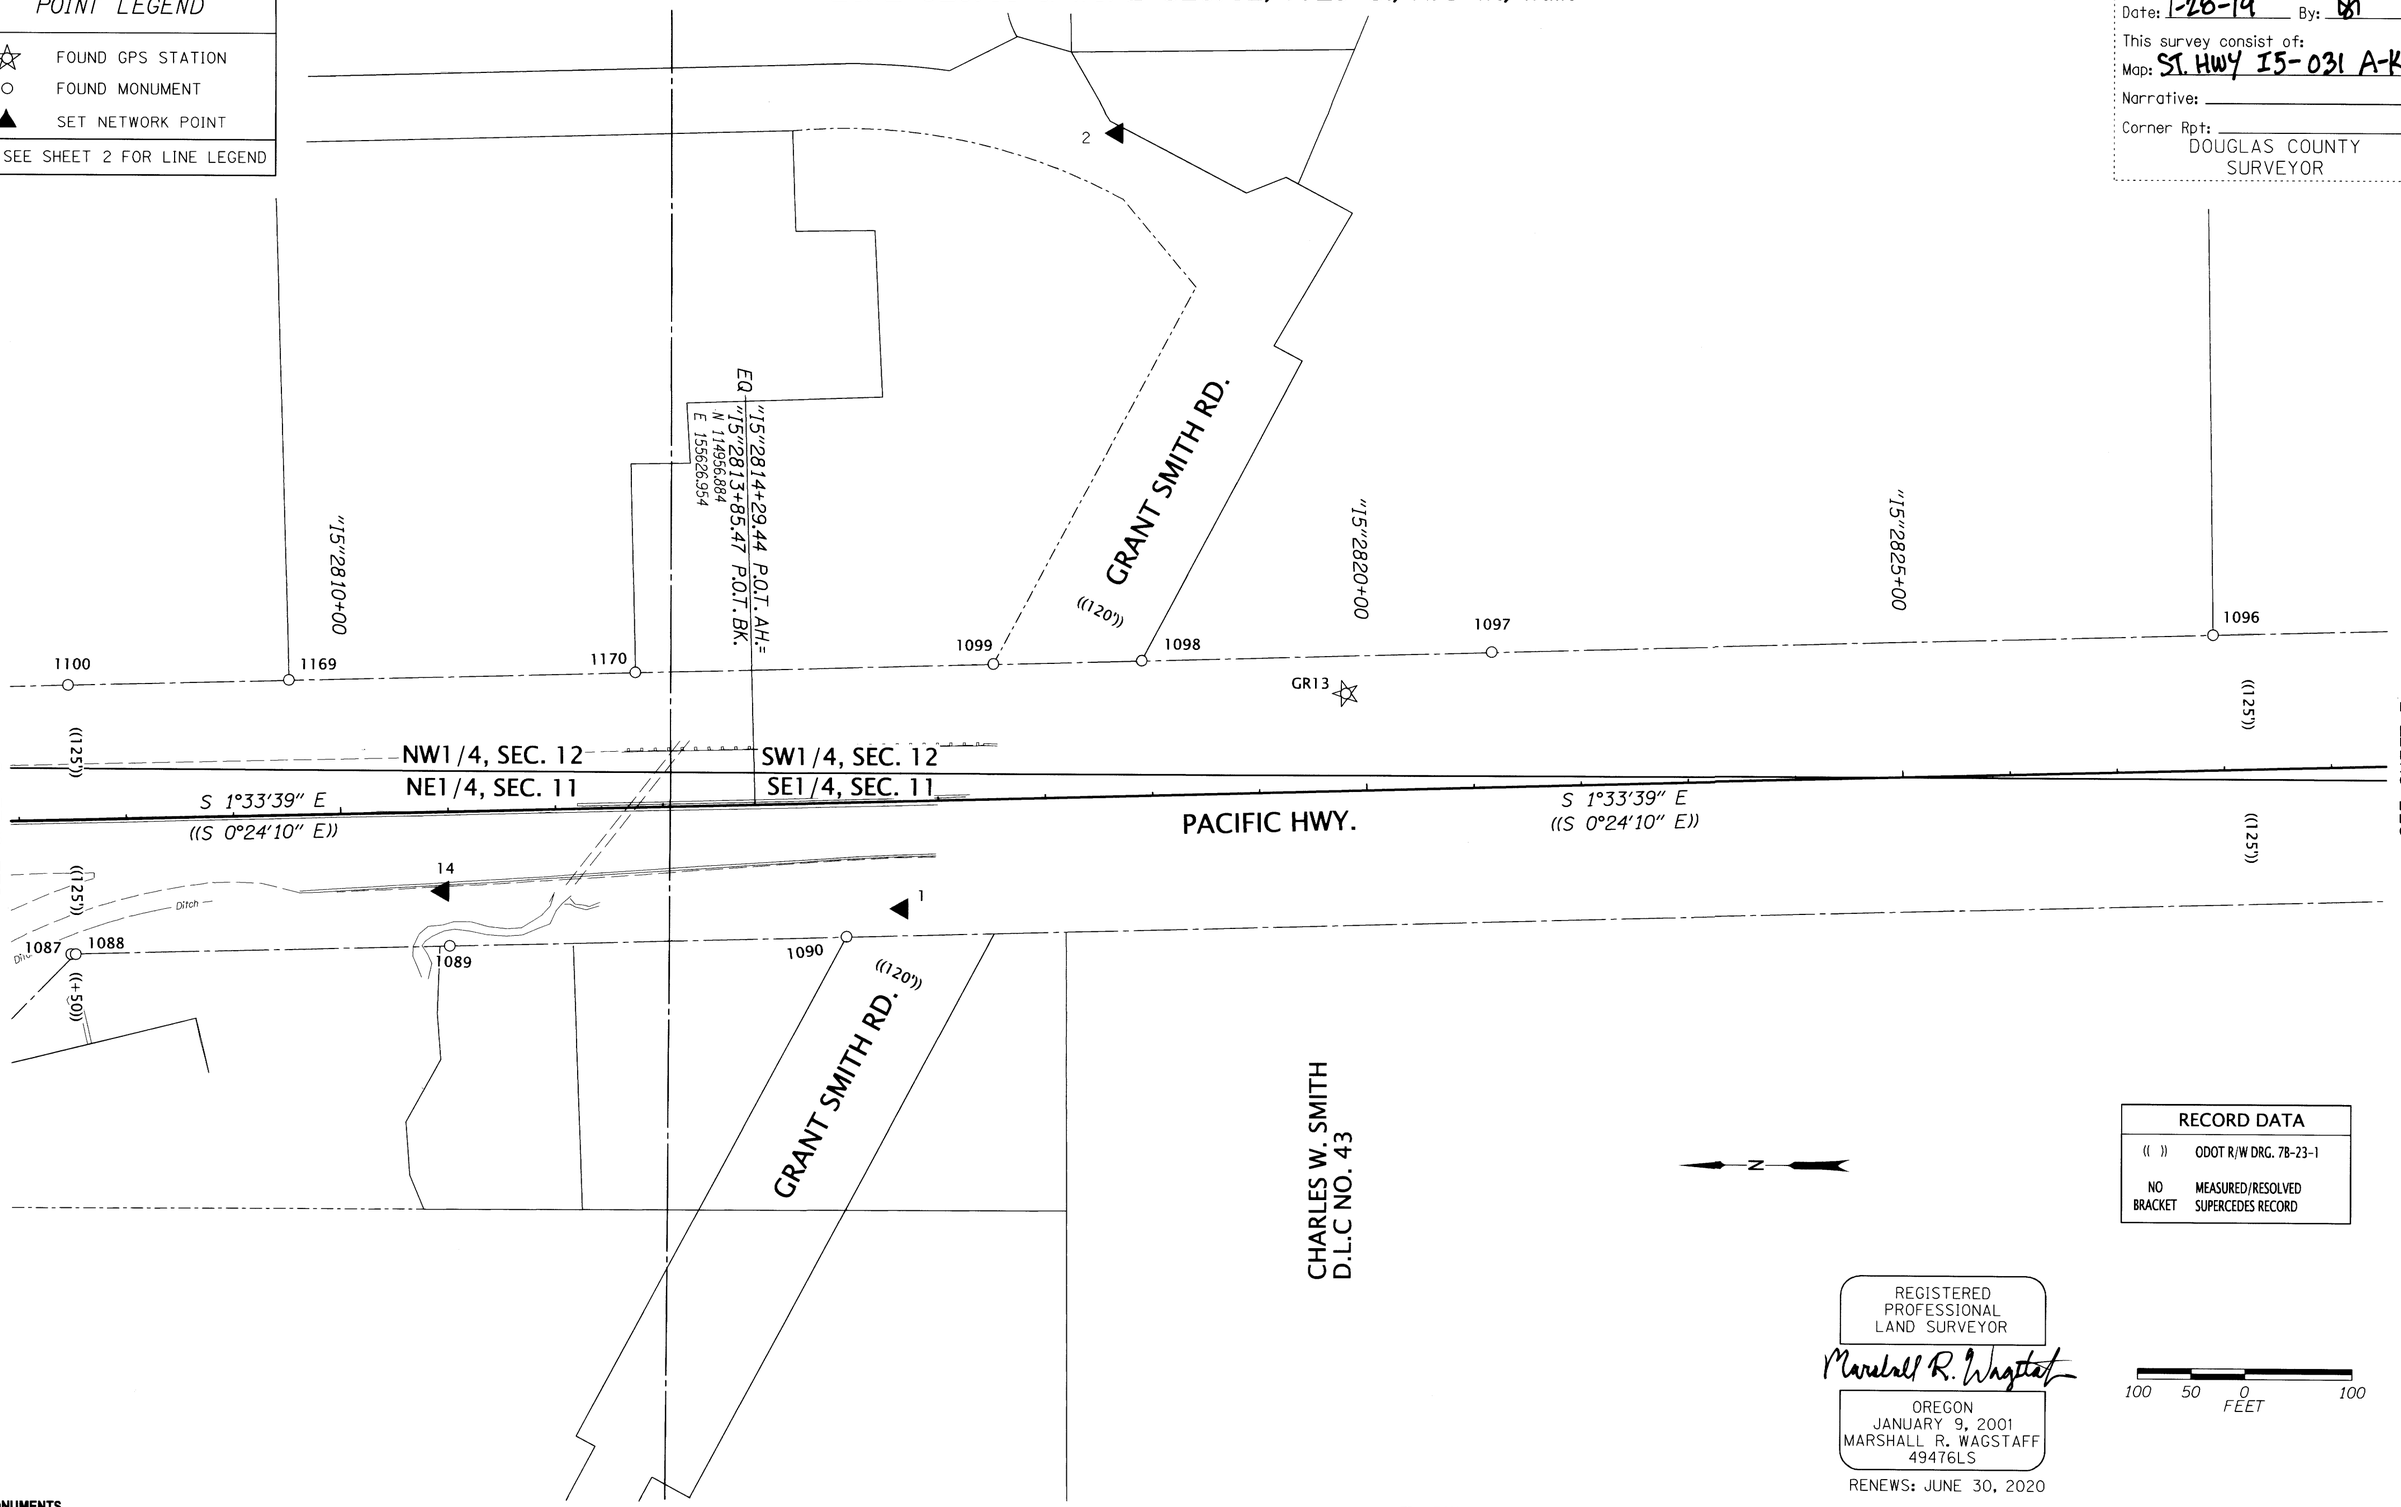

RECORD DATA

(( ))	ODOT R/W DRG. 7B-23-1
NO BRACKET	MEASURED/RESOLVED SUPERCEDES RECORD

REGISTERED PROFESSIONAL LAND SURVEYOR
Marshall R. Wagstaff
OREGON
JANUARY 9, 2001
MARSHALL R. WAGSTAFF
49476LS
RENEWS: JUNE 30, 2020

100 50 0 100
FEET

MONUMENTS

FD. = FOUND YPC = YELLOW PLASTIC CAP

PT. NO.	OCRS NORTHING	OCRS EASTING	ELEVATION	STATION	OFFSET (- IS LEFT)	DATE	DESCRIPTION	REFERENCE
1	114819.575	155530.869	579.24	"I5"2815+64.08	99.79	8/23/2012	SET 5/8' x 30" IRON REBAR WITH 1 1/2' BRASS CAP STAMPED "ODOT CONTROL 1" N.W. CORNER OF GRANT SMITH OXING	-
2	114621.816	156252.211	568.07	"I5"2817+81.41	-615.90	8/23/2012	SET 1" COPPER DISK IN CONCRETE CURB STAMPED "ODOT CONTROL 2"	-
14	115246.757	155545.293	551.16	"I5"2810+93.48	73.74	8/23/2012	SET 5/8' x 30" IRON REBAR WITH 1 1/2' BRASS CAP STAMPED "ODOT CONTROL 14"	-
1088	115588.730	155484.389	-	"I5"2807+49.98	125.30	7/30/2012	FD. 5/8" SMOOTH IRON ROD EXTENDS 0.3 FT. ABOVE CONCRETE FOR FENCE POST. ROD SITS IN GROUND AT 45^ AND TOP 20" OF ROD IS EXPOSED SLANTS NORTH TIED WHERE ROD ENTERS GROUND. POOR CONDITION PROBABLE STATE ROD STA 2807+50 125 RT.	7B-23-1
1089	115240.057	155494.306	-	"I5"2810+98.79	124.89	9/17/2012	FD. 5/8" IRON REBAR WITH A 1 1/4" YPC STAMPED "BENTZ SUR INC." 1.1 FT. ABOVE GROUND GOOD CONDITION	M107-33
1090	114871.077	155504.518	-	"I5"2815+11.88	124.73	9/17/2012	FD. 5/8" SMOOTH IRON ROD IN CONCRETE AT FENCE CORNER 0.2 FT. ABOVE GROUND. GOOD CONDITION 4"x4" WOOD WITNESS POST NEARBY MARKED "SHRW" 125 RT.	7B-23-1
1096	113598.192	155789.236	-	"I5"2827+92.05	-125.22	7/30/2012	FD. 5/8" IRON REBAR WITH 1 1/4" YPC STAMPED "R. BROWN PLS 2891" 0..2 FT. ABOVE GROUND GOOD CONDITION	M137-12
1097	114270.702	155771.084	-	"I5"2821+19.29	-125.39	7/30/2012	FD. 5/8" SMOOTH IRON ROD 0.1 FT BELOW GROUND, GOOD CONDITION. 4"X4" WOOD WITNESS POST NEARBY. STATION 2822+00 125 LT.	7B-23-1
1098	114597.188	155762.061	-	"I5"2817+92.68	-125.26	9/17/2012	FD. 5/8" IRON REBAR WITH 1 1/4" YPC STAMPED "R. BROWN PLS 2891" 0.7 FT. ABOVE GROUND GOOD CONDITION	M137-12
1099	114735.394	155758.440	-	"I5"2816+54.43	-125.40	9/17/2012	FD. 5/8' IRON ROD AT RW FENCE FLUSH WITH GROUND GOOD CONDITION 4"x4" WOOD WITNESS POST NEARBY. 125 LT	7B-23-1
1169	115391.000	155740.504	-	"I5"2809+54.61	-125.33	1/6/2017	FD. IRON ROD WITH 1 1/4" YPC STAMPED "I.E. ENGINEERING" FLUSH WITH GROUND, GOOD CONDITION	M171-15
1170	115068.393	155749.306	-	"I5"2812+77.33	-125.34	1/6/2017	FD. IRON ROD WITH 1 1/4" YPC STAMPED "I.E. ENGINEERING" 0.2 FT BELOW GROUND, GOOD CONDITION	M171-15
GR13	114406.407	155732.189	570.89	"I5"2819+82.58	-90.20	8/23/2012	FD. 5/8" IRON REBAR WITH 1 1/2" BRASS CAP STAMPED "ODOT CONTROL 13", 0.2 FT. BELOW GROUND GOOD CONDITION.	ST. HWY. I5-006

OREGON DEPARTMENT OF TRANSPORTATION

HORIZONTAL CONTROL, RECOVERY, RETRACEMENT & BOUNDARY MONUMENTATION MAP
I-5: EXIT 119 & 120 INTERCHANGE IMPROVEMENTS
PACIFIC HWY./COOS BAY - ROSEBURG HWY./OLD HWY. 99
DOUGLAS COUNTY
FILE: 17918RW.DGN :: CRR

ODOT REGION 3 TECH CENTER
3500 NW. STEWART PKWY.
ROSEBURG, OR. 97470

JANUARY 10, 2019
SCALE: 1" = 100'
SHEET 6 OF 11

ST. HWY. I5-031 F