DRG. NO. 1S-10

FILED
JUN 9 1986
COUNTY SURVEYOR
DOUGLAS COUNTY, ORE.

OREGON STATE HIGHWAY DIVISION
ELKHEAD ROAD - RICE HILL INTERCHANGE SECTION
PACIFIC HIGHWAY, DOUGLAS COUNTY

FILE NO 54909 G.C. LONG & MYRTLE E. LONG

April 1986
Survey to Monument Right of Way
S.W. 1/4 Section 15, N.W. 1/4 Section 22
Township 23 South, Range 5 West W.M.
D.L.C. No. 46, Douglas County, Oregon

Surveyed by:
Oregon State Highway Division
P.O. Box 1128
Roseburg, Oregon 97470

REGISTERED PROFESSIONAL LAND SURVEYOR
David R. Scofield
DAVID R. SCOFIELD

Narrative Separate Document

Legend:
- • Set 5/8"x 30" Iron Rod
With 1-1/2" Aluminum Cap Marked:
OREG. STATE HWY. DIV.
- ◎ Monuments Found
- ◦ Highway Center Line (not monumented)

SCALE 1" = 50'

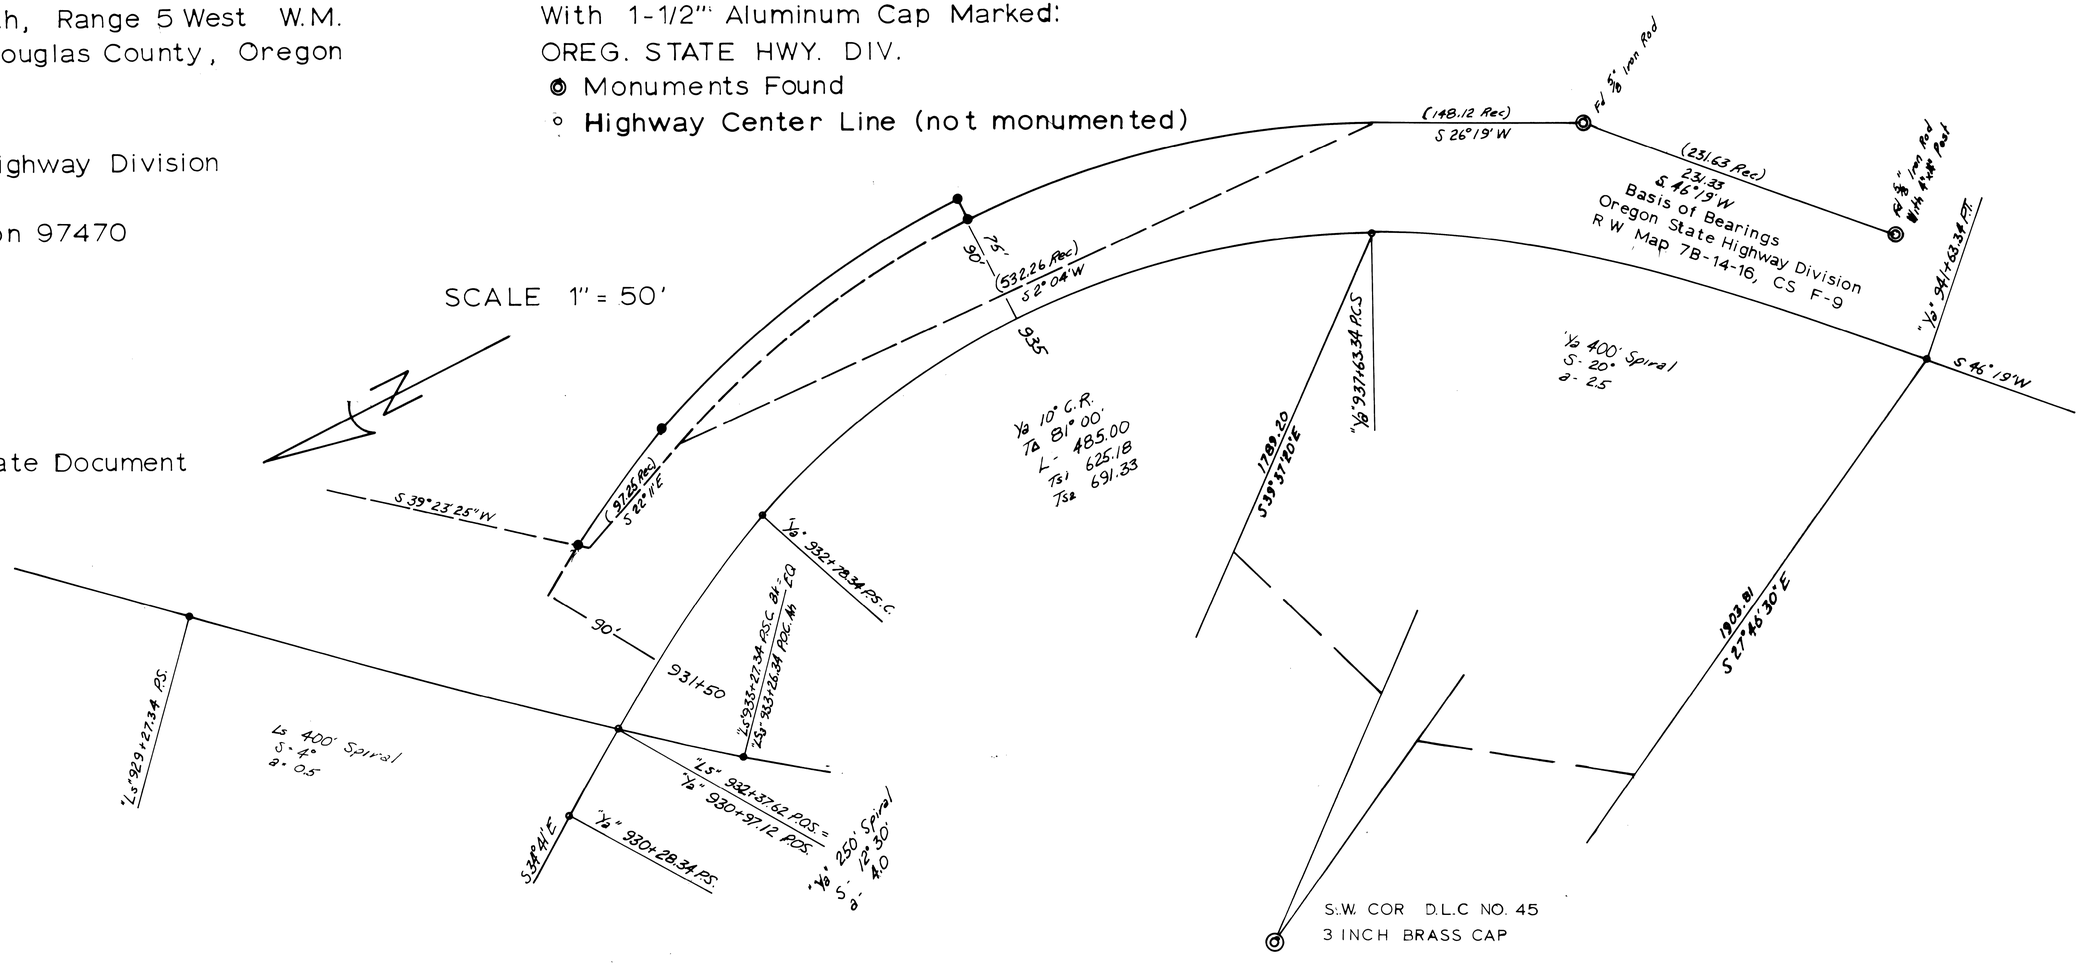

CS 63/38(N)