OREGON STATE HIGHWAY DIVISION
RIGHT OF WAY DIVISION

CAMAS MT. WAYSIDE - MUNS CREEK (SUICIDE CREEK) SEC.

COOS BAY - ROSEBURG HIGHWAY

DOUGLAS COUNTY

Scale: Inch = 100 Feet

APRIL, 1987

Rev. JUL,1987
Aug.,1987
Sept.,1987
Oct.,1987
Nov.,1987
May,1988
Jan.,1989
Mar.,1989
Nov.,1989

GRID BEARINGS:SOUTH ZONE



DRG. NO.:A-15-46

ACCESS CONTROL LINE

2F14.37SLIV.DM.PROTRON.DGN/ 20-Apr-1992

Corner Line Station Only
No Monument Found or Not Cross Noted

Found Monument / As Noted


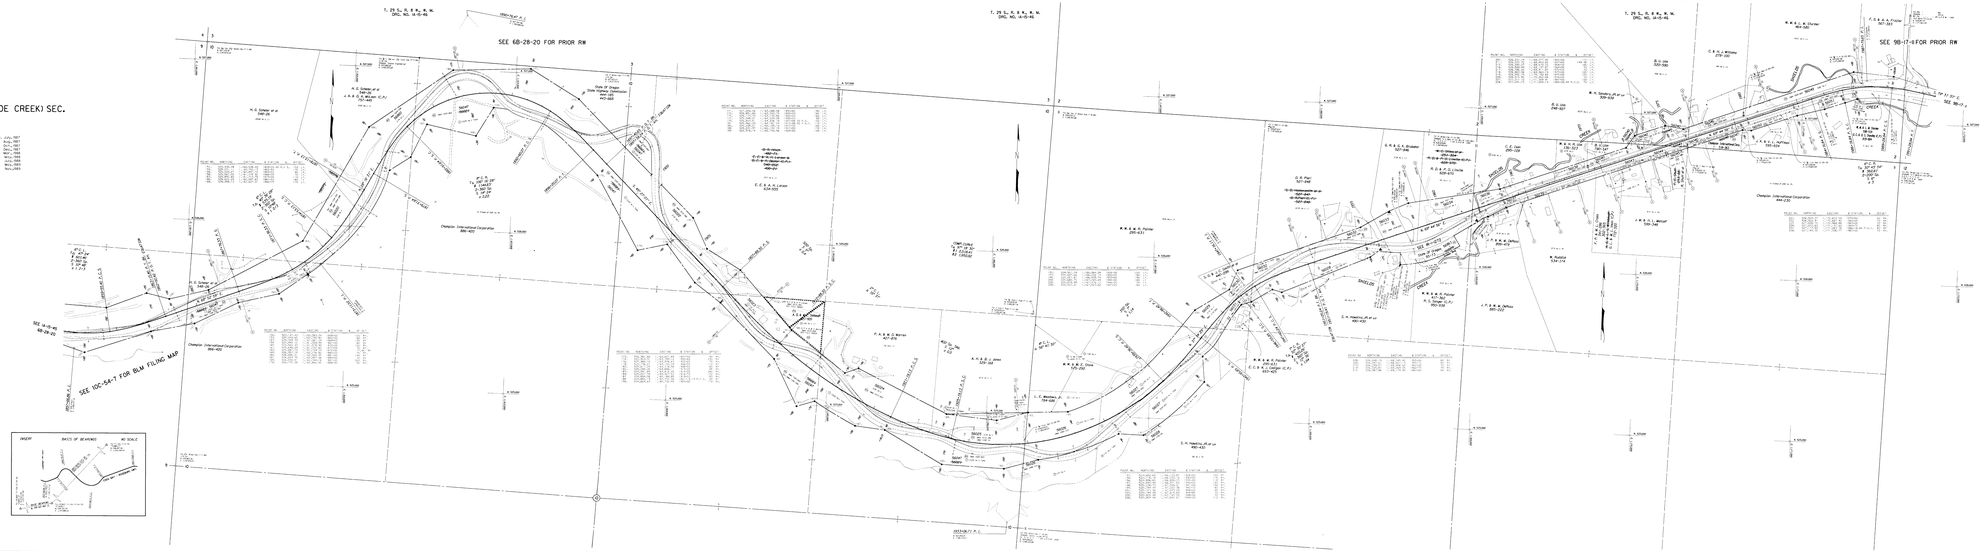

MARKPOINT

Camas Valley - Camas Mountain Wayside
Coos Bay - Roseburg Highway
Coos Bay - Roseburg Highway
Douglas County

Drawing No.50-20-15,14-20-45,14-25-46

Location of Survey:
T.29 S.,R.8 W.
T.29 S.,R.9 W.
T.29 S.,R.10 W.

SECTION 31,T.29S.,R9W.W.M.


Date of Survey:December-1989

Purpose of Survey:To locate the centerline of Coos Bay - Roseburg Highway from Camas Valley station 1236+00 to Muns Creek station 1350+00 and to determine the limits of right-of-way which was purchased from each side of the highway.


Surveyed by:Oregon Department of Transportation
Highway Division
2340 NE Stephens
Roseburg OR - 97470

CAMAS MT. WAYSIDE - MUNS CREEK (SUICIDE CREEK) SEC.

COOS BAY - ROSEBURG HWY.

DOUGLAS COUNTY

LOCATED LINE

SCALE:1" = 100'

DRG. NO.:A-15-46