Sec. 17, T. 22 S., R. 5 W., W.M.

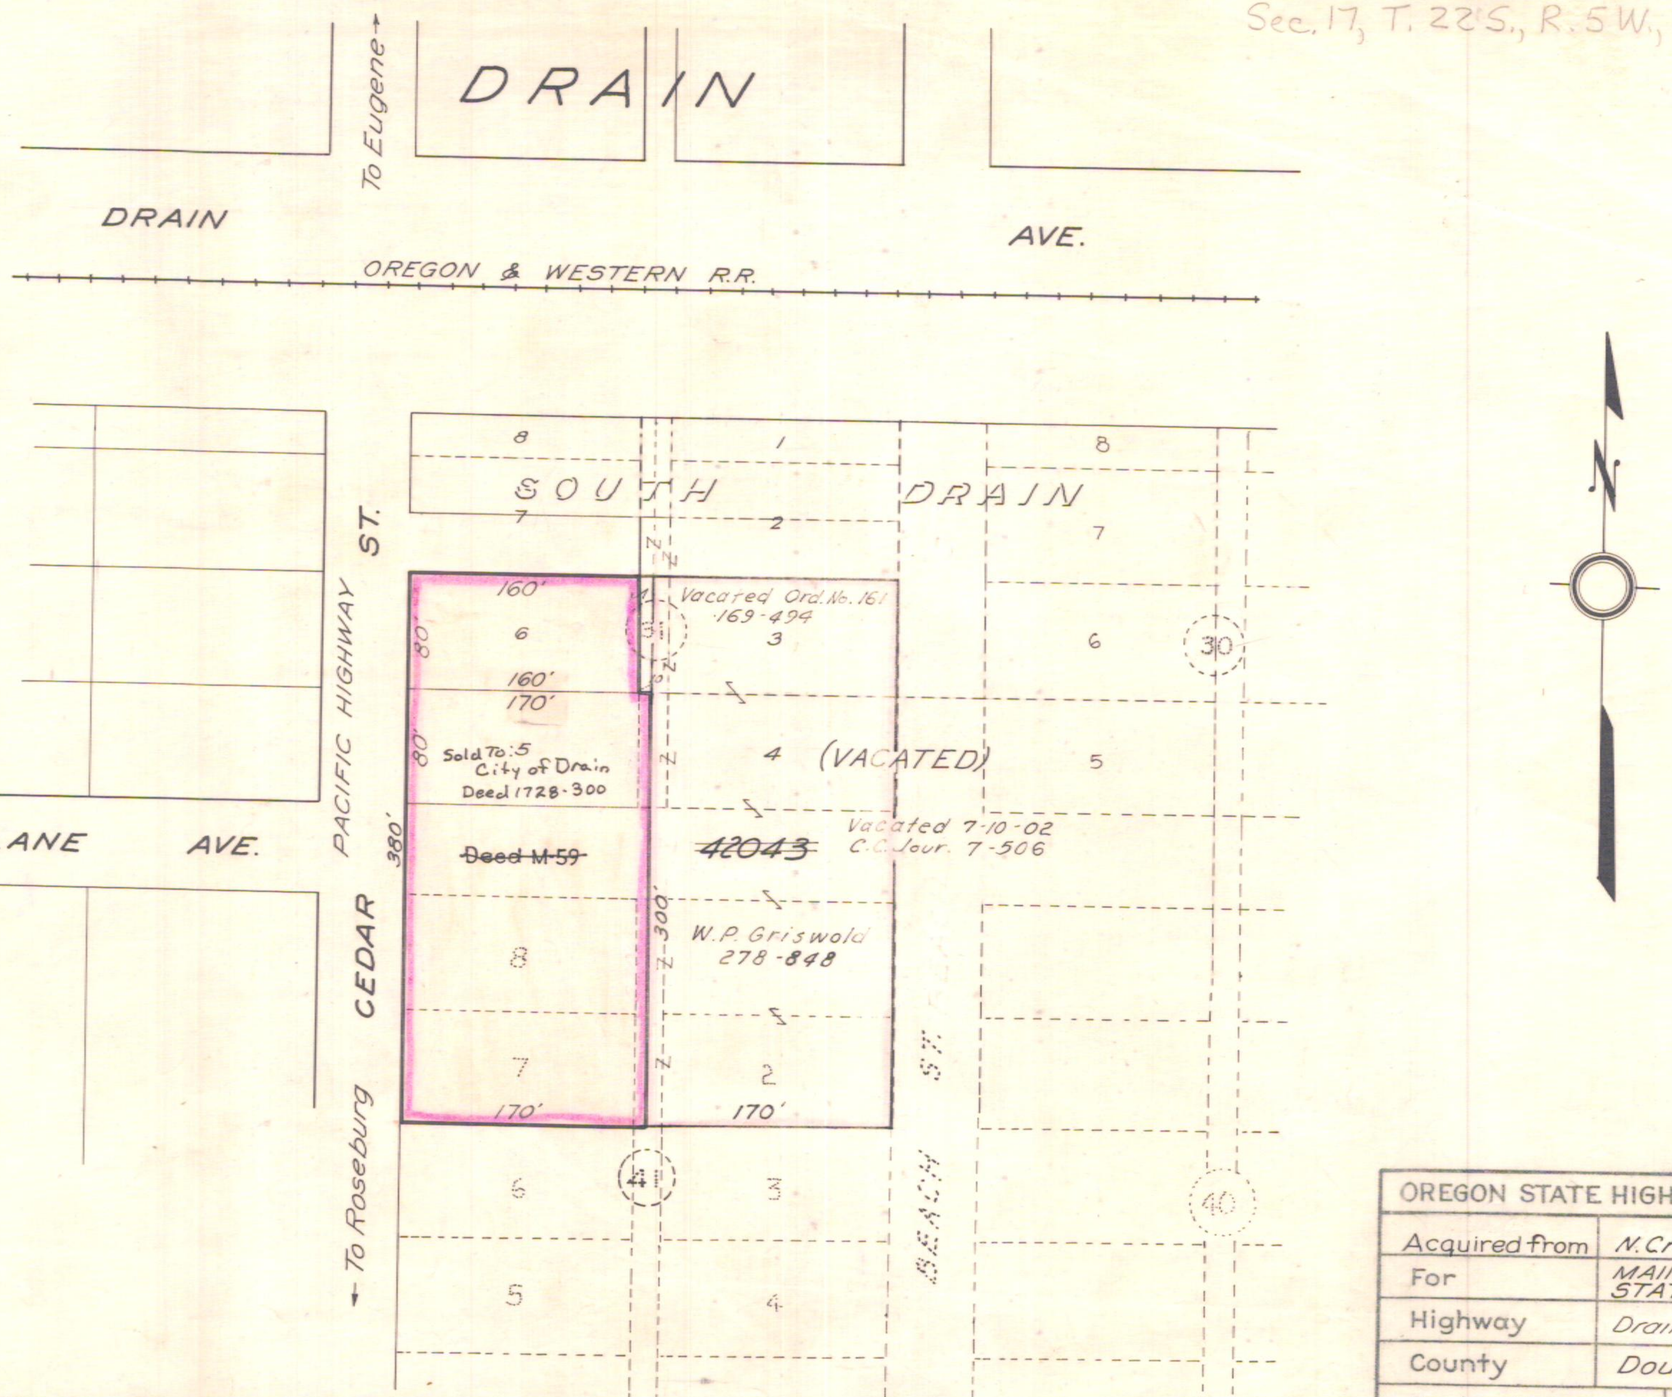

OREGON STATE HIGHWAY DEPARTMENT	
Acquired from	N. Crow & W. Griswold
For	MAINTENANCE PATROL STATION SITE
Highway	Drain - Yoncalla
County	Douglas
Scale: 1" = 100'	Date: July, 1931

3B-11-11

Rev.: Aug., 1967
Rev.: Dec., 2001