


T.21S. R.12W. W.M.

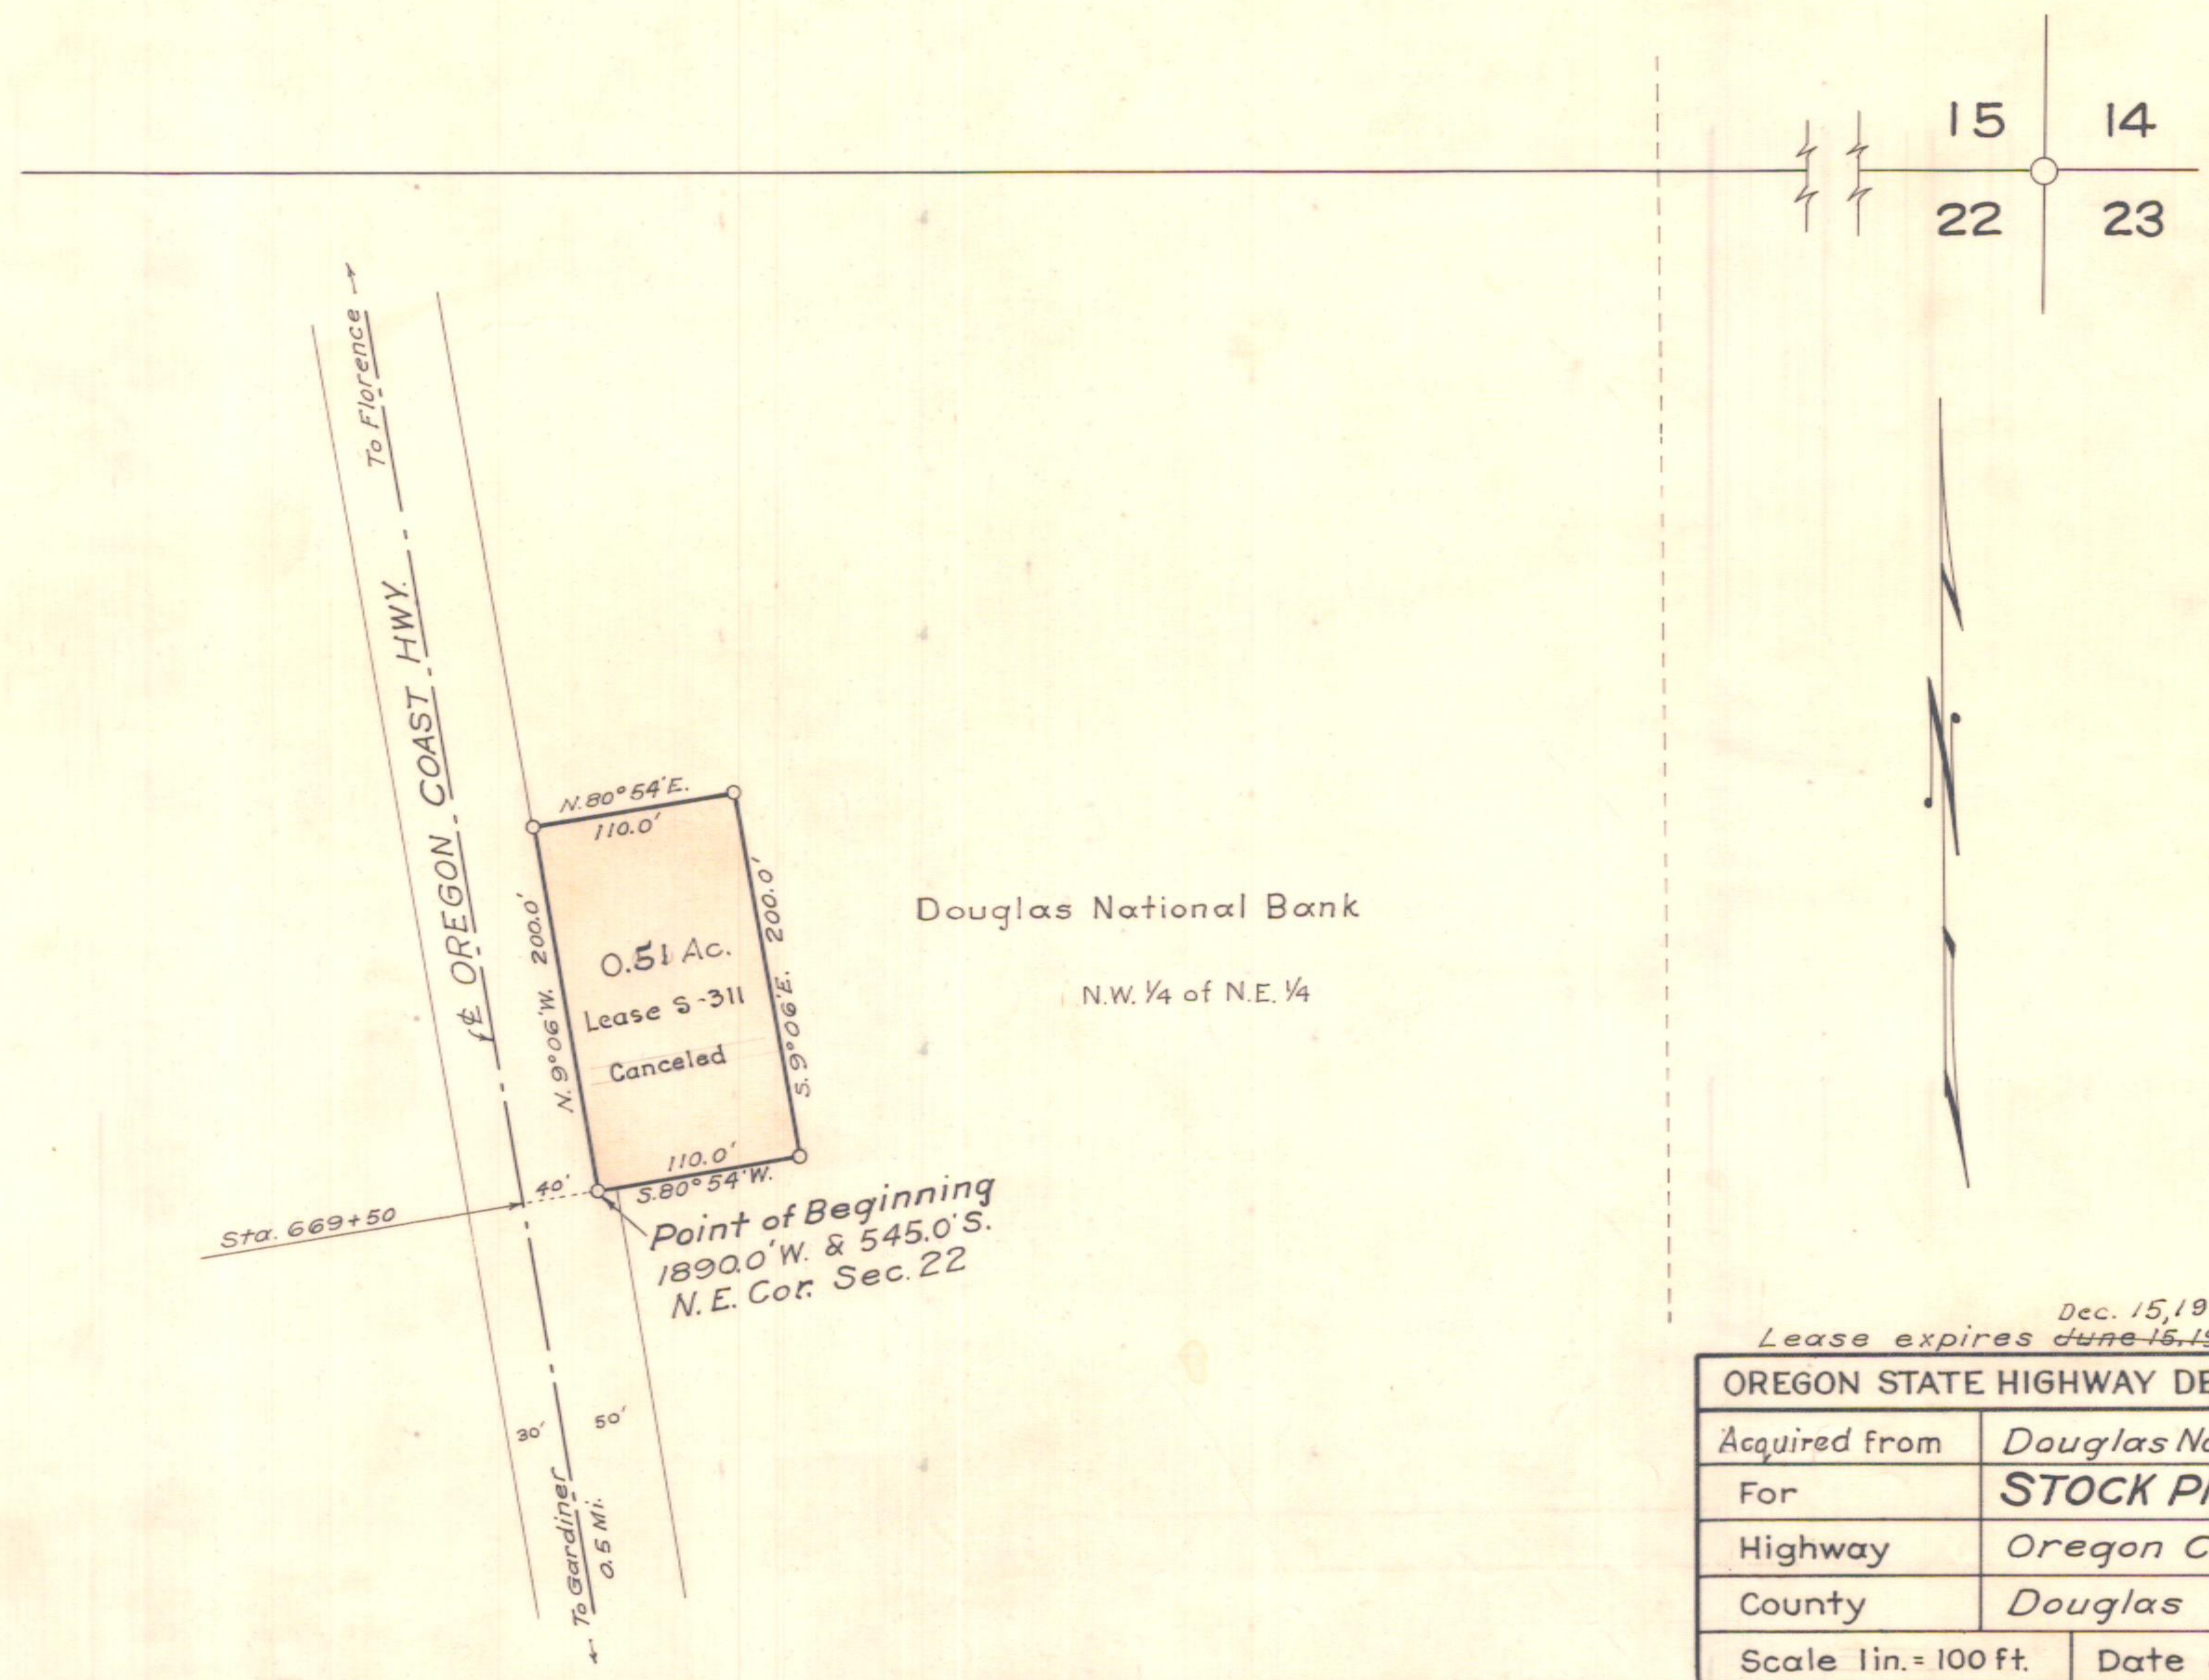

Dec. 15, 1938
Lease expires June 15, 1937.

OREGON STATE HIGHWAY DEPARTMENT	
Acquired from	Douglas National Bank
For	STOCK PILE SITE
Highway	Oregon Coast
County	Douglas
Scale 1 in. = 100 ft.	Date June 1932