1R-1-1706

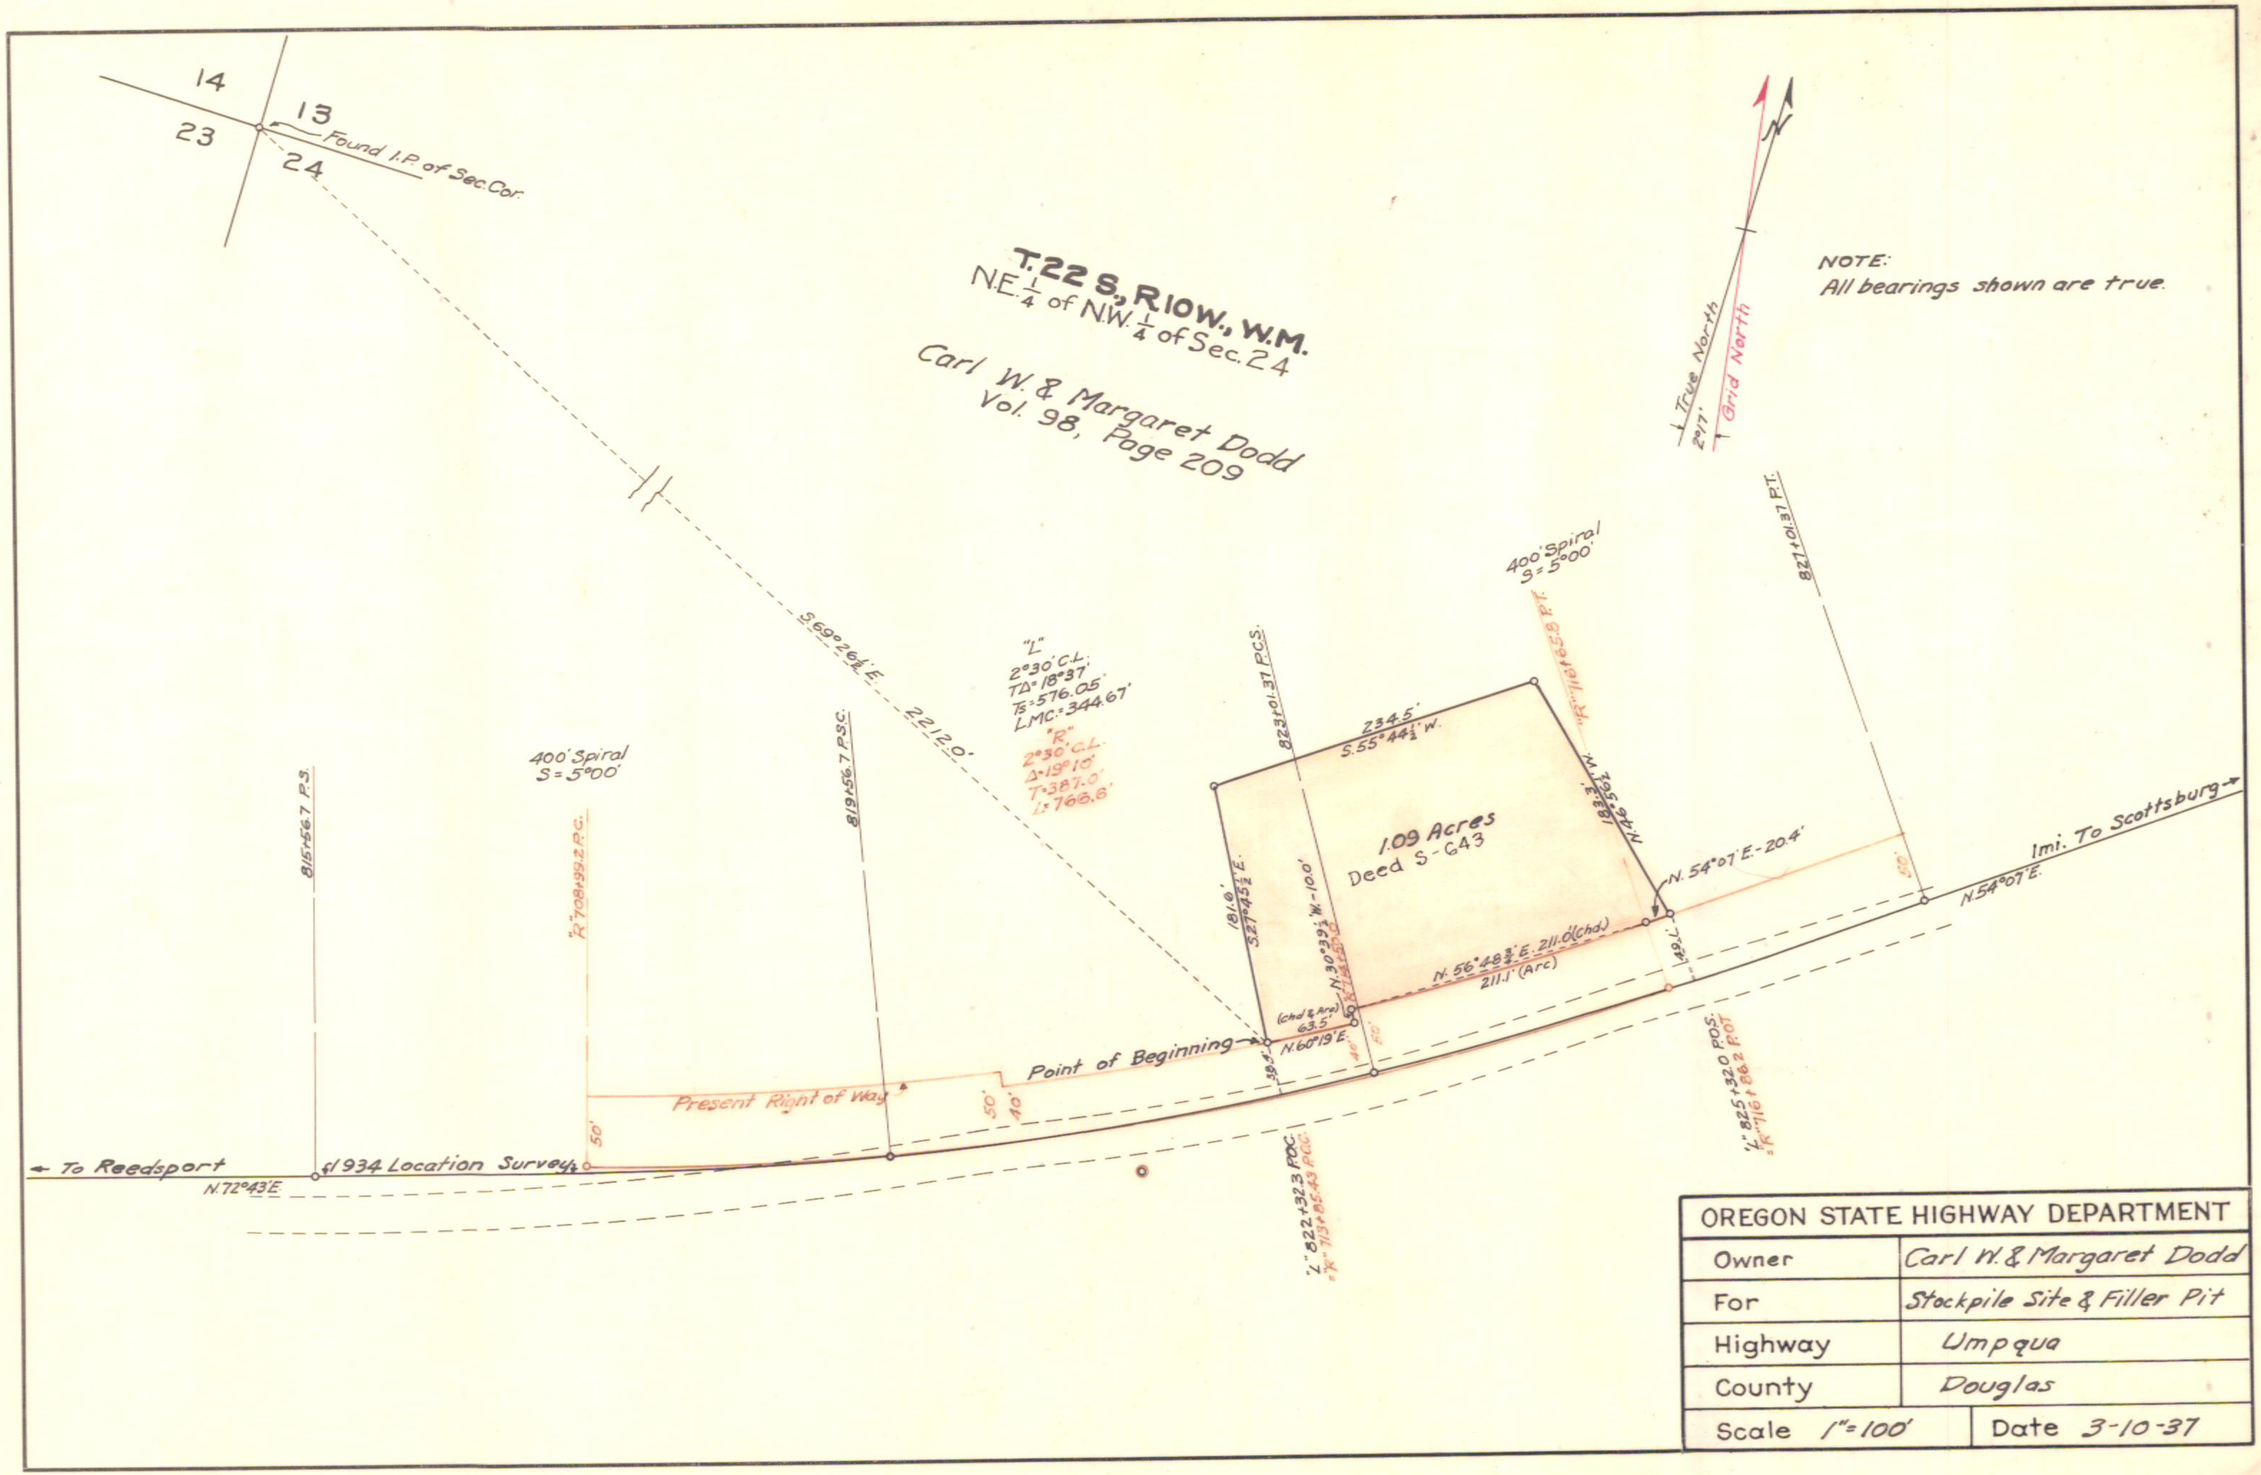

OREGON STATE HIGHWAY DEPARTMENT	
Owner	Carl W. & Margaret Dodd
For	Stockpile Site & Filler Pit
Highway	Umpqua
County	Douglas
Scale 1" = 100'	Date 3-10-37

100' Map 4 B-21-24

(2)