


T. 32 S. R. 5 W., W.M.

19

14158

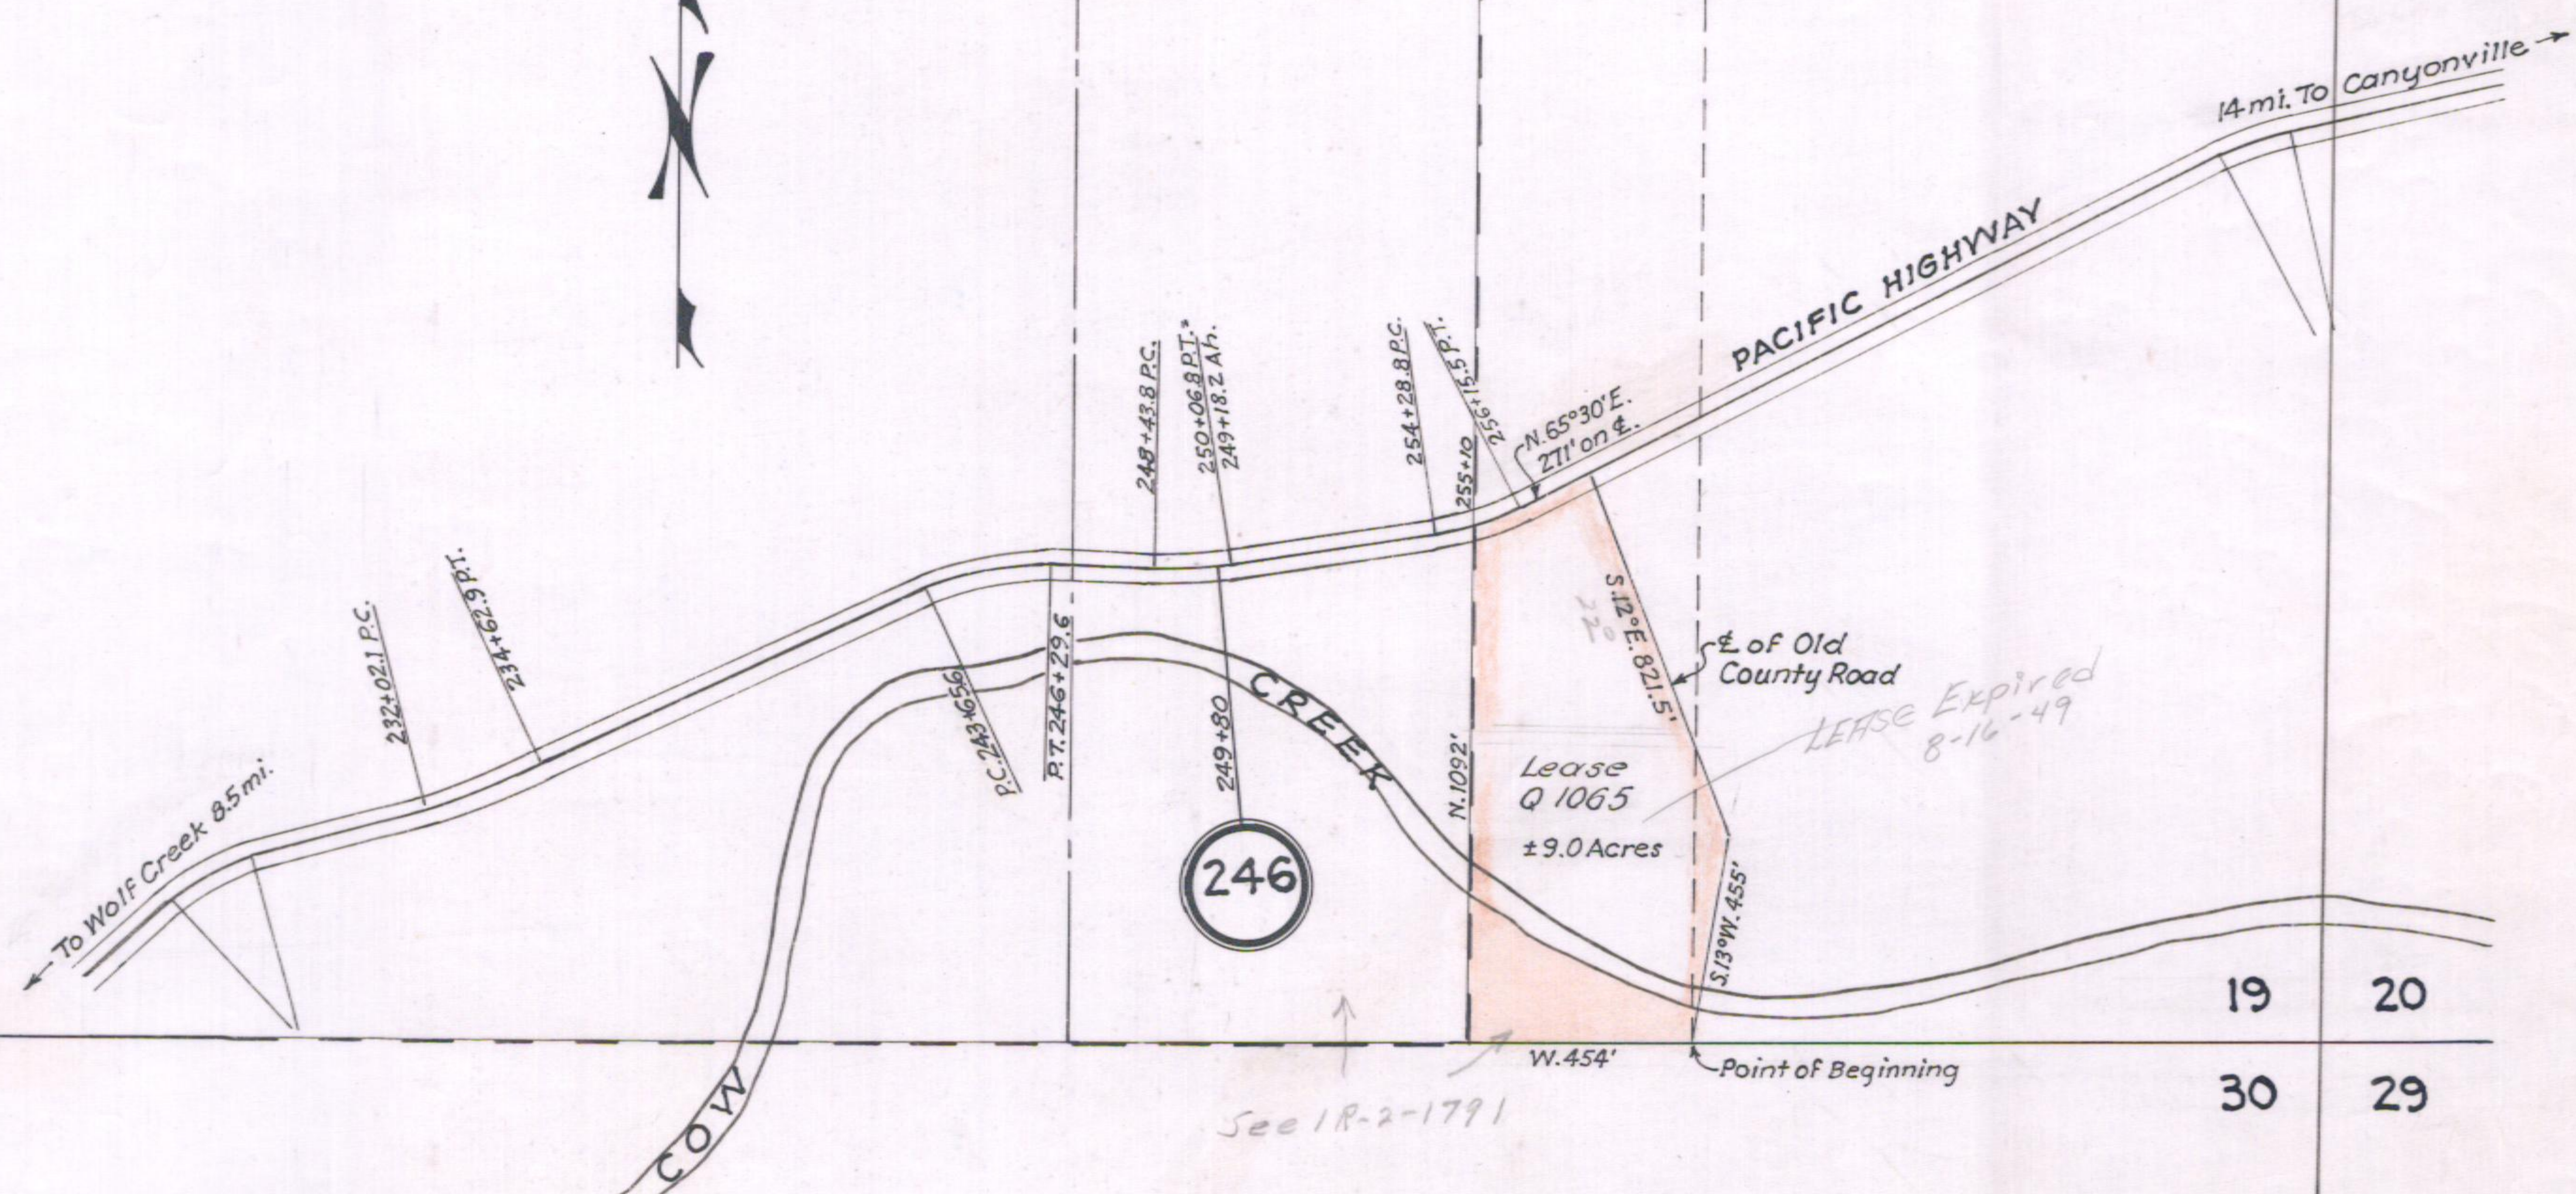

OREGON STATE HIGHWAY DEPARTMENT	
Lease from	Chas. M. Cockrell
For	Gravel Site
Highway	PACIFIC
County	Douglas
Scale: 1" = 400'	Date October, 1947.

9