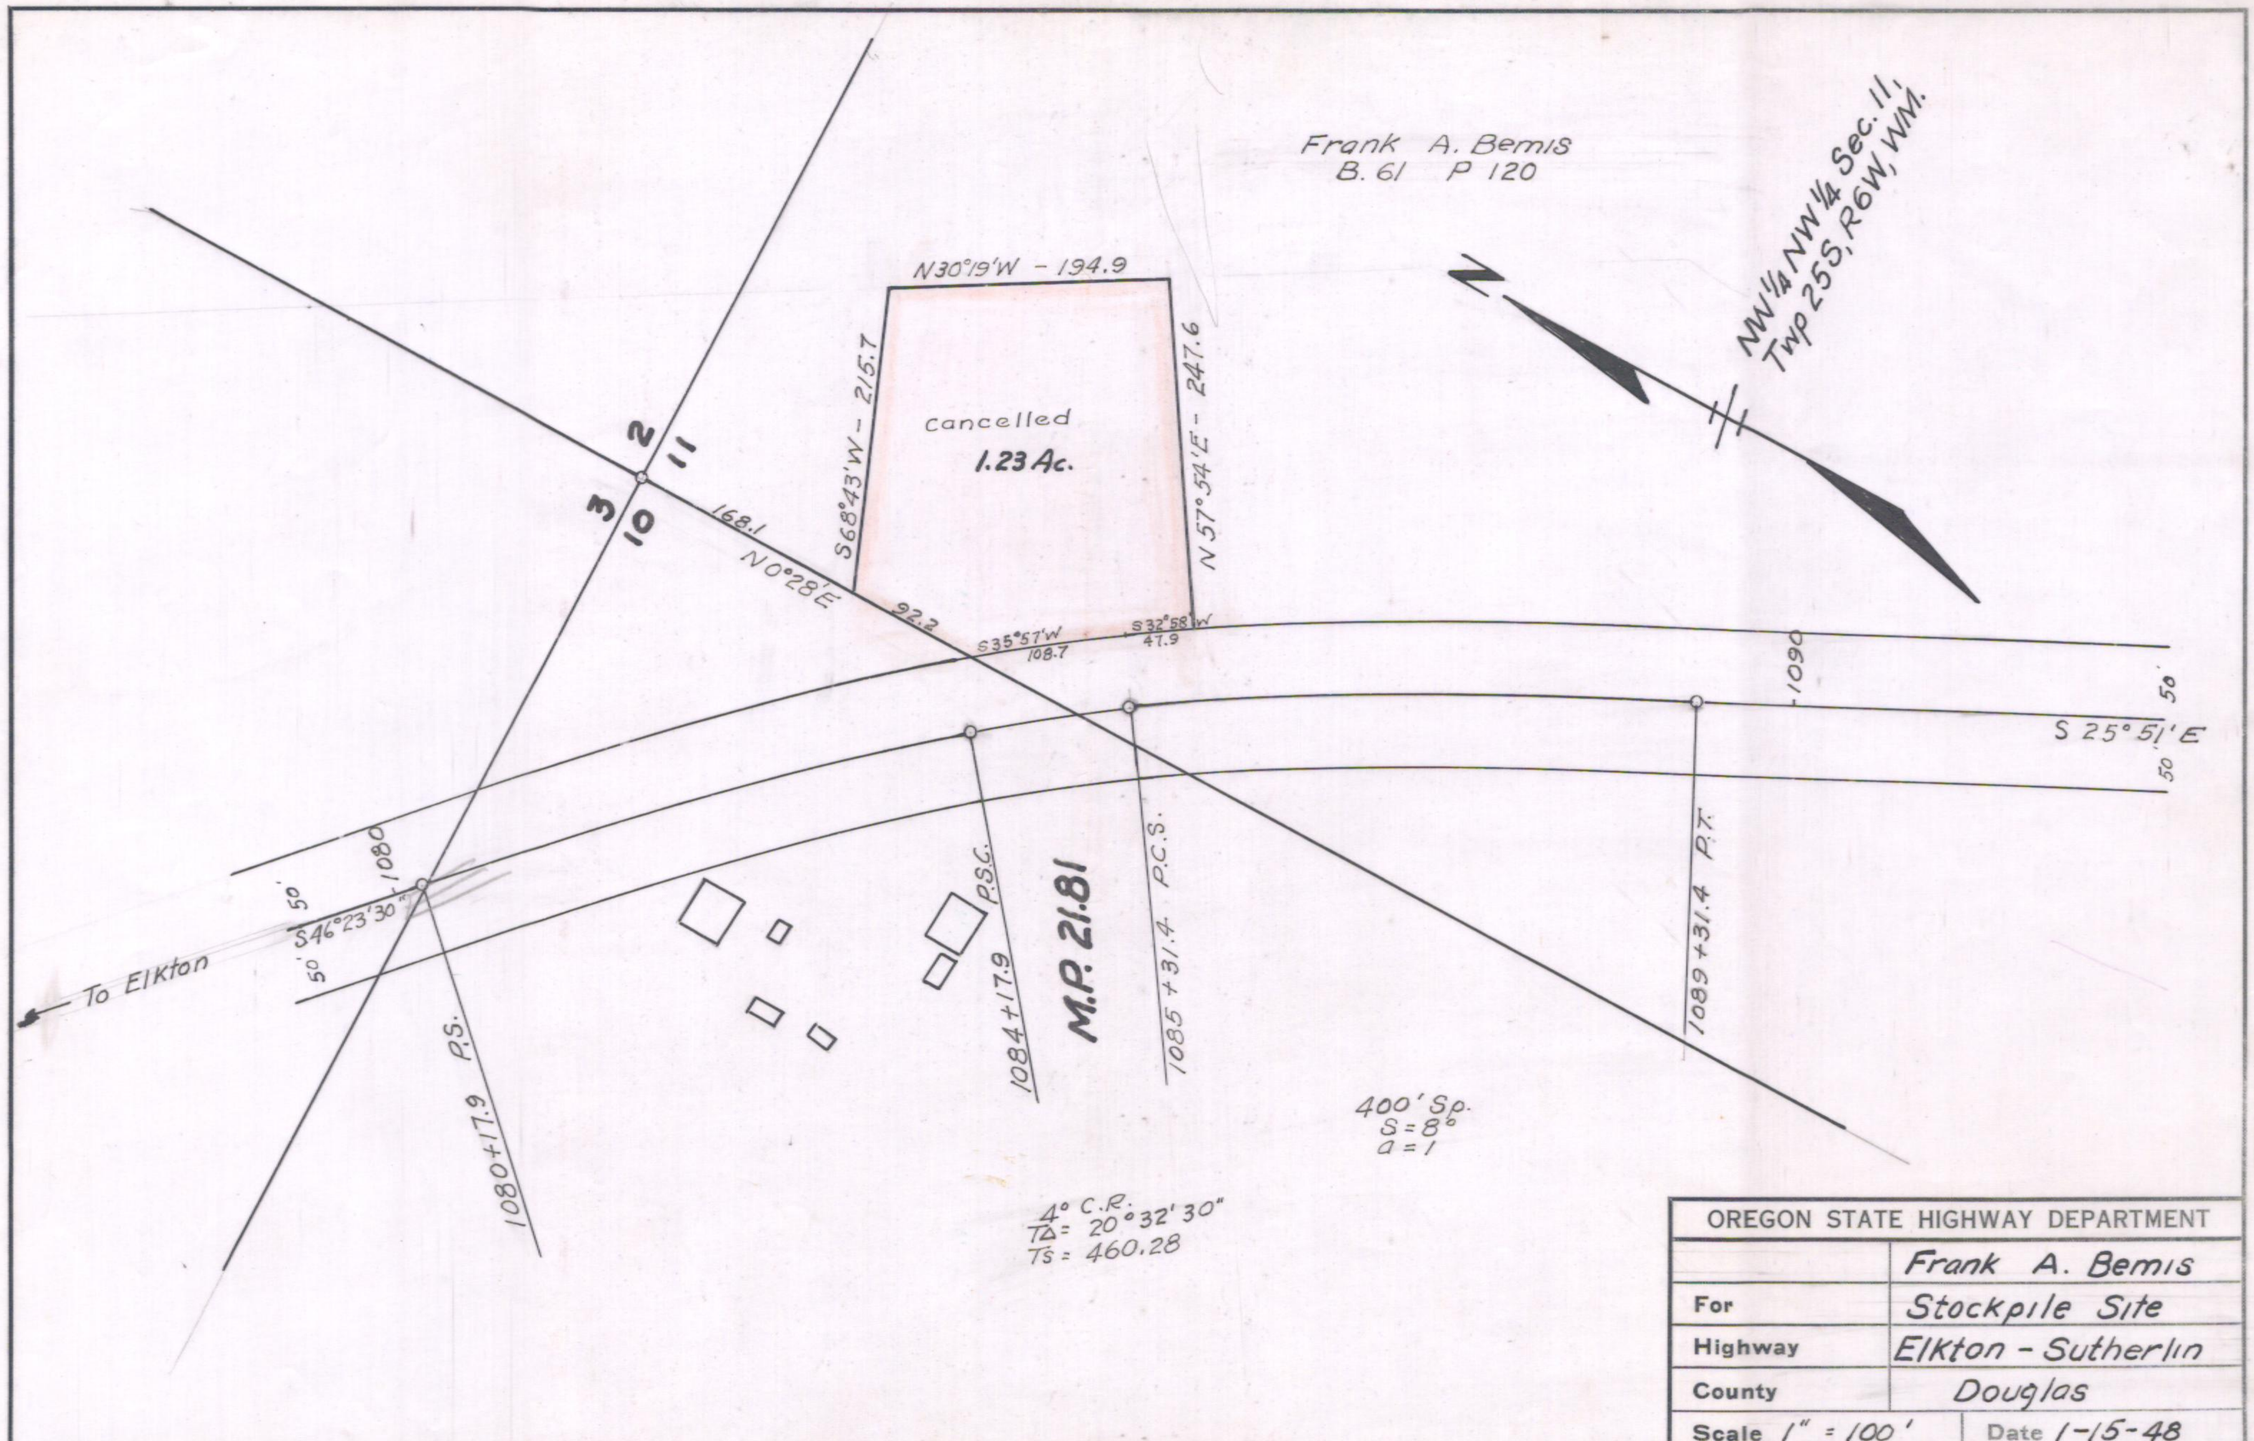

OREGON STATE HIGHWAY DEPARTMENT	
	Frank A. Bemis
For	Stockpile Site
Highway	Elkton - Sutherlin
County	Douglas
Scale 1" = 100'	Date 1-15-48

6B-24-16 - 1"-100'
7B-2-9 - 1"=400'

5