1R-3-800

OREGON STATE HIGHWAY DEPARTMENT

Sketch Map

EAST DIAMOND LAKE HIGHWAY

~~DESCHUTES~~ Douglas AND KLAMATH COUNTIES
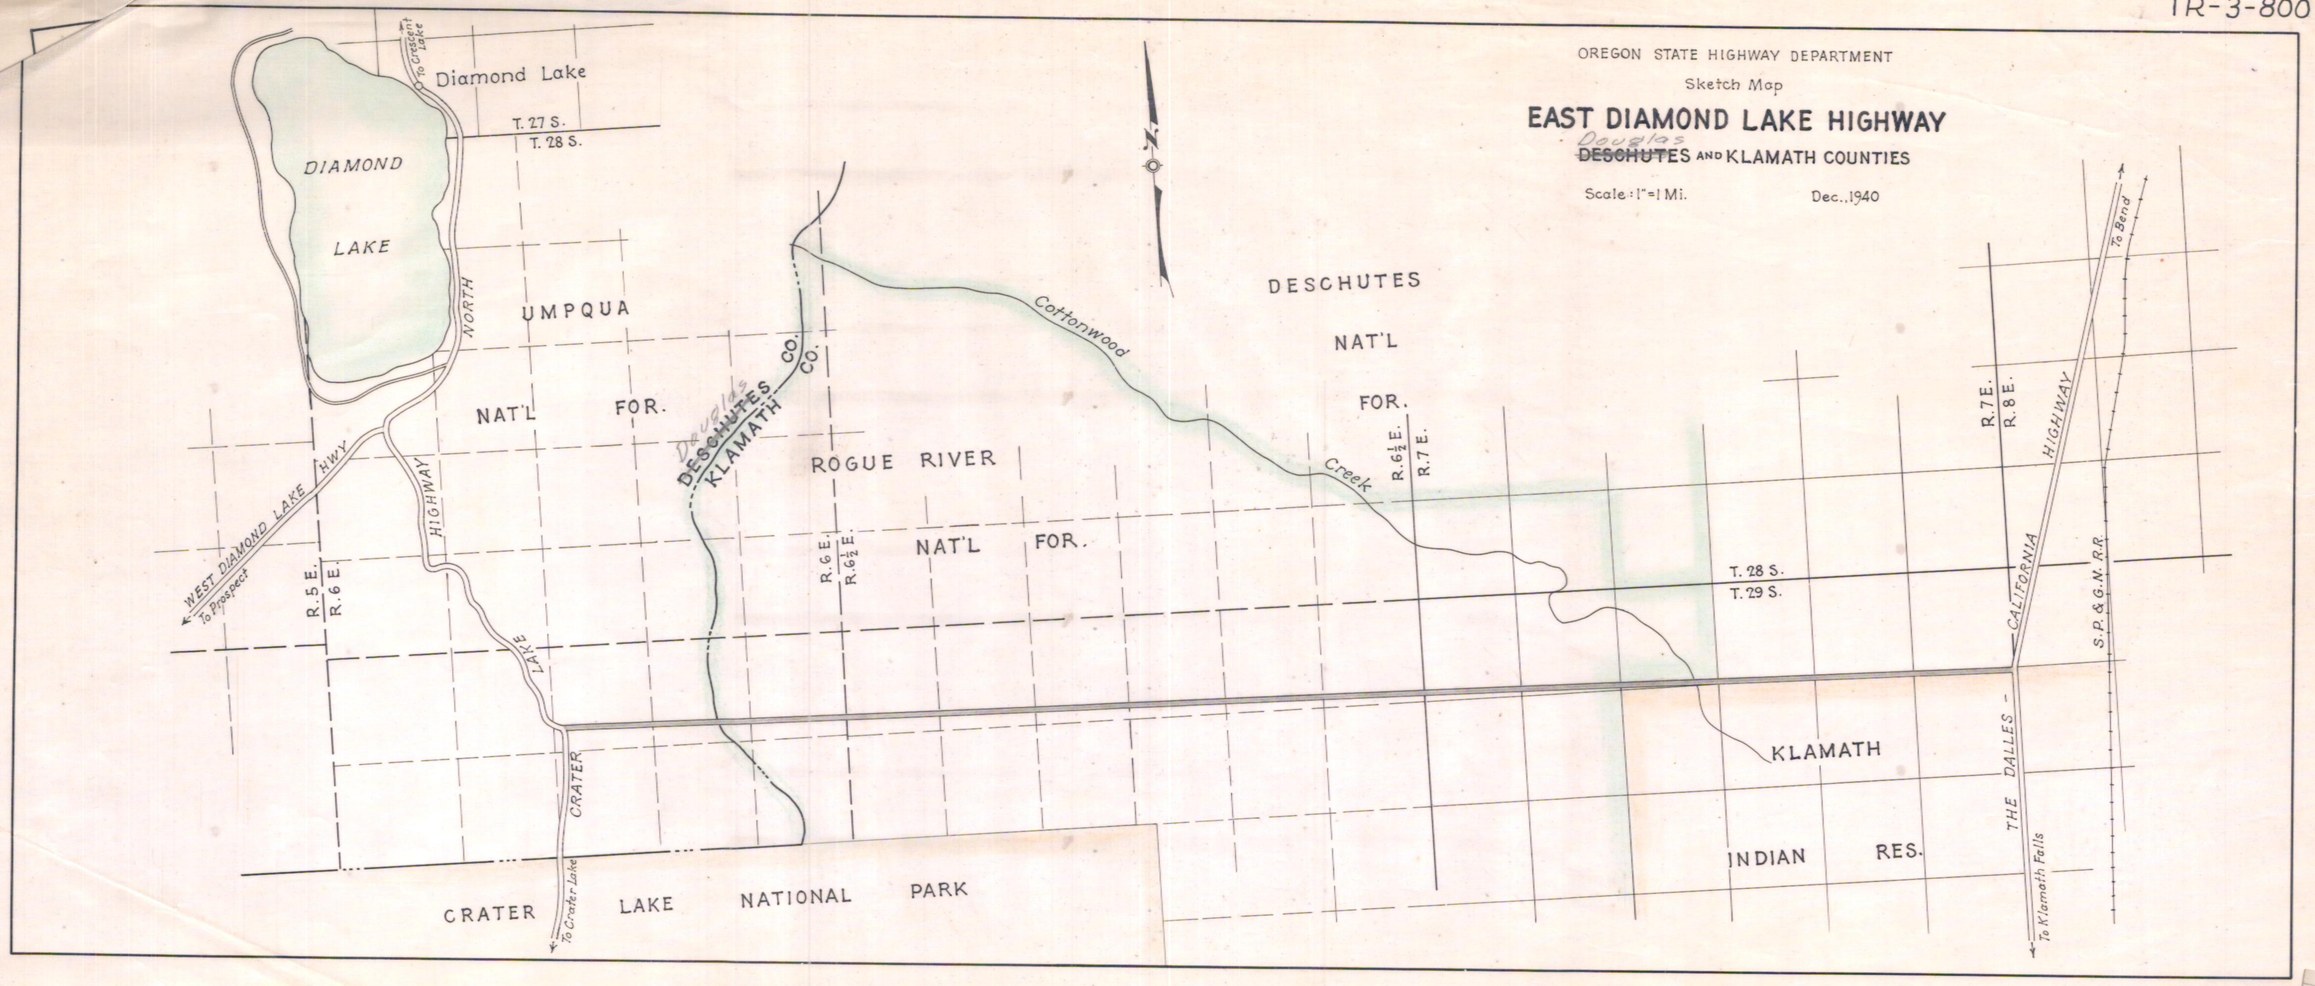
Scale: 1" = 1 Mi. Dec., 1940