IR-3-1218

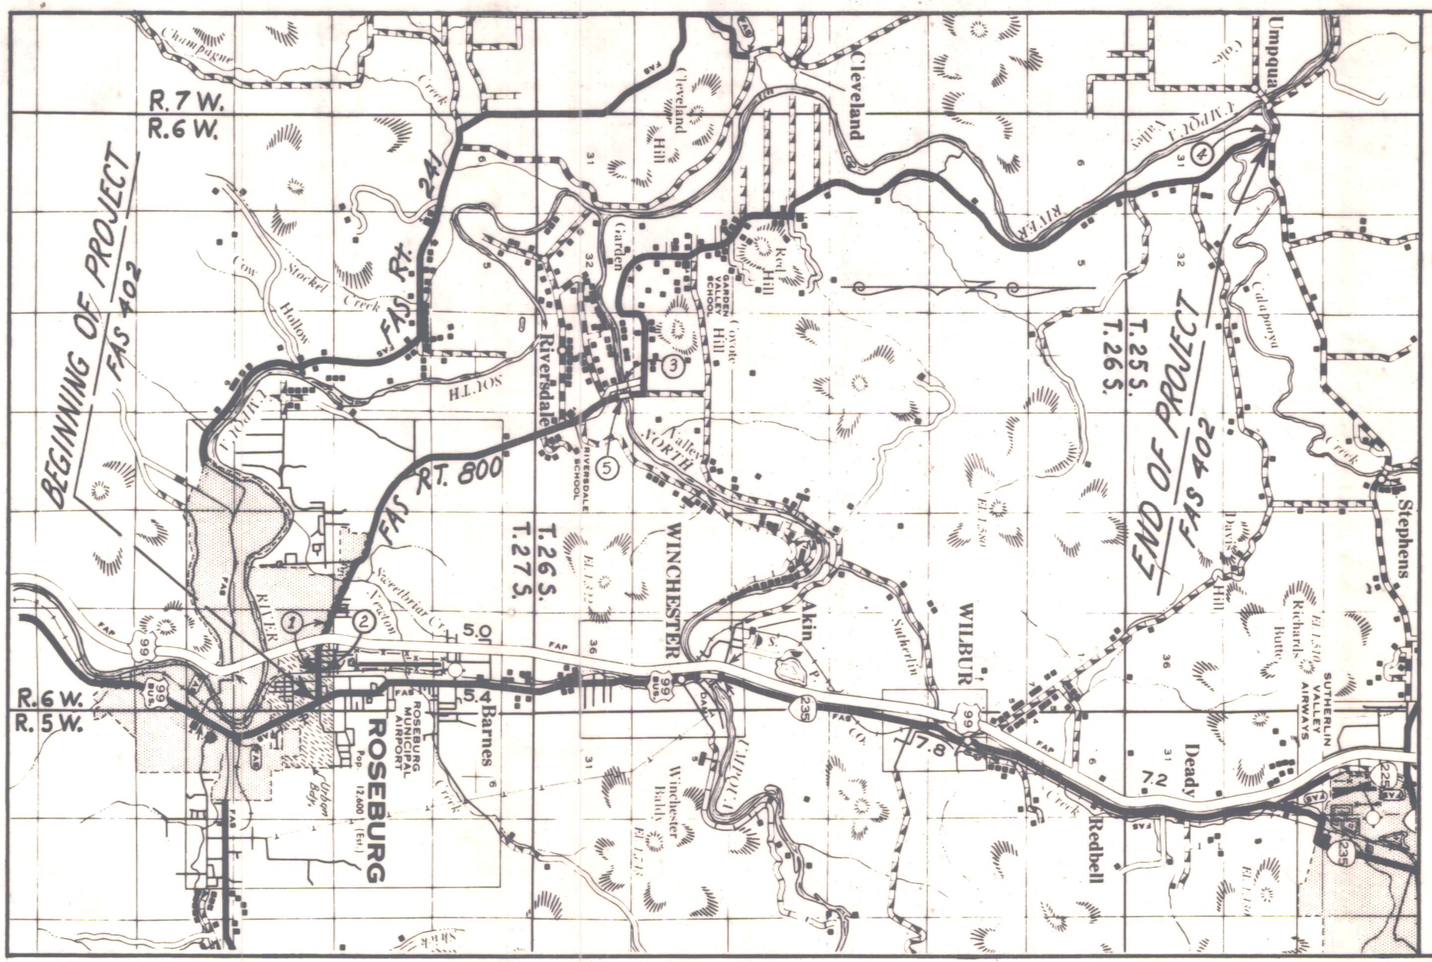

1. GARDEN VALLEY RD. - 60' Wide
2. R.R. CROSSING
   Two Tracks - Auto. Signal, X-Buck
3. ~~BRIDGE NO. 1 (Browns Bridge)~~
   ~~Steel Pony Truss, 410' Long (N. Umpqua River)~~
   ~~H.C. 19'-1"~~
4. BRIDGE NO. 2 (Calapooya Cr.)
   Steel Pony Truss, 165' Long
   H.C. 15'-0"
5. BRIDGE NO. 3 (Browns Bridge)
   72' Pre. Stress (N. Umpqua River)
   110'-140'-110' R.C.D.G. - 3-65' Pre. Stress
   H.C. 30'-0"

OREGON STATE HIGHWAY DEPARTMENT

Sketch Map

GARDEN VALLEY RD. SECTION

DOUGLAS COUNTY

PROJECT NO. FAS 402

Scale 1" = 1 Mile

Aug., 1958
REVISED 6-1965

Length of Project 14.30 Miles