IR-4-54

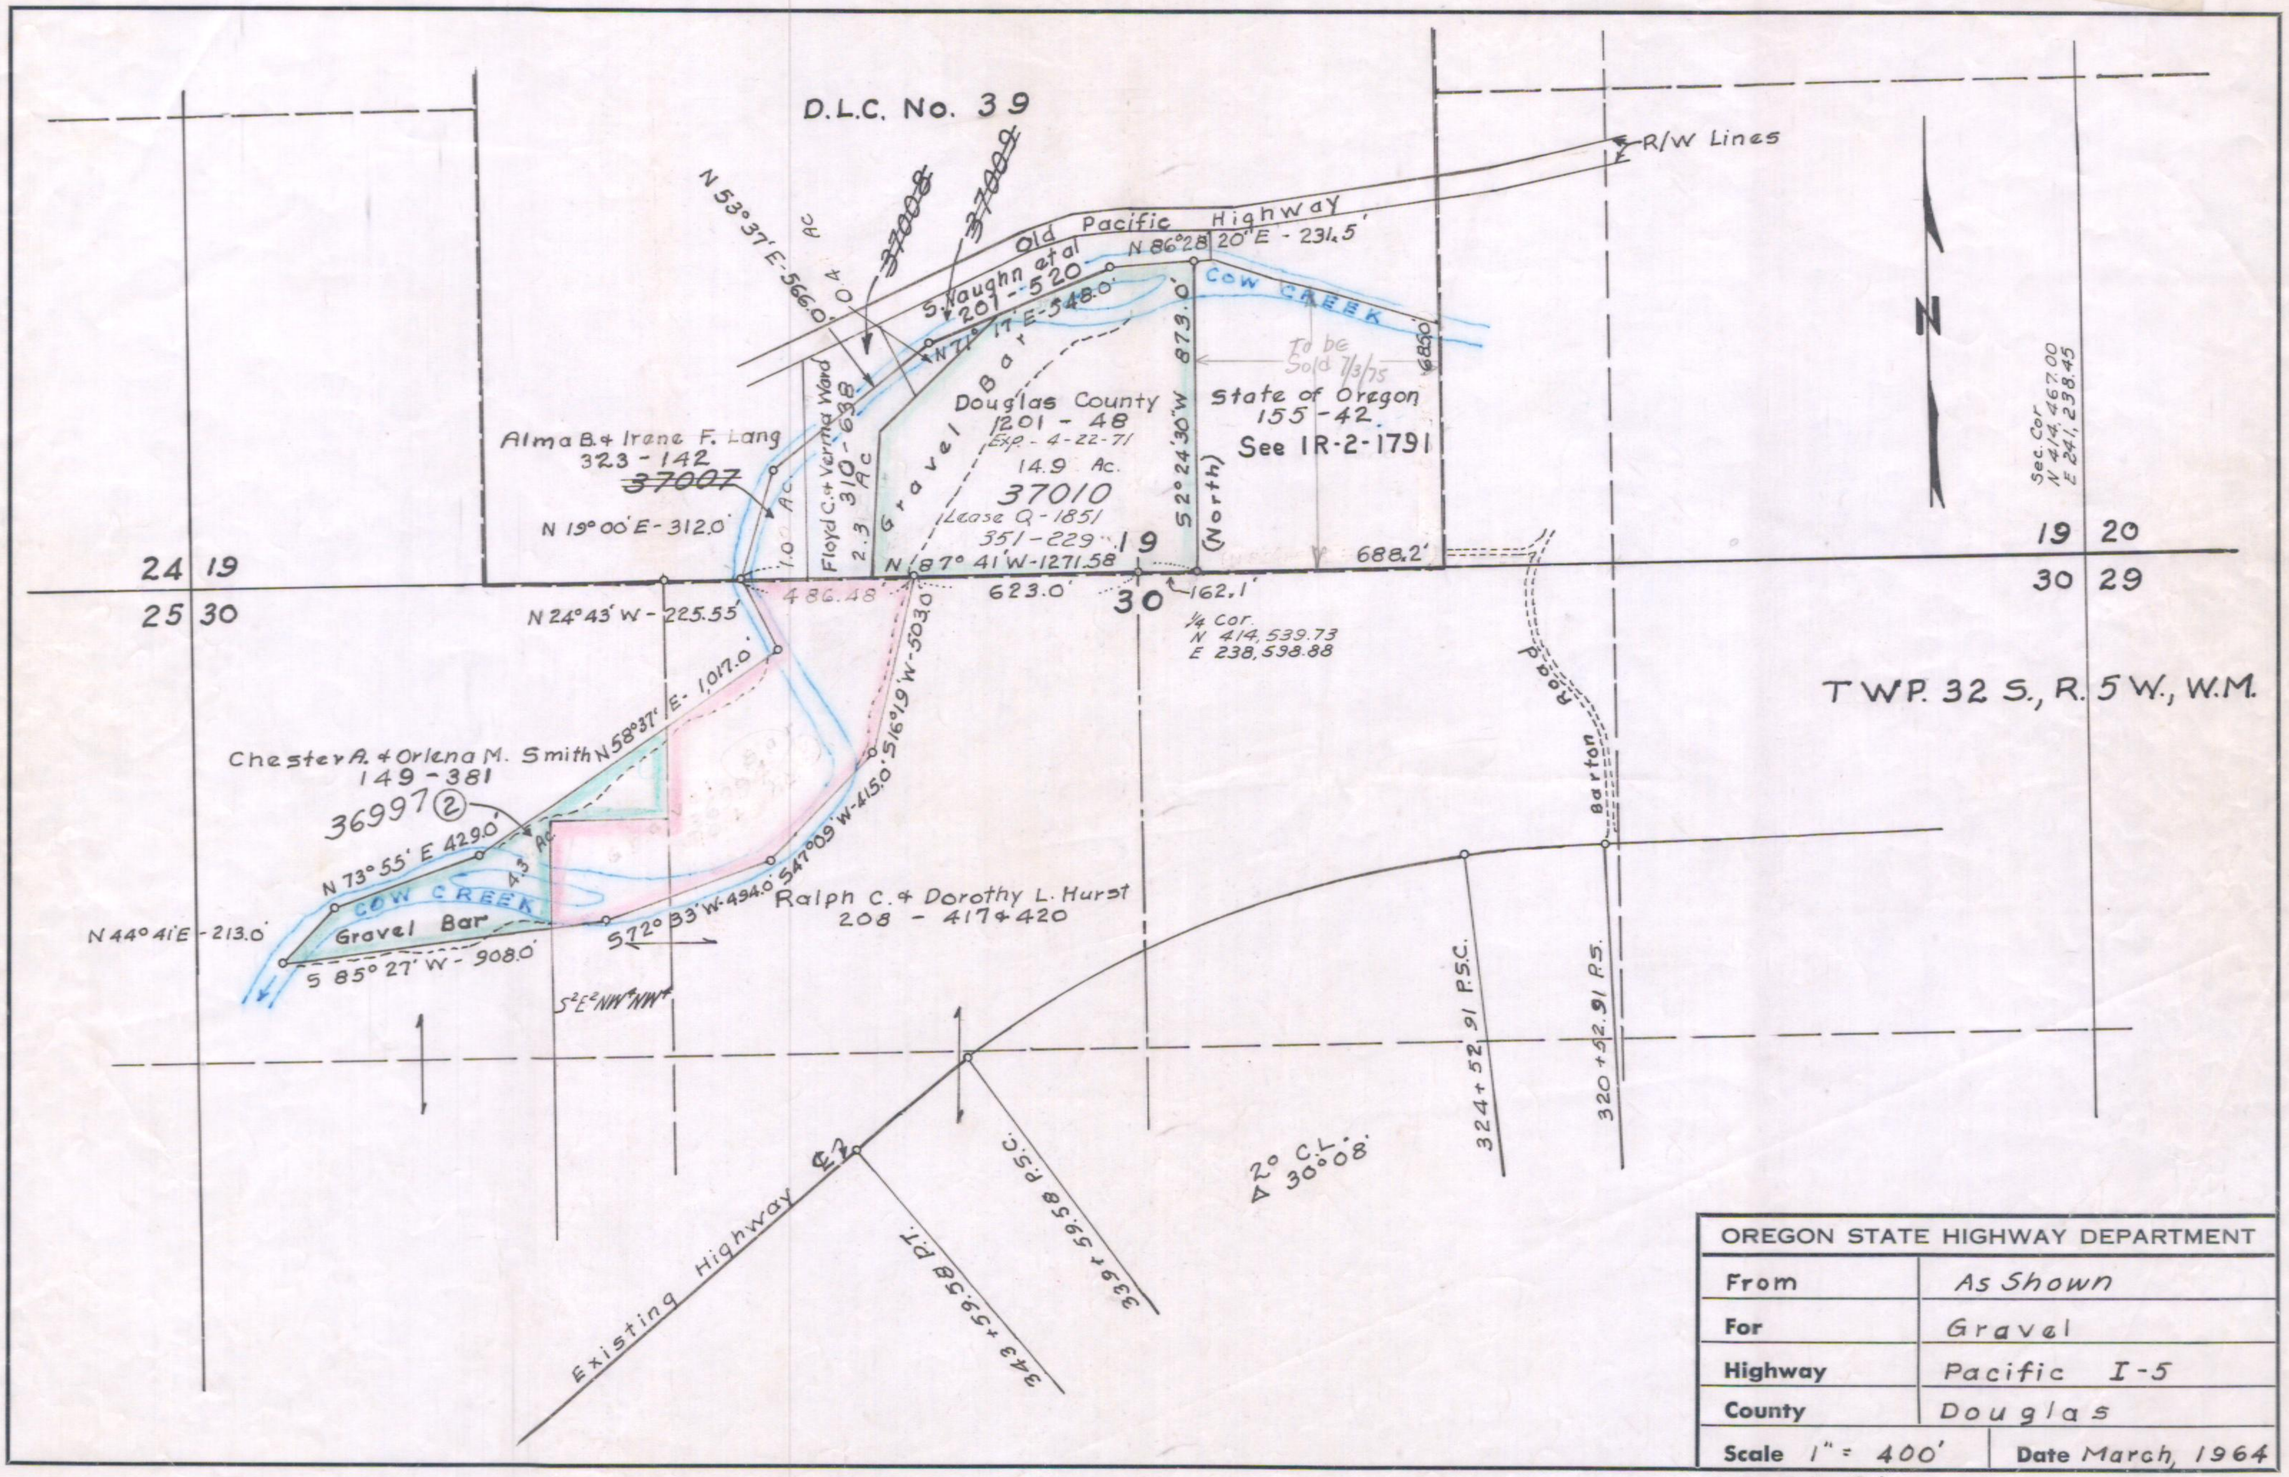

OREGON STATE HIGHWAY DEPARTMENT	
From	As Shown
For	Gravel
Highway	Pacific I-5
County	Douglas
Scale 1" = 400'	Date March, 1964

8B-30-21
6B-11-15

DIETZGEN 131 ARKWRIGHT