This supersedes
1R-5-199 dated
Nov. 1951

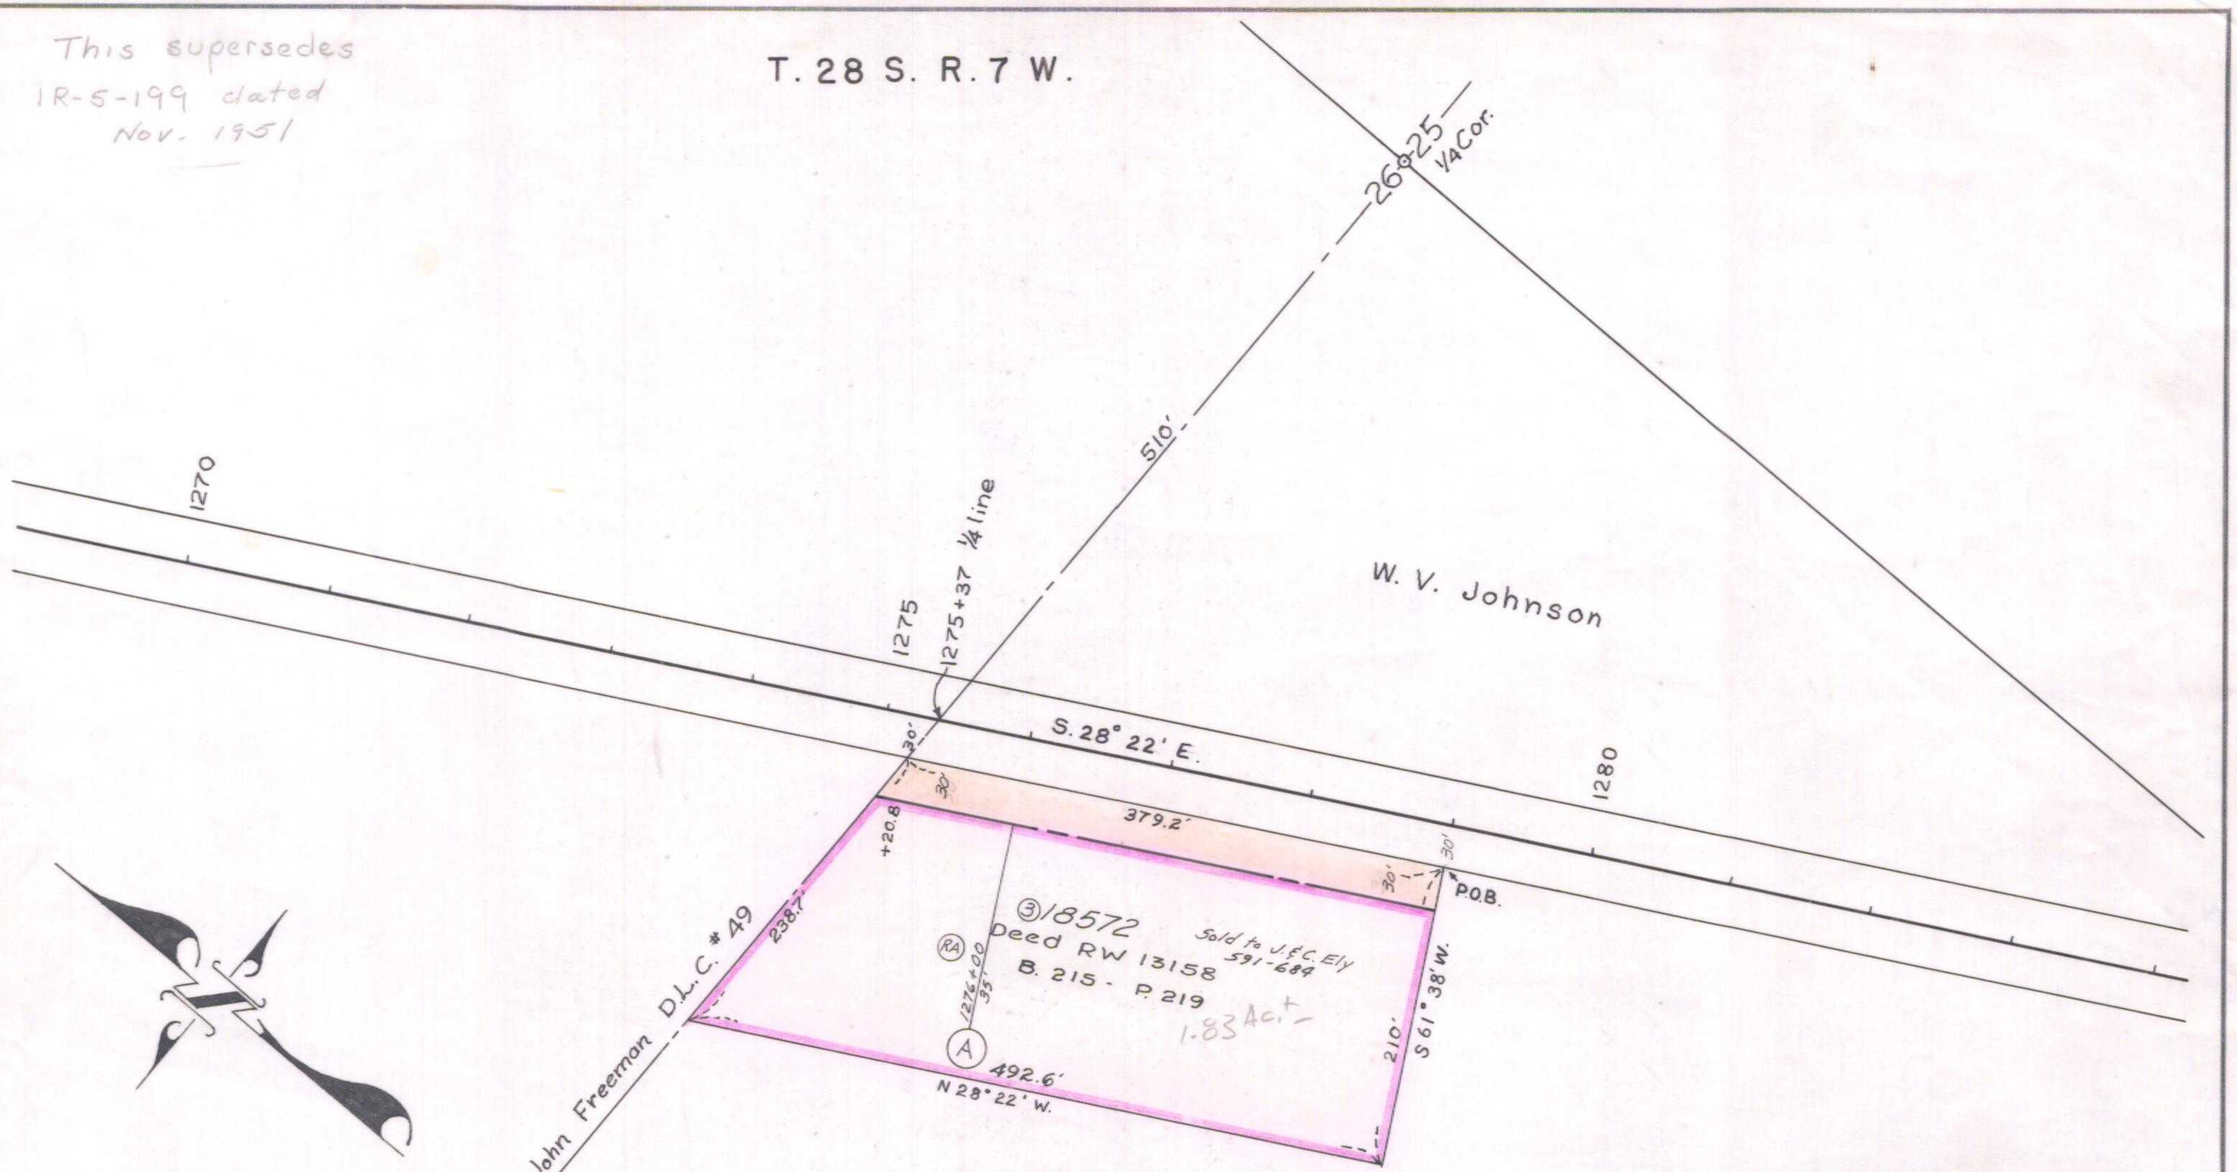

OREGON STATE HIGHWAY DEPARTMENT	
To Be Aquired From	W.V. Johnson
For	Stockpile Site
Highway	Coos Bay – Roseburg
County	Douglas
Scale 1" = 100'	Date 8 - 1 - 52

See Also 6B-28-22 (1"=100')
3B-12-8 (1"=400')

ARKWRIGHT TRACING CLOTH E. D. CO. KILHAM STATY CO. NO. 131K